




DURABLE 100 MM WHITE LINE
 I+260 LT ~ I+380 LT: EDGE LINE (3.3m LT)
 I+260 RT ~ I+380 RT: EDGE LINE (3.3m RT)

DURABLE 100 MM YELLOW LINE
 I+260 C ~ I+380 C: SOLID DOUBLE LINE

TEMPORARY 100 MM WHITE LINE
 I+260 LT ~ I+380 LT: EDGE LINE (3.3m LT)
 I+260 RT ~ I+380 RT: EDGE LINE (3.3m RT)

TEMPORARY 100 MM YELLOW LINE
 I+260 C ~ I+380 C: SOLID DOUBLE LINE

REMOVING SIGNS
 2 EACH

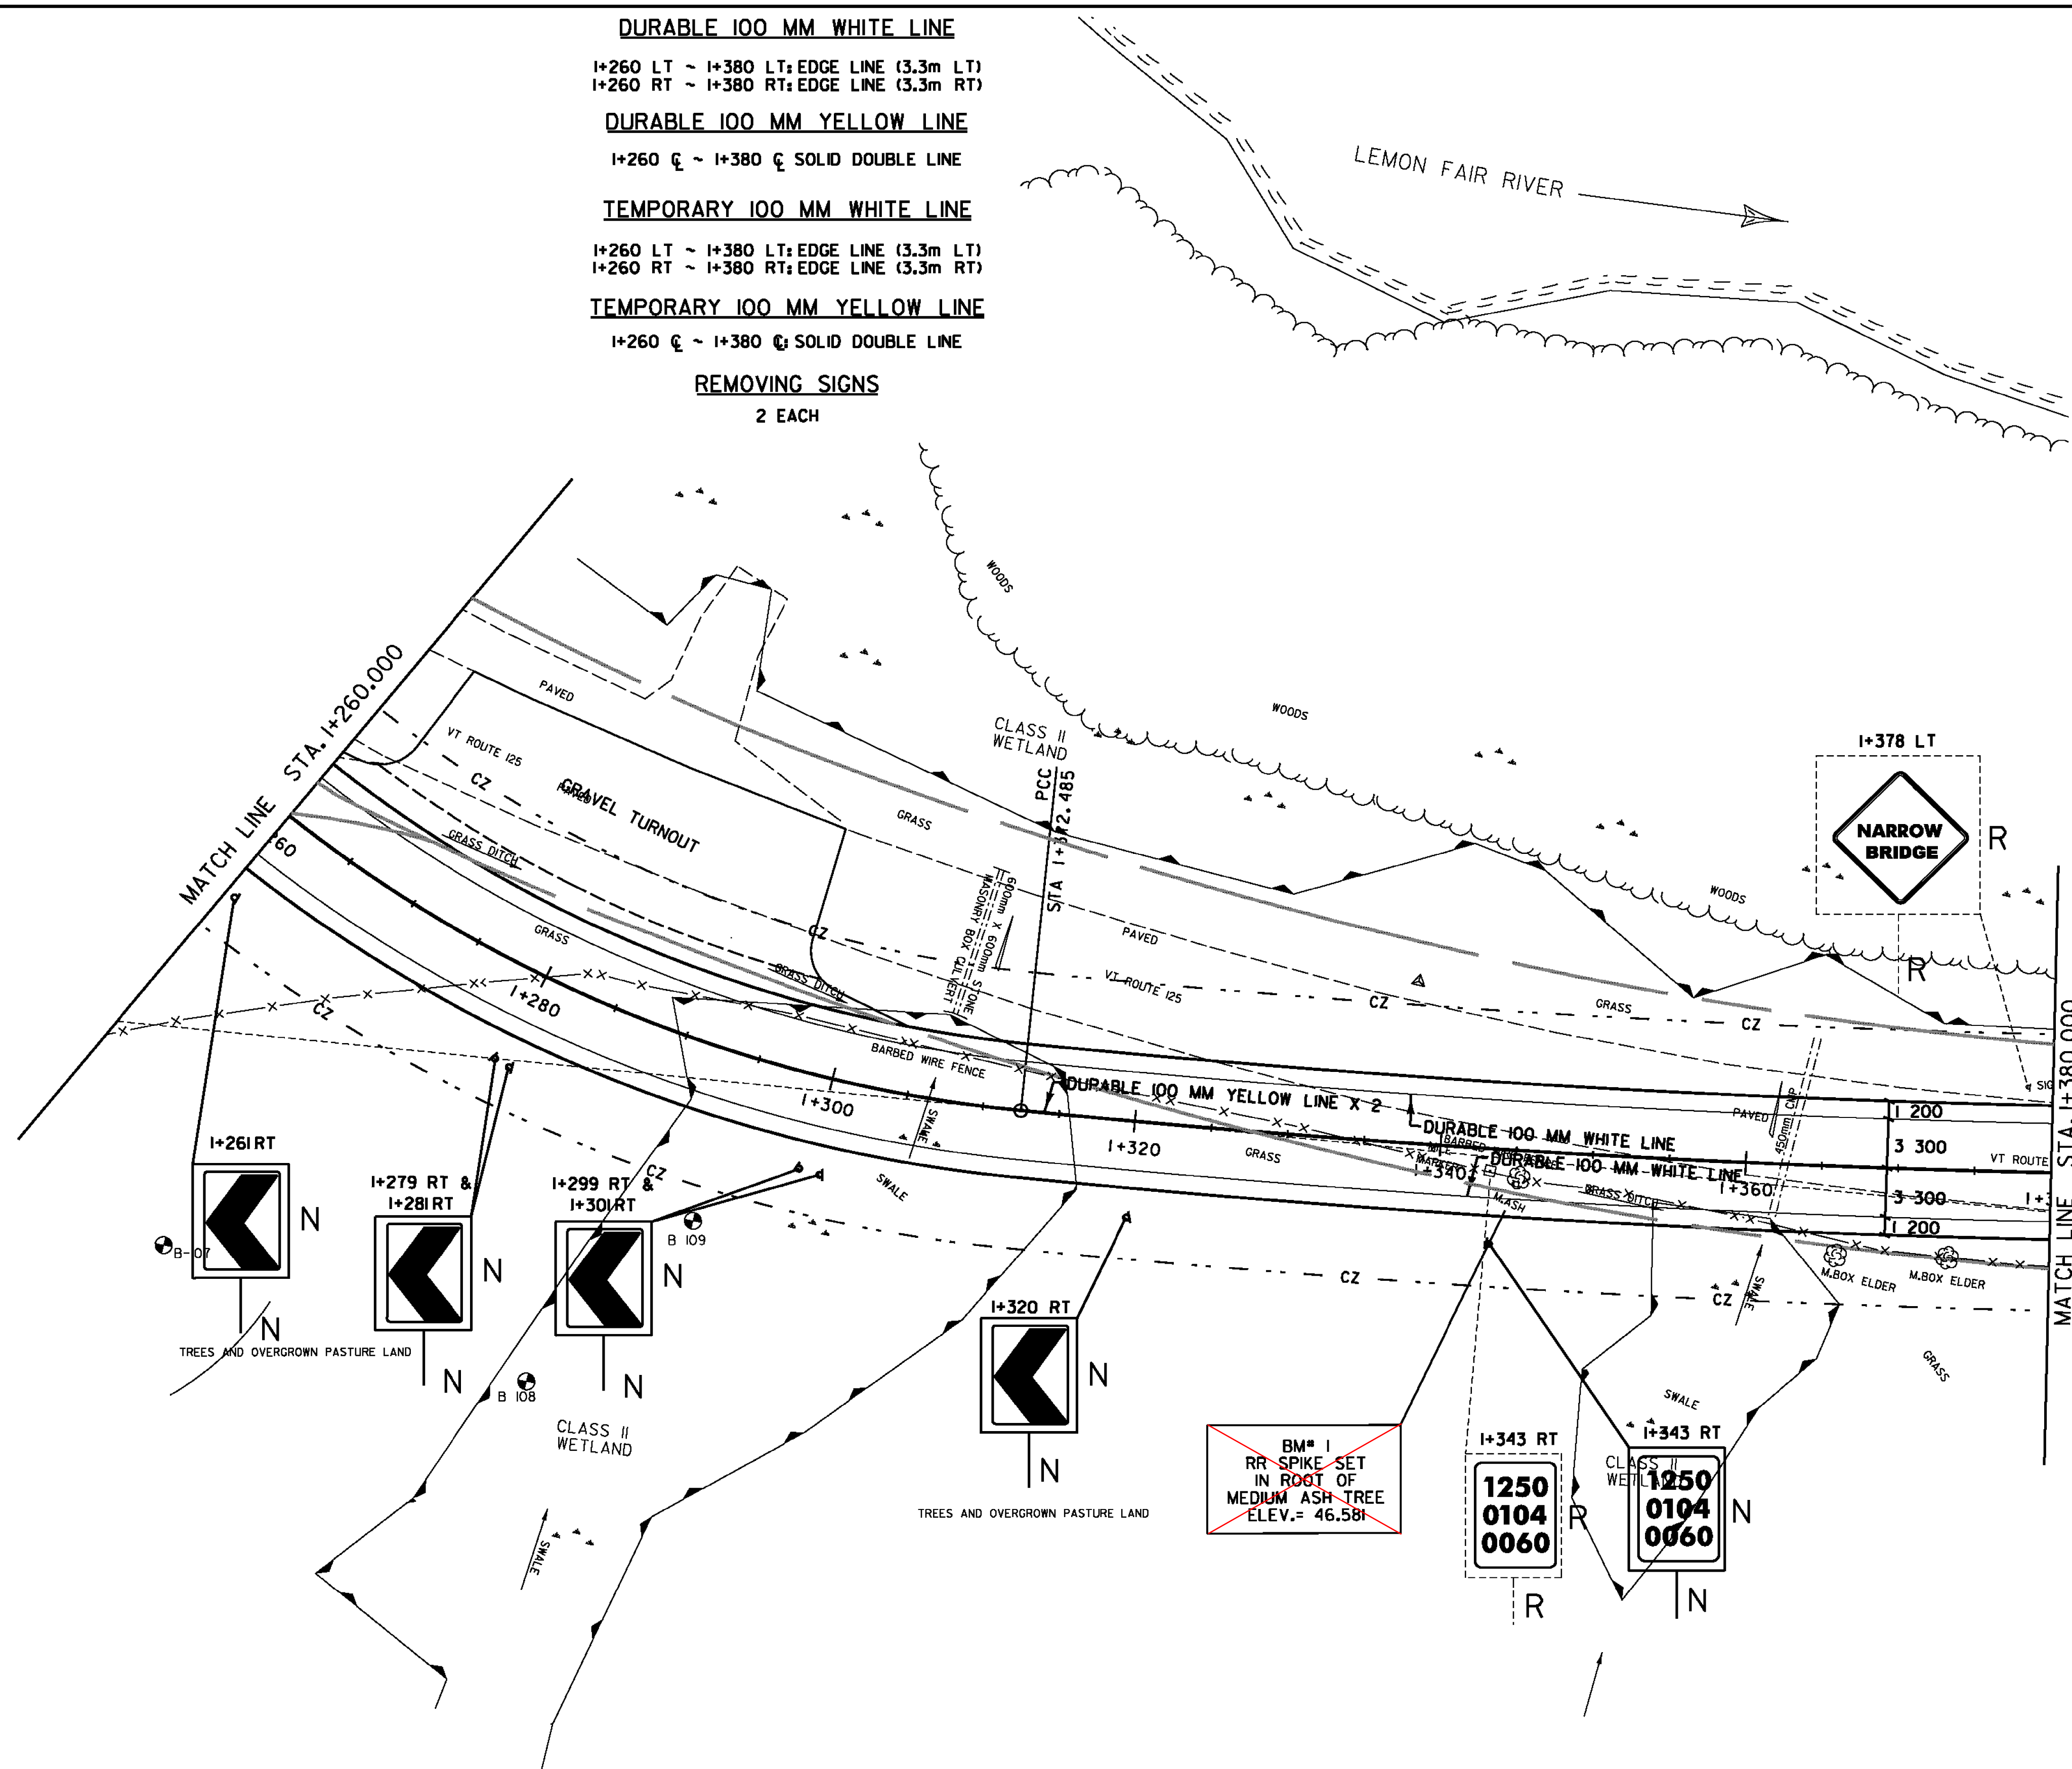

SIGN LEGEND

- = EXISTING SIGN
- = NEW SIGN
- R = REMOVE
- N = NEW

DATUM
 VERTICAL NAVD 88
 HORIZONTAL NAD 83(92)



PROJECT: CORNWALL	PROJECT NO.: BRS 0172(6)
DESIGN FILE NAME: z85e042+sbdr.dgn	PLOT DATE: 3/15/2010
IPARM FILE NAME:	SURVEY DATE: 1996&1999
SURVEYED BY: VTRANS & VT SURVEY	DRAWN BY: ERIK ATKINS
SQUAD LEADER: MARTHA EVANS-MONGEON	SHEET: 59 OF 144
PVMT MARKINGS AND SIGNS LAYOUT SHEET 3	