




WINGWALL NO. 1 TYPICAL SECTION
SCALE: 1:25

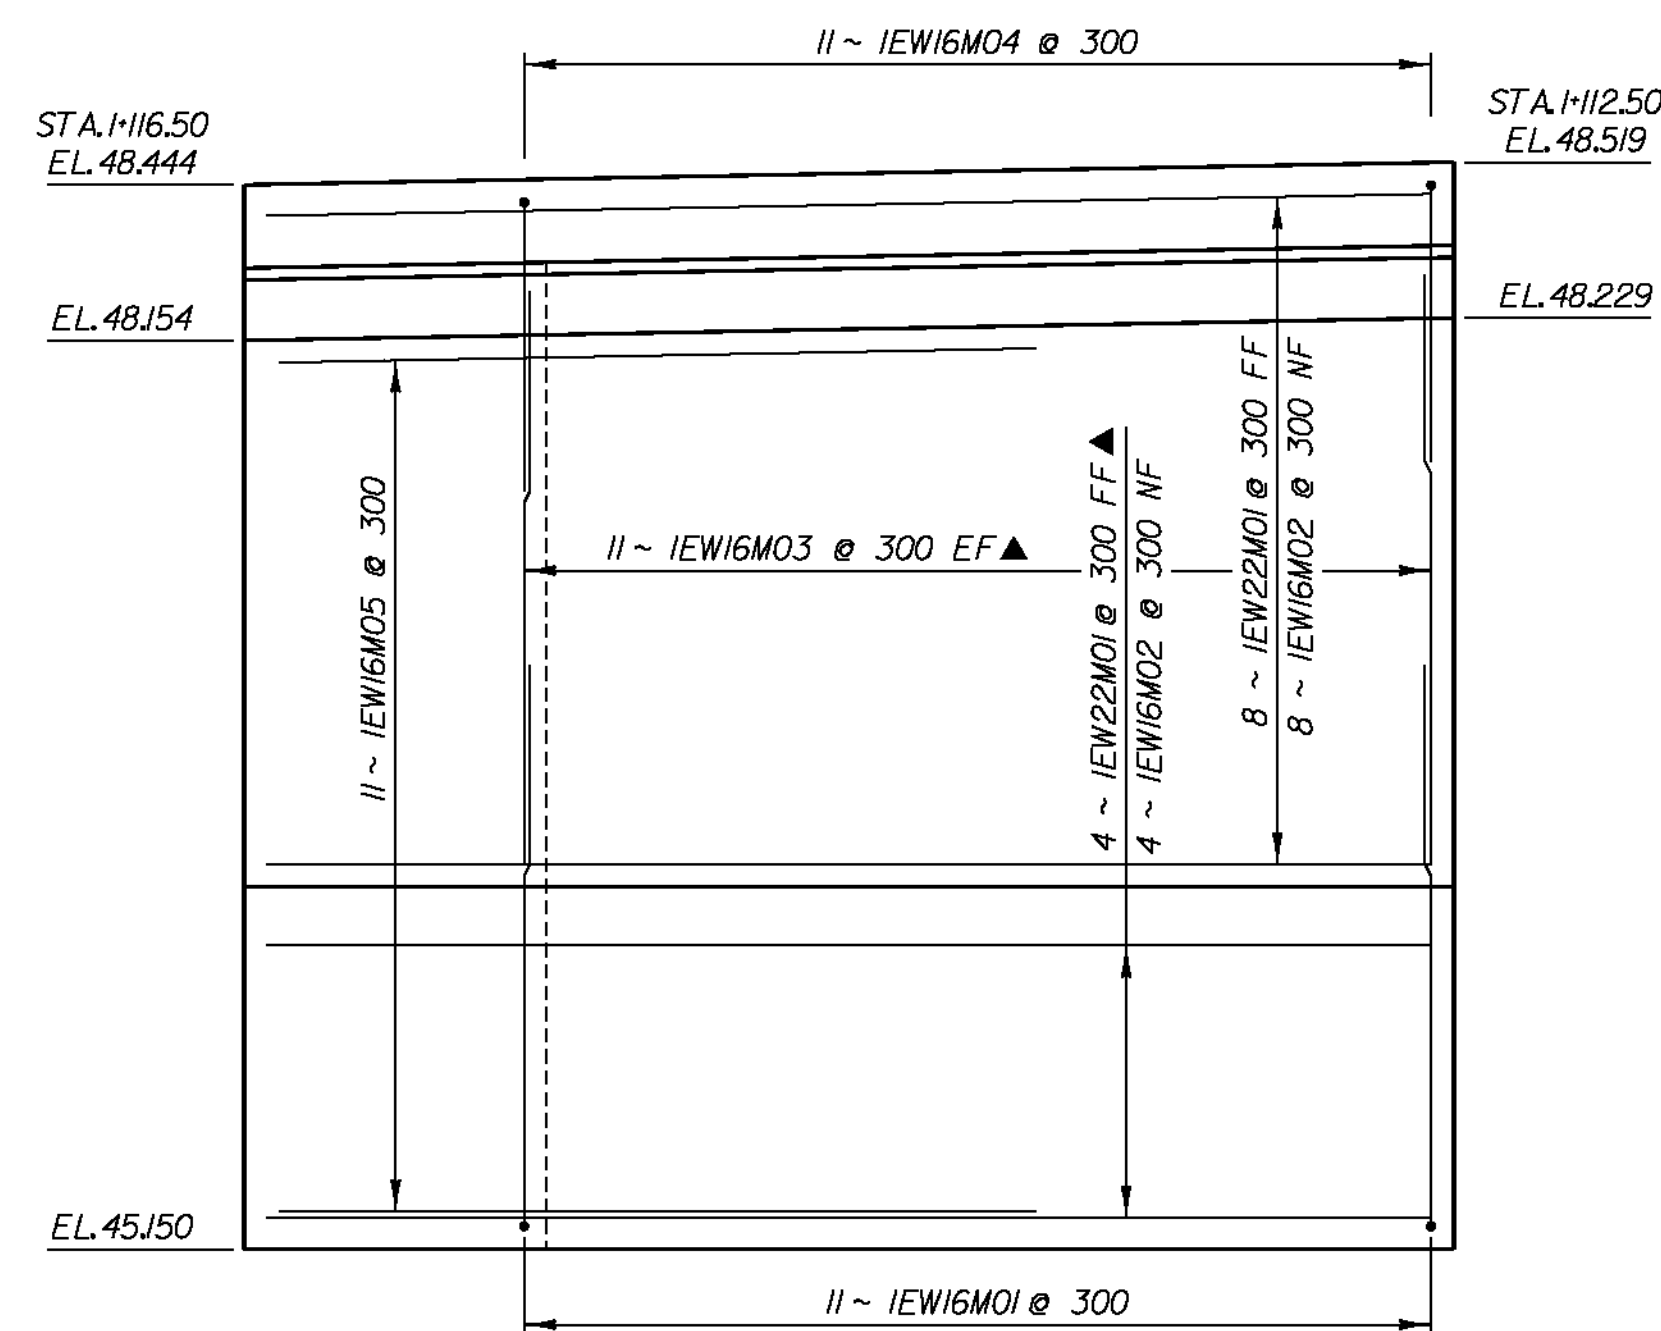


WINGWALL NO. 1 ELEVATION
SCALE: 1:25

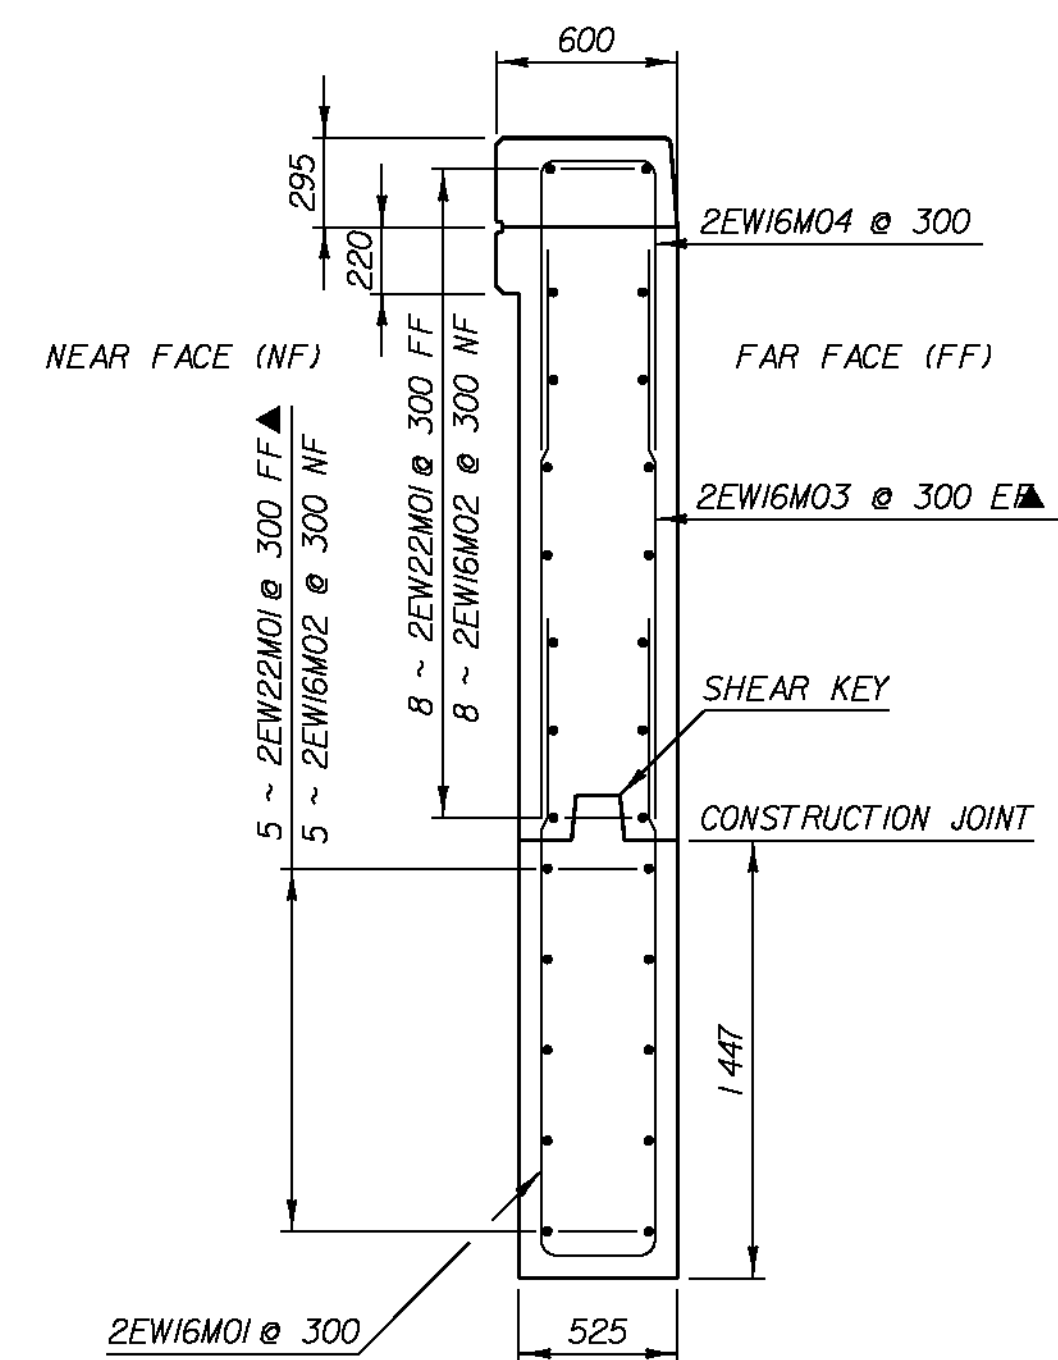


WINGWALL NO. 2 TYPICAL SECTION
SCALE: 1:25

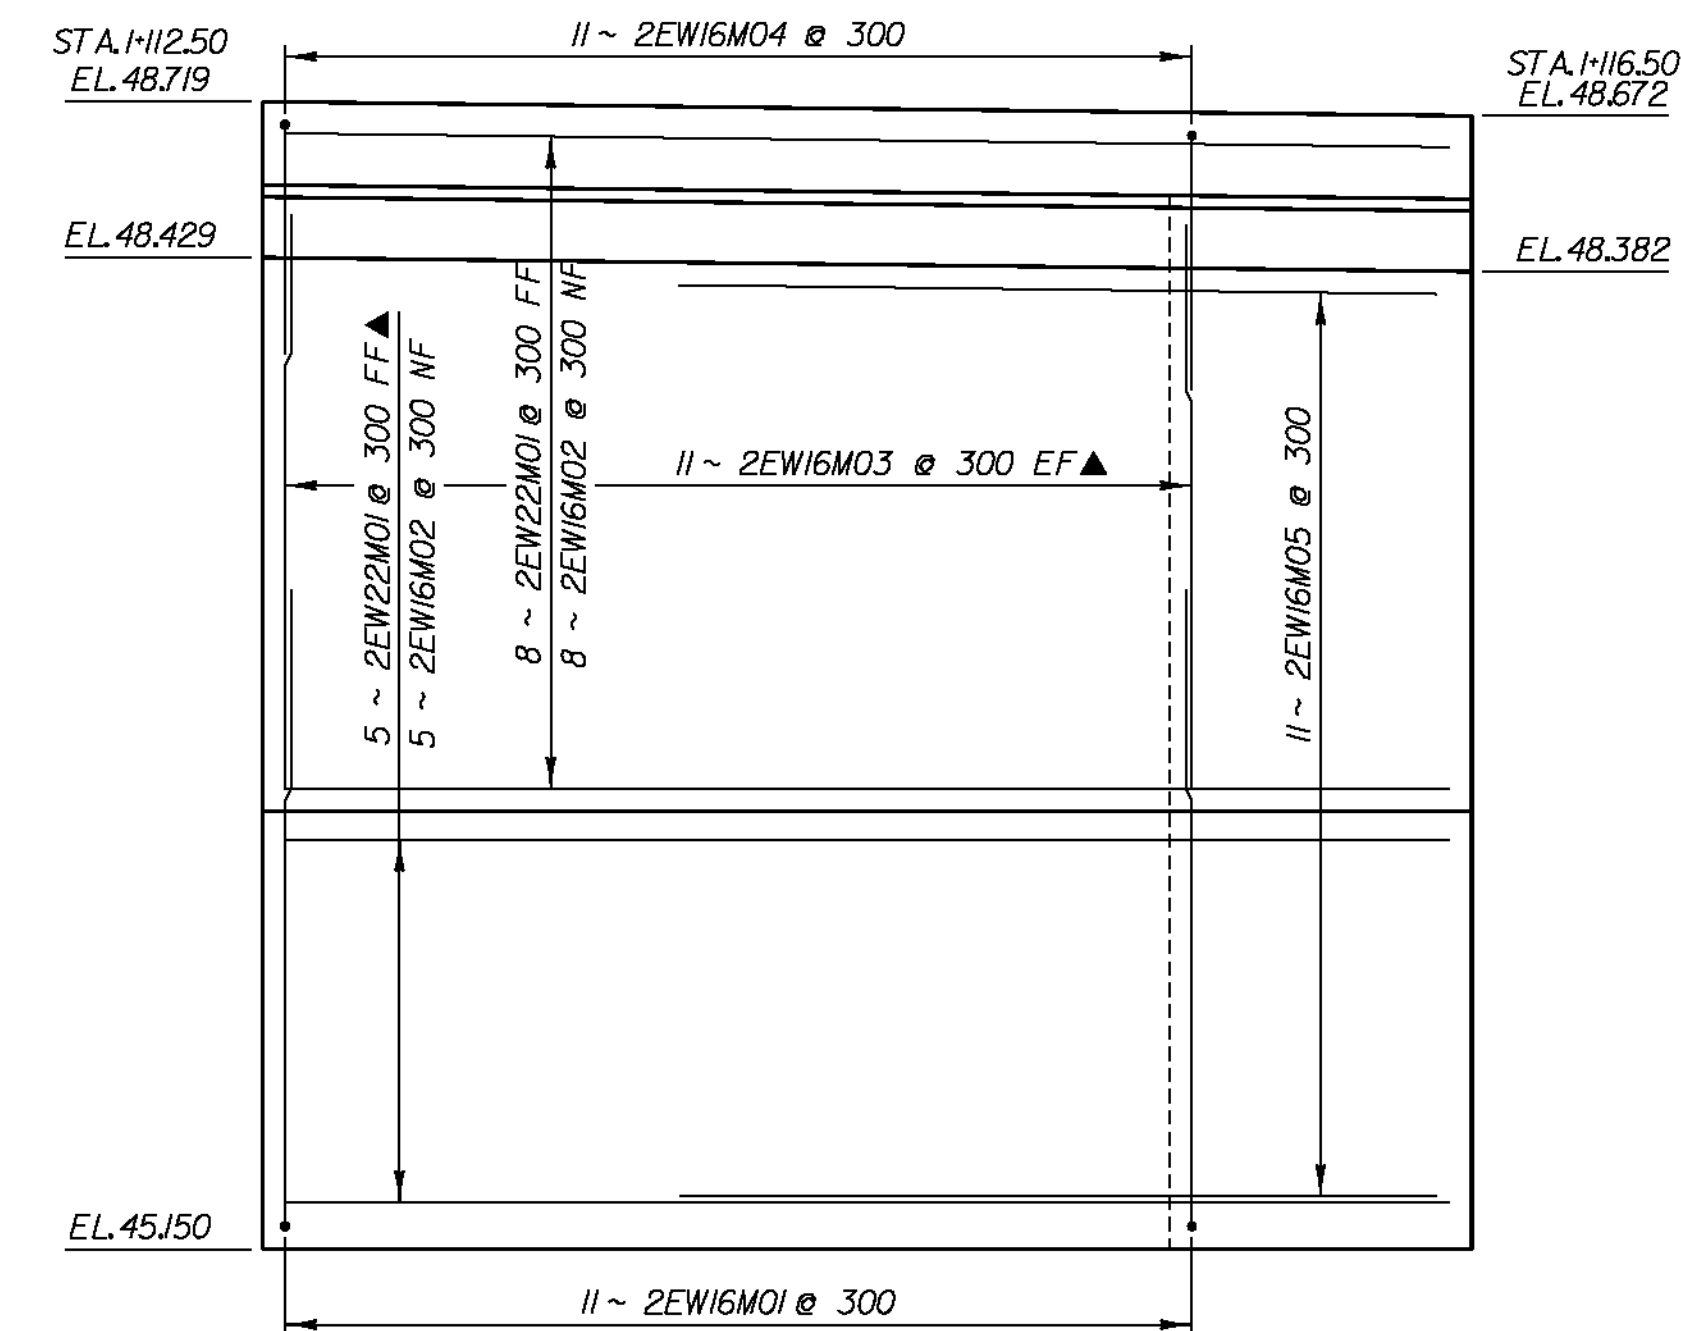


WINGWALL NO. 2 ELEVATION
SCALE: 1:25

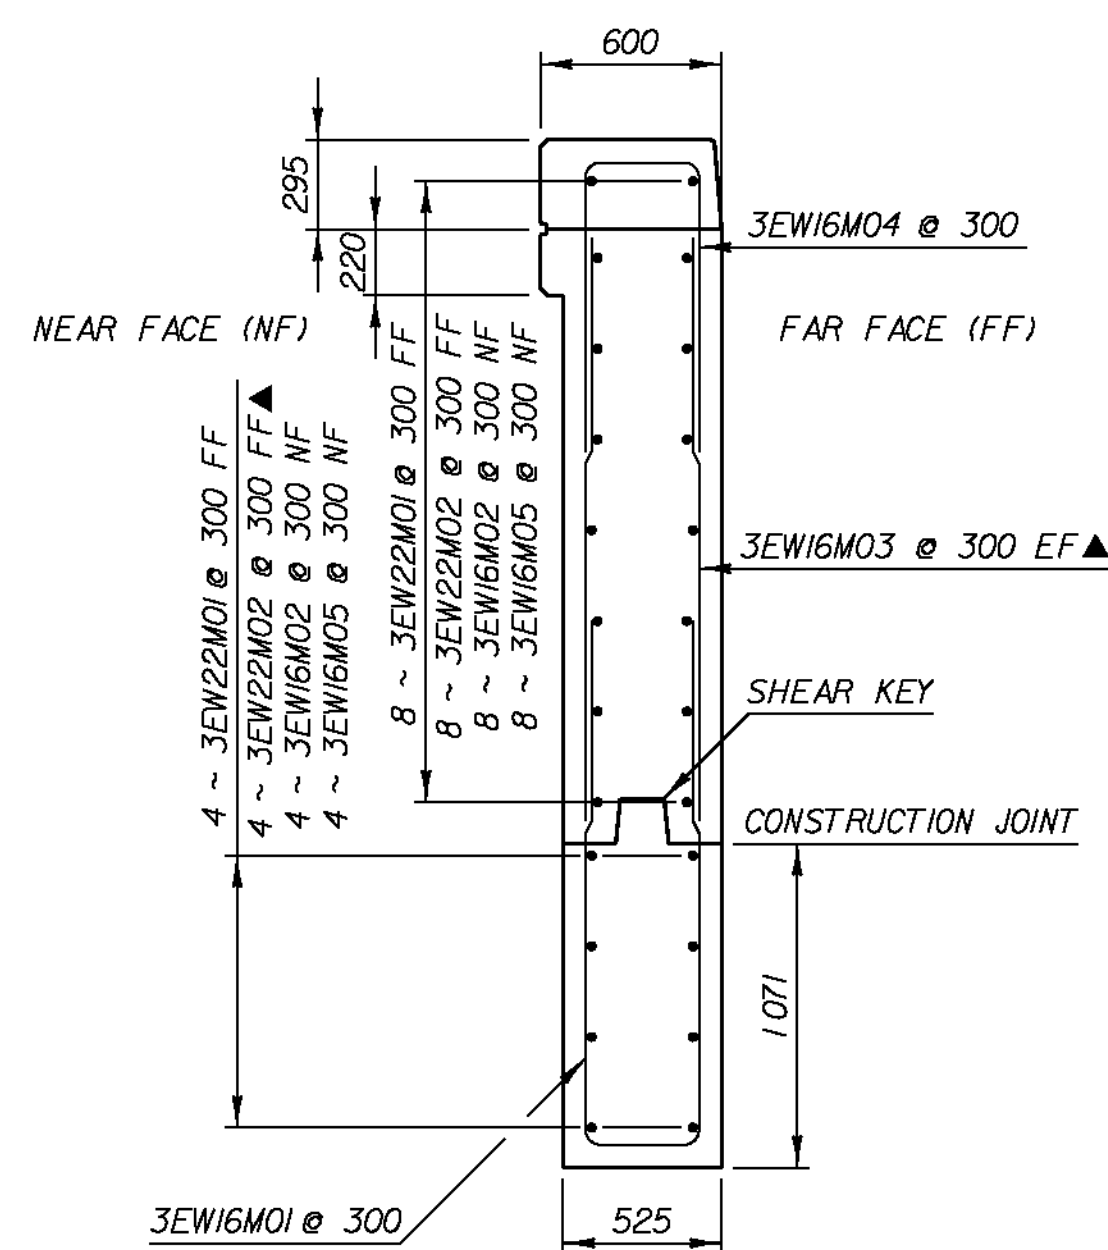


WINGWALL NO. 3 TYPICAL SECTION
SCALE: 1:25

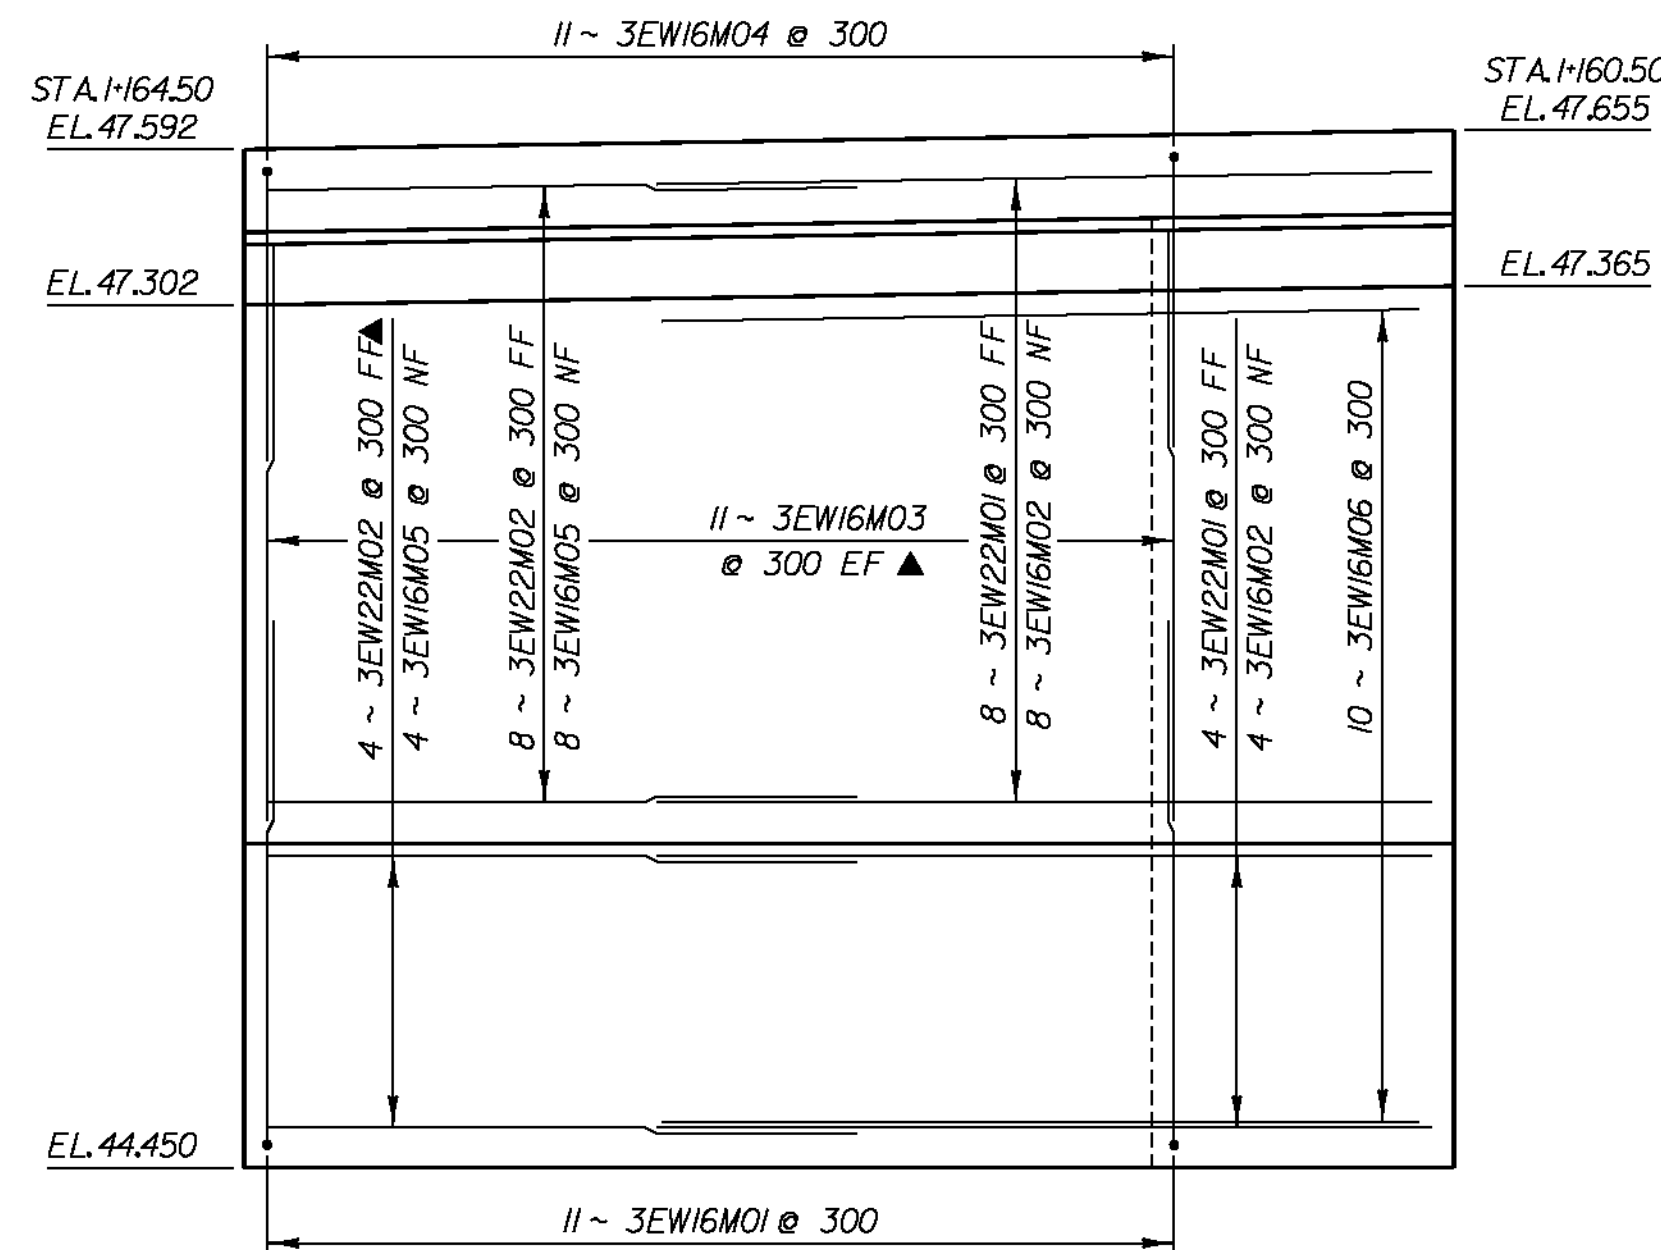

WINGWALL NO. 3 ELEVATION
SCALE: 1:25

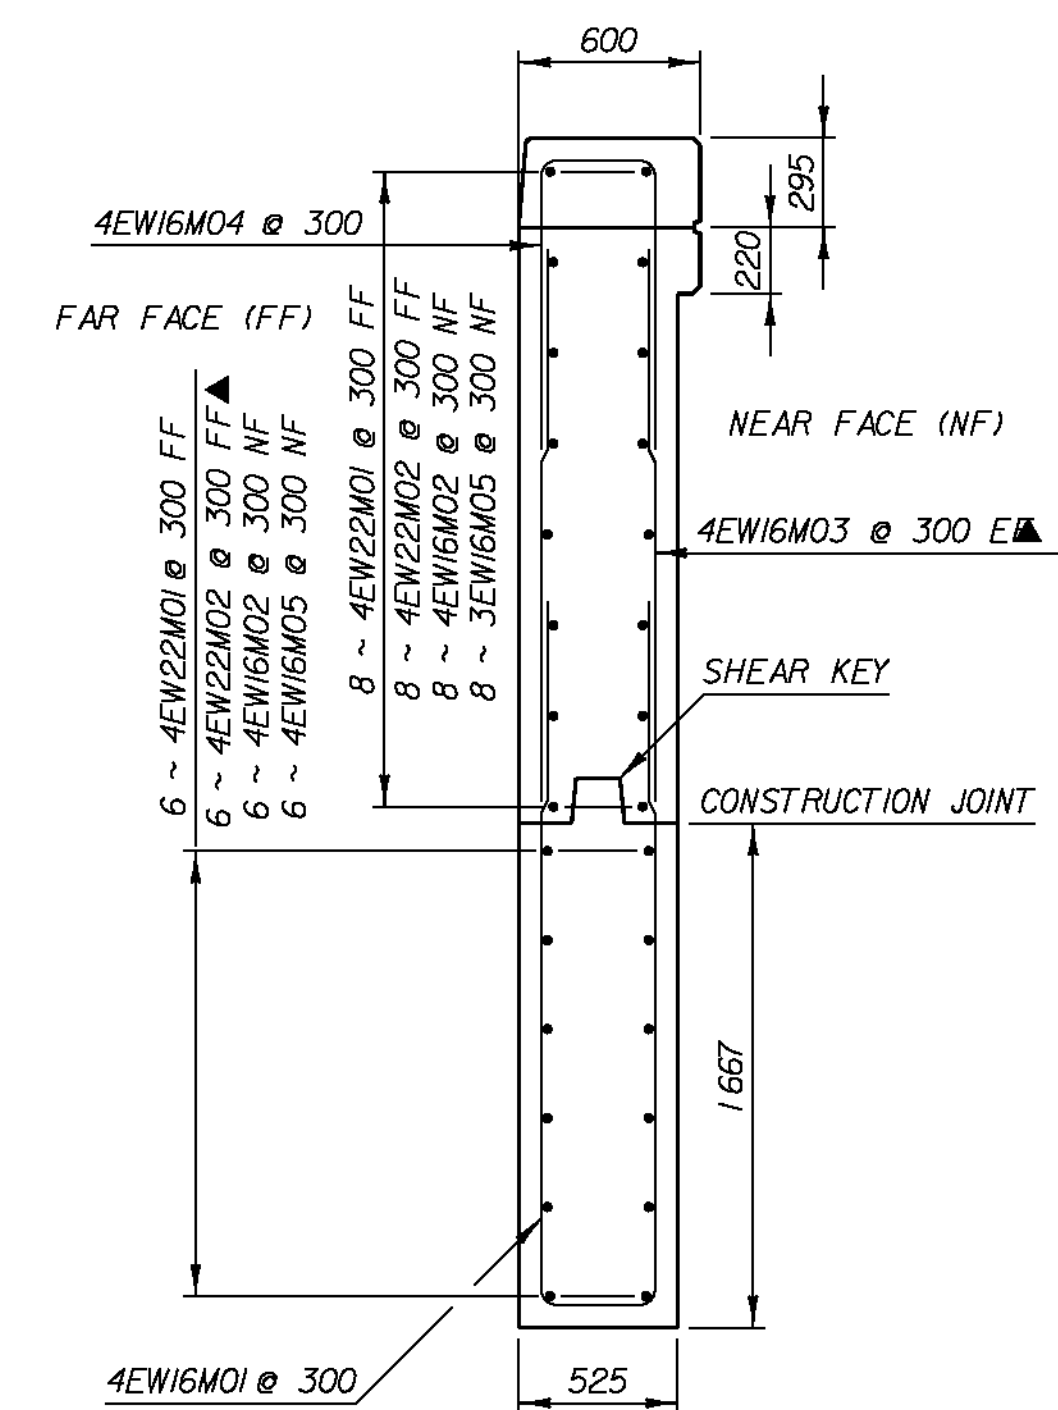

WINGWALL NO. 4 TYPICAL SECTION
SCALE: 1:25

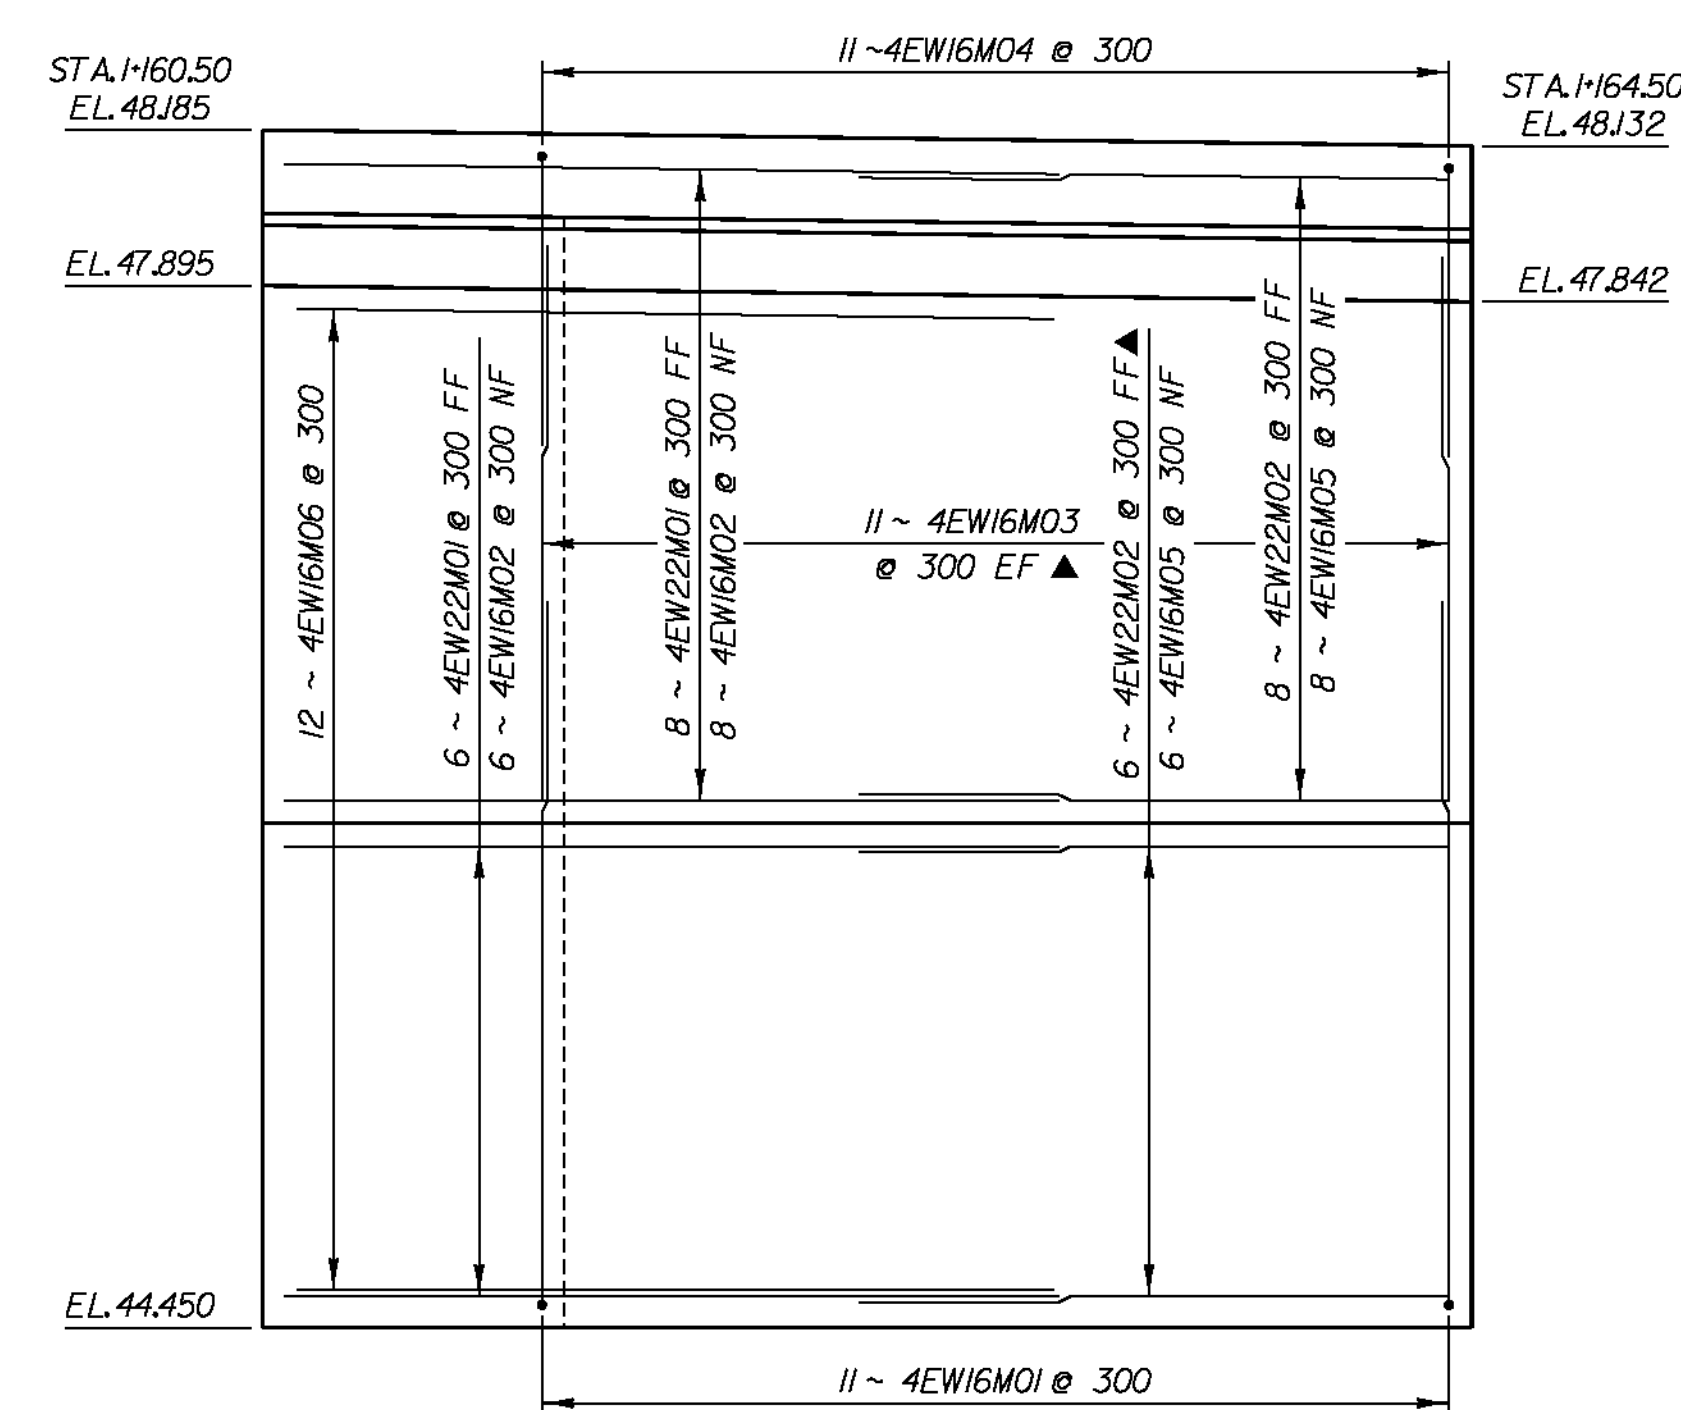

WINGWALL NO. 4 ELEVATION
SCALE: 1:25

DATUM	
VERTICAL	NAVD88
HORIZONTAL	NAD83(92)

NOTE:

- NF - NEAR FACE
 - FF - FAR FACE
 - EF - EACH FACE
 - ▲ - CUT TO FIT IN FIELD
- 75 CLR. UNLESS OTHERWISE SPECIFIED ON THE PLANS.

PROJECT NAME:	CORNWALL	PLOT DATE:	2/5/2010
PROJECT NUMBER:	BRS 0172(6)	PROJECT LEADER:	MARTHA EVANS-MONGEON
FILE NAME:	z85e042brddef.dgn	DESIGNED BY:	M. CRUZ
		DRAWN BY:	D. RITACCO
		CHECKED BY:	M. CRUZ
		WINGWALL DETAILS	SHEET 107 OF 144