



BANKING TRANSITION DETAIL

SCALES:
HORIZ: 1V:400
VERT: 1V:2.0

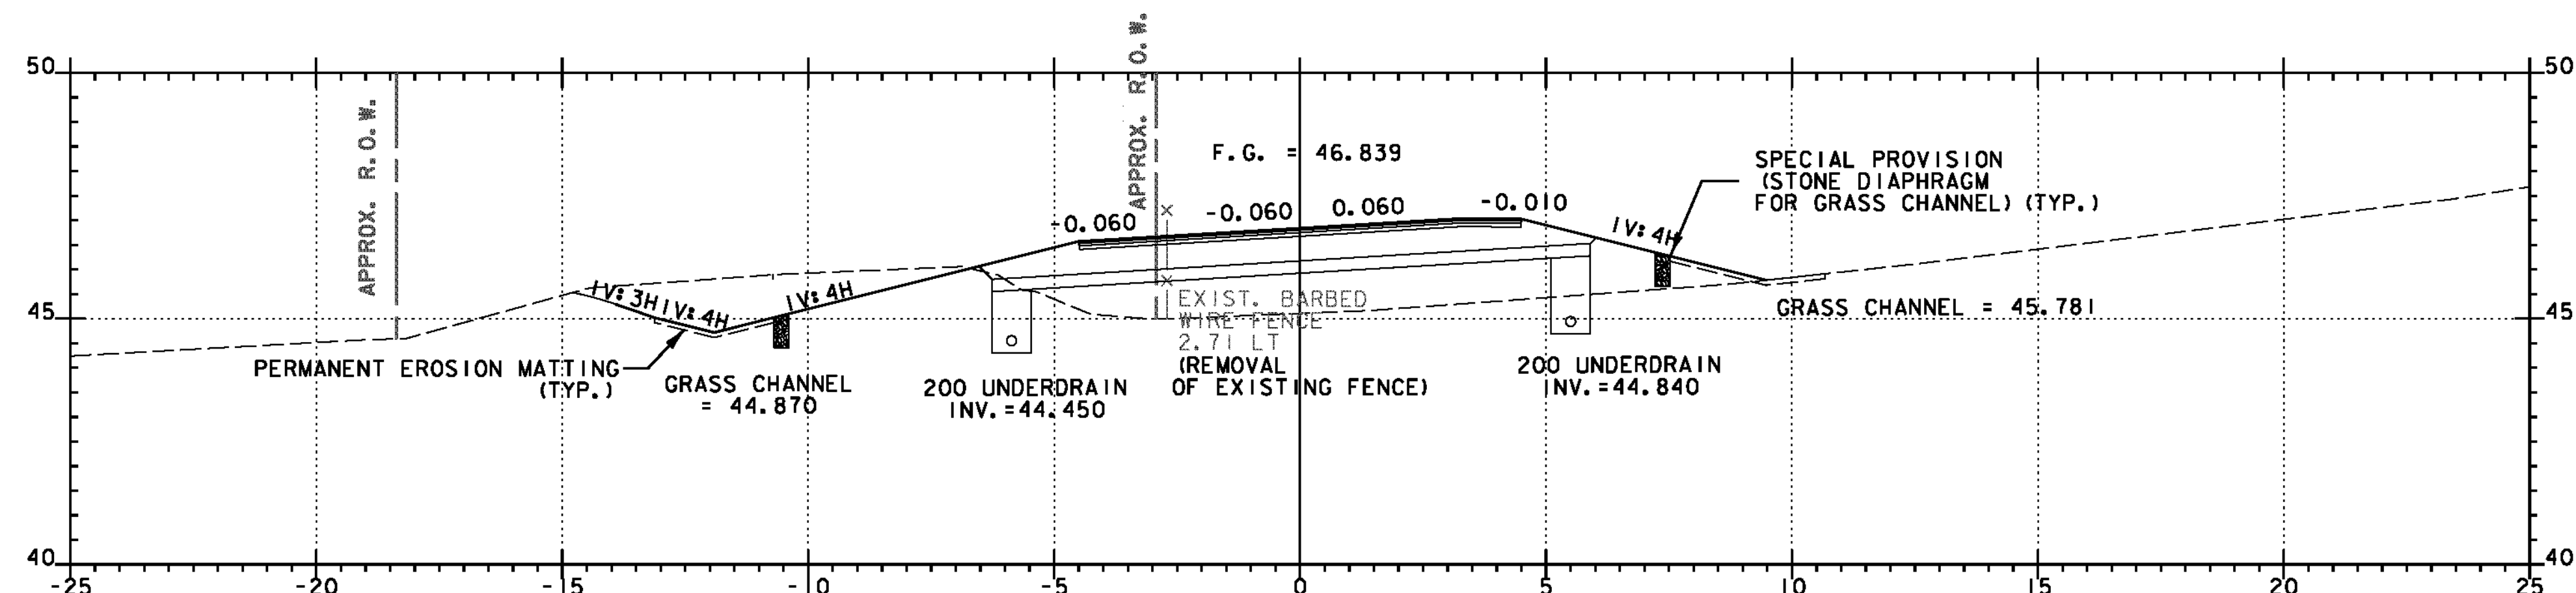


PCC I+312.485

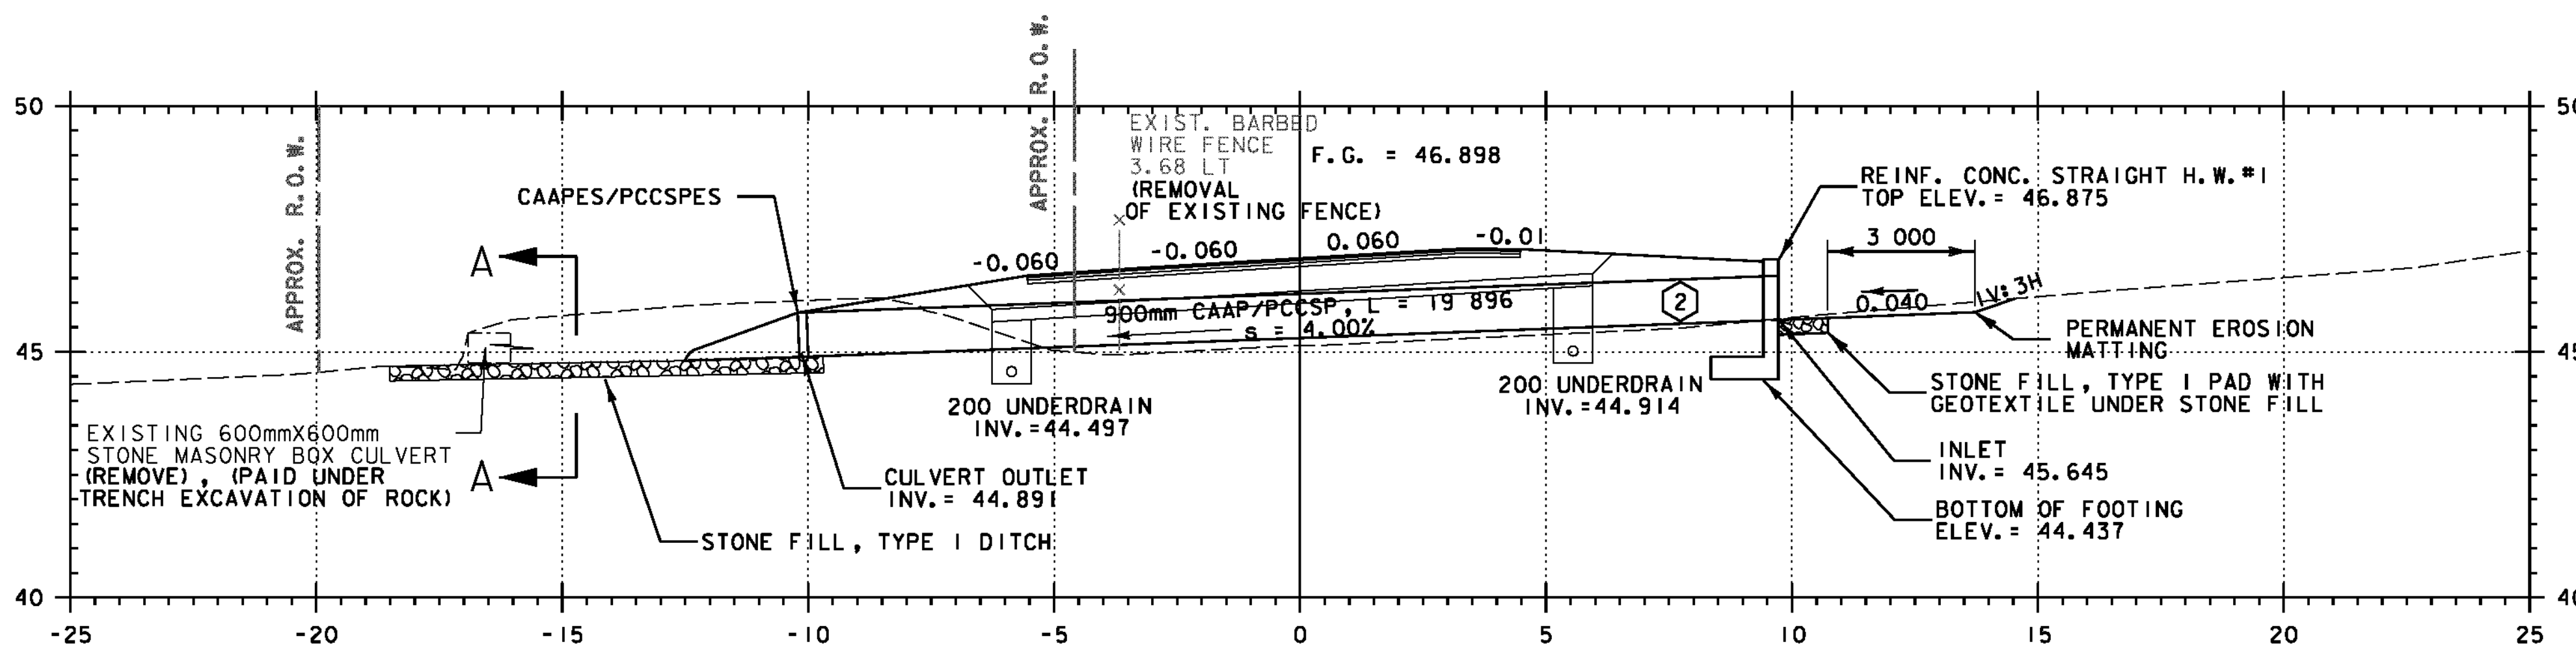


I+302.713
SKEWED 17° 55' 13"

**Mainline
VT 125**

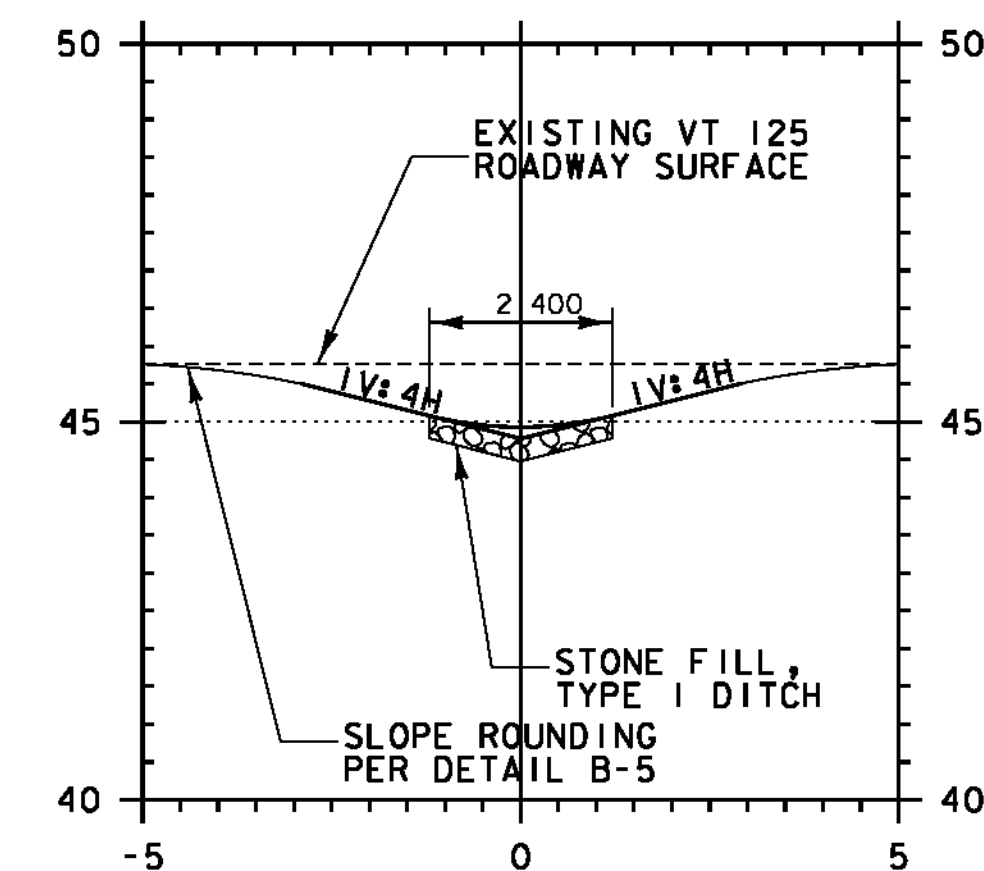

TYPICAL
SECTION A-A

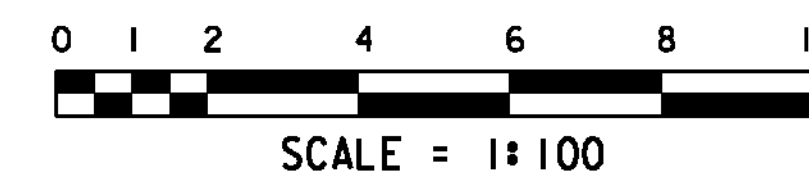

DATUM	
VERTICAL	NAVD 88
HORIZONTAL	NAD 83(92)

STA. I+302.713 TO STA. I+312.485

PROJECT: CORNWALL	PROJECT NO.: BRS 0172(6)
DESIGN FILE NAME: z85e042xs5.dgn	PLOT DATE: 2/12/2010
IPARM FILE NAME:	SURVEY DATE: 1996&1999
SURVEYED BY: VTRANS & VT SURVEY	DRAWN BY: ERIK ATKINS
SQUAD LEADER: MARTHA EVANS-MONGEON	SHEET: 126 OF 144
MAINLINE CROSS SECTION SHEET 9	