



3+270

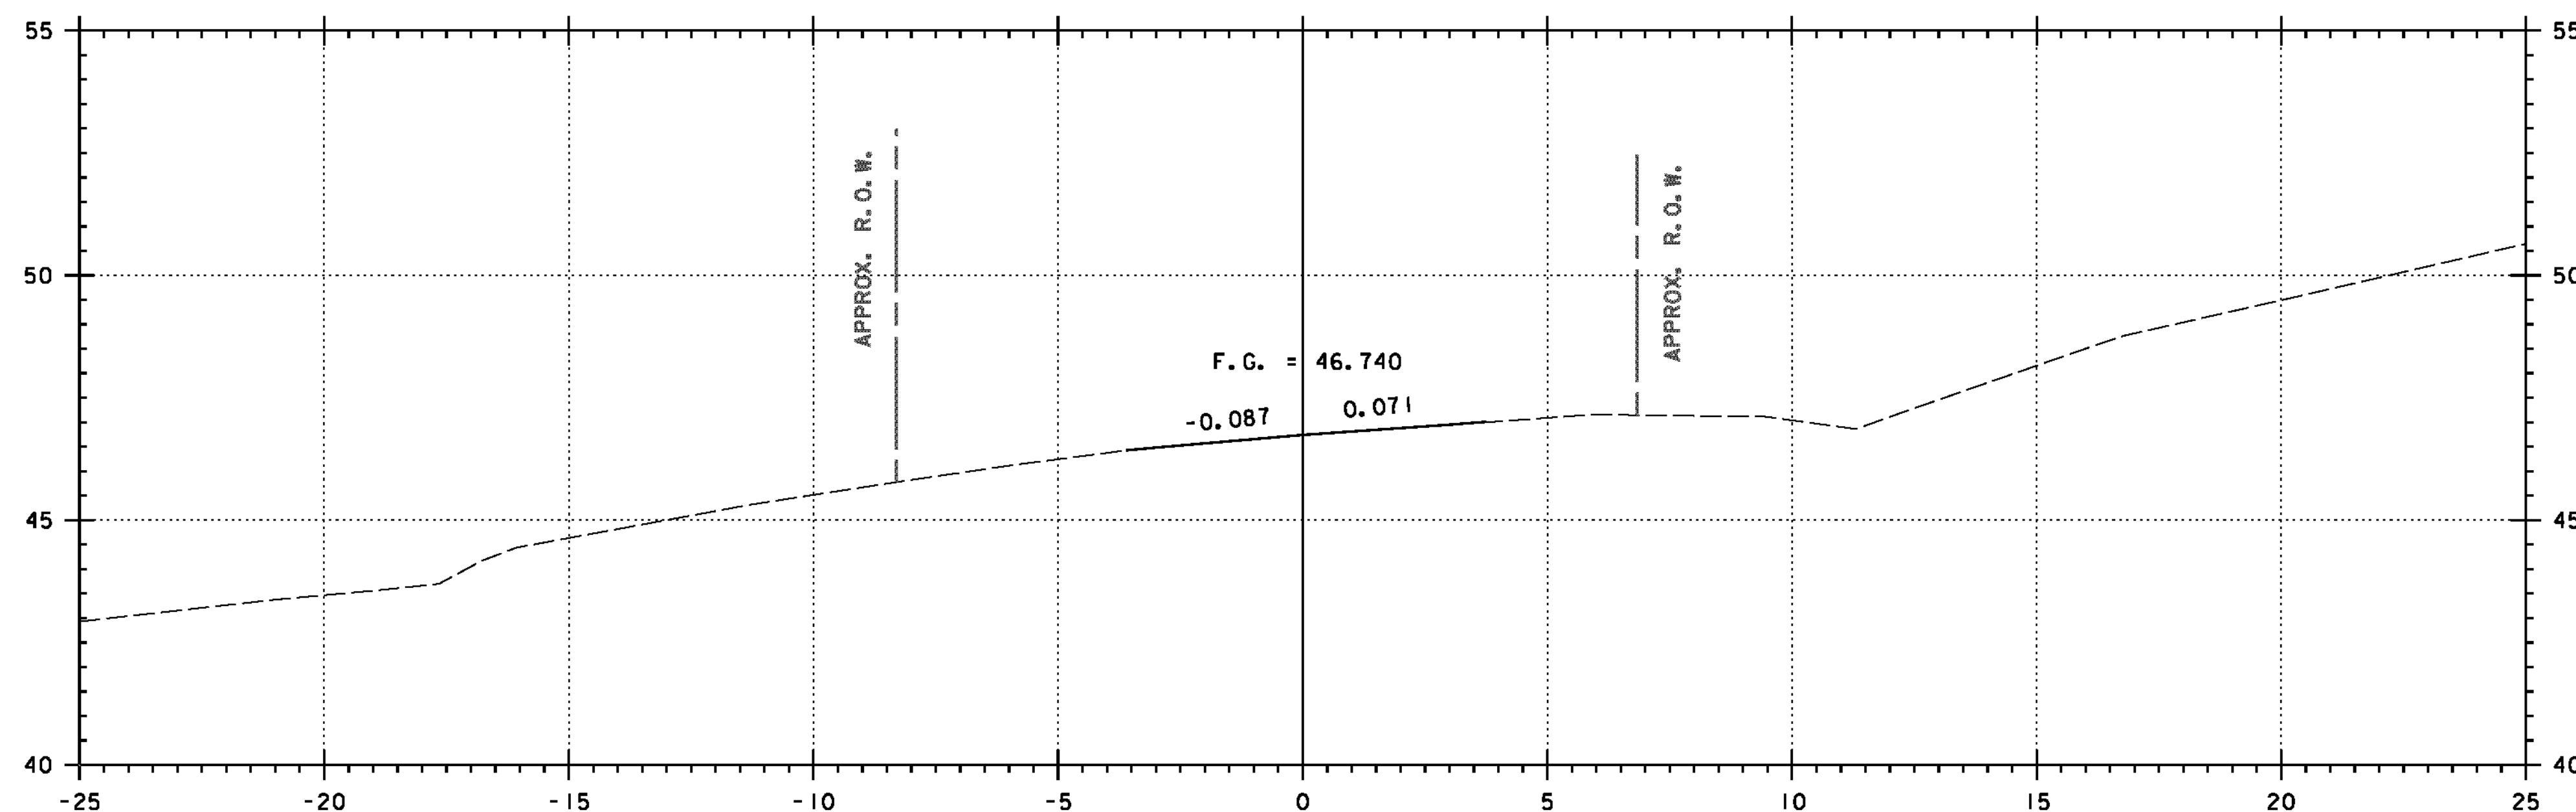

3+260.000
END APPROACH
MATCH EXISTING BCP

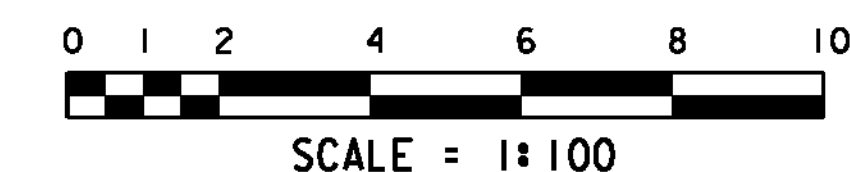

DATUM	
VERTICAL	NAVD 88
HORIZONTAL	NAD 83(92)

Temporary Detour

STA. 3+260 TO STA. 3+270

PROJECT: CORNWALL	PROJECT NO.: BRS 0172(6)
DESIGN FILE NAME: z85e042xs5.dgn	PLOT DATE: 2/5/2010
IPARM FILE NAME:	SURVEY DATE: 1996&1999
SURVEYED BY: VTRANS & VT SURVEY	DRAWN BY: ERIK ATKINS
SQUAD LEADER: MARTHA EVANS-MONGEON	
TEMPORARY DETOUR CROSS SECTION SHEET 8	SHEET: 142 OF 144