


PROJECT DESCRIPTION AND LOCATION

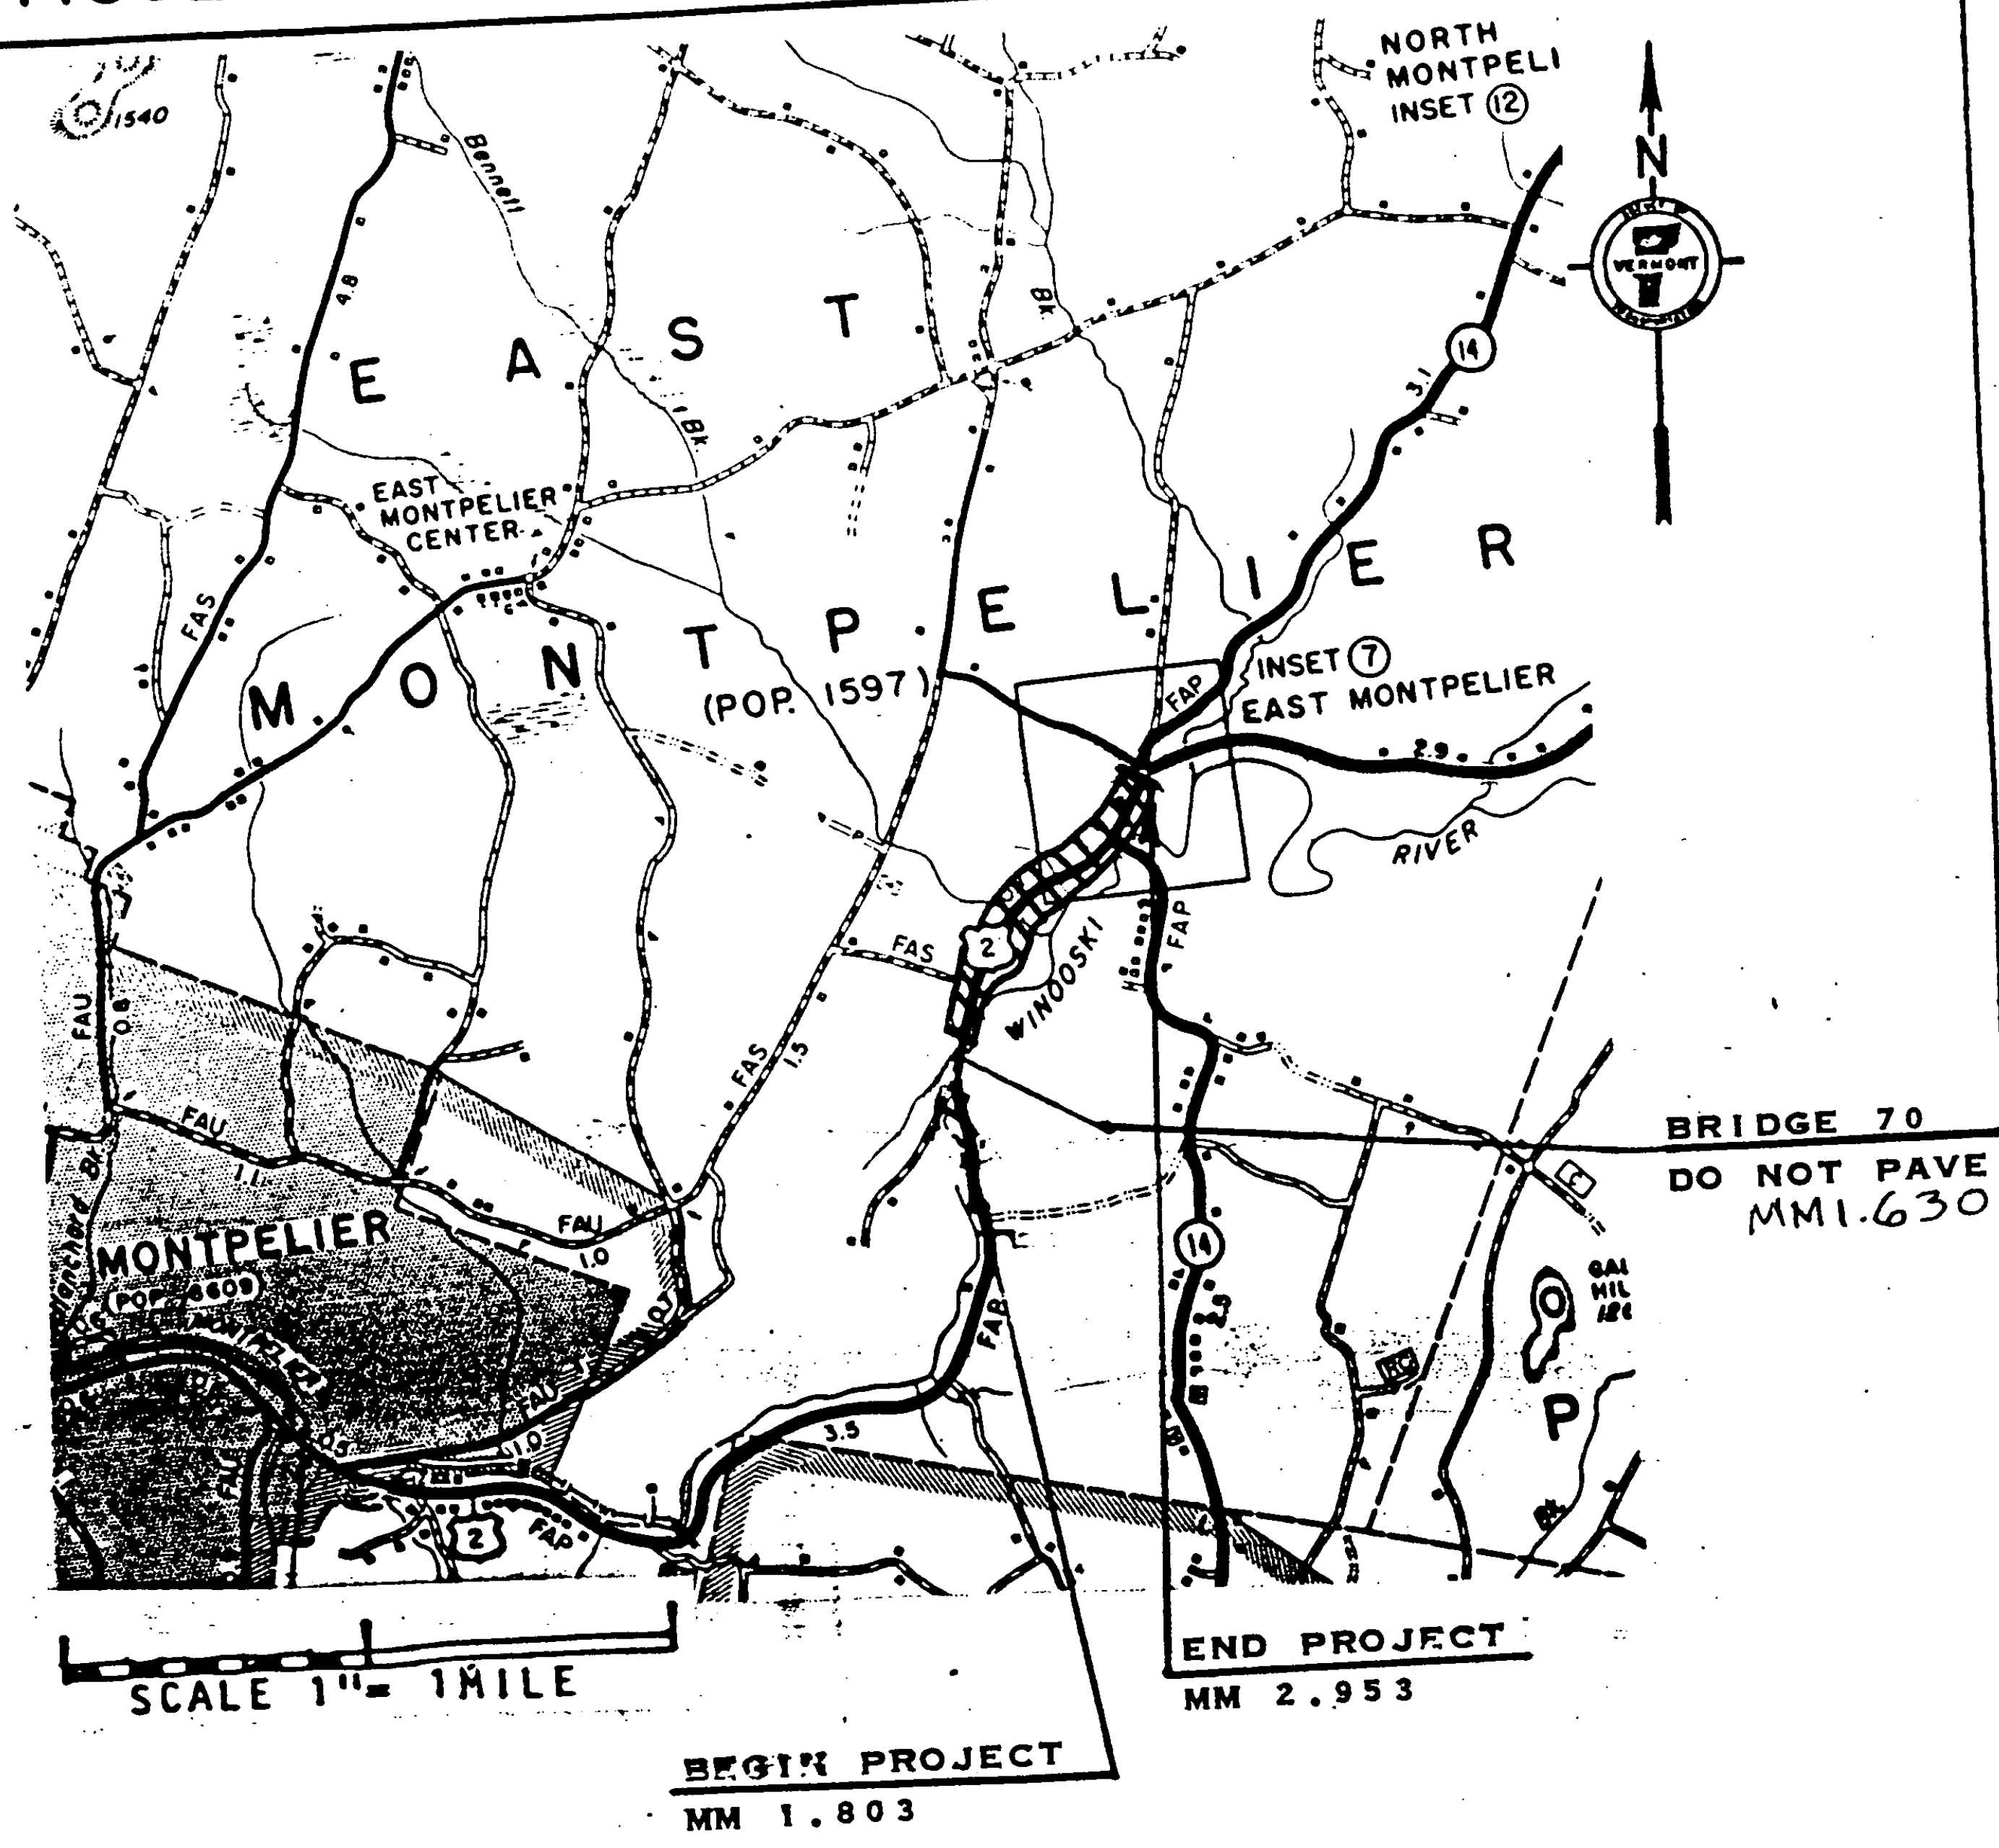

US2-BEGINNING IN EAST MONTPELIER AT MM 1.803 AND EXTENDING
 NORTHERLY 1.150 MILES TO MM 2.953, THE JUNCTION OF US 2
 AND VT 14

LENGTH OF PROJECT
 1.150 MILES
 6072 FEET

PROJECT EAST MONTPELIER

NO. HMA 2615
 SHEET 5 OF 20 SHEETS