


PROJECT DESCRIPTION AND LOCATION

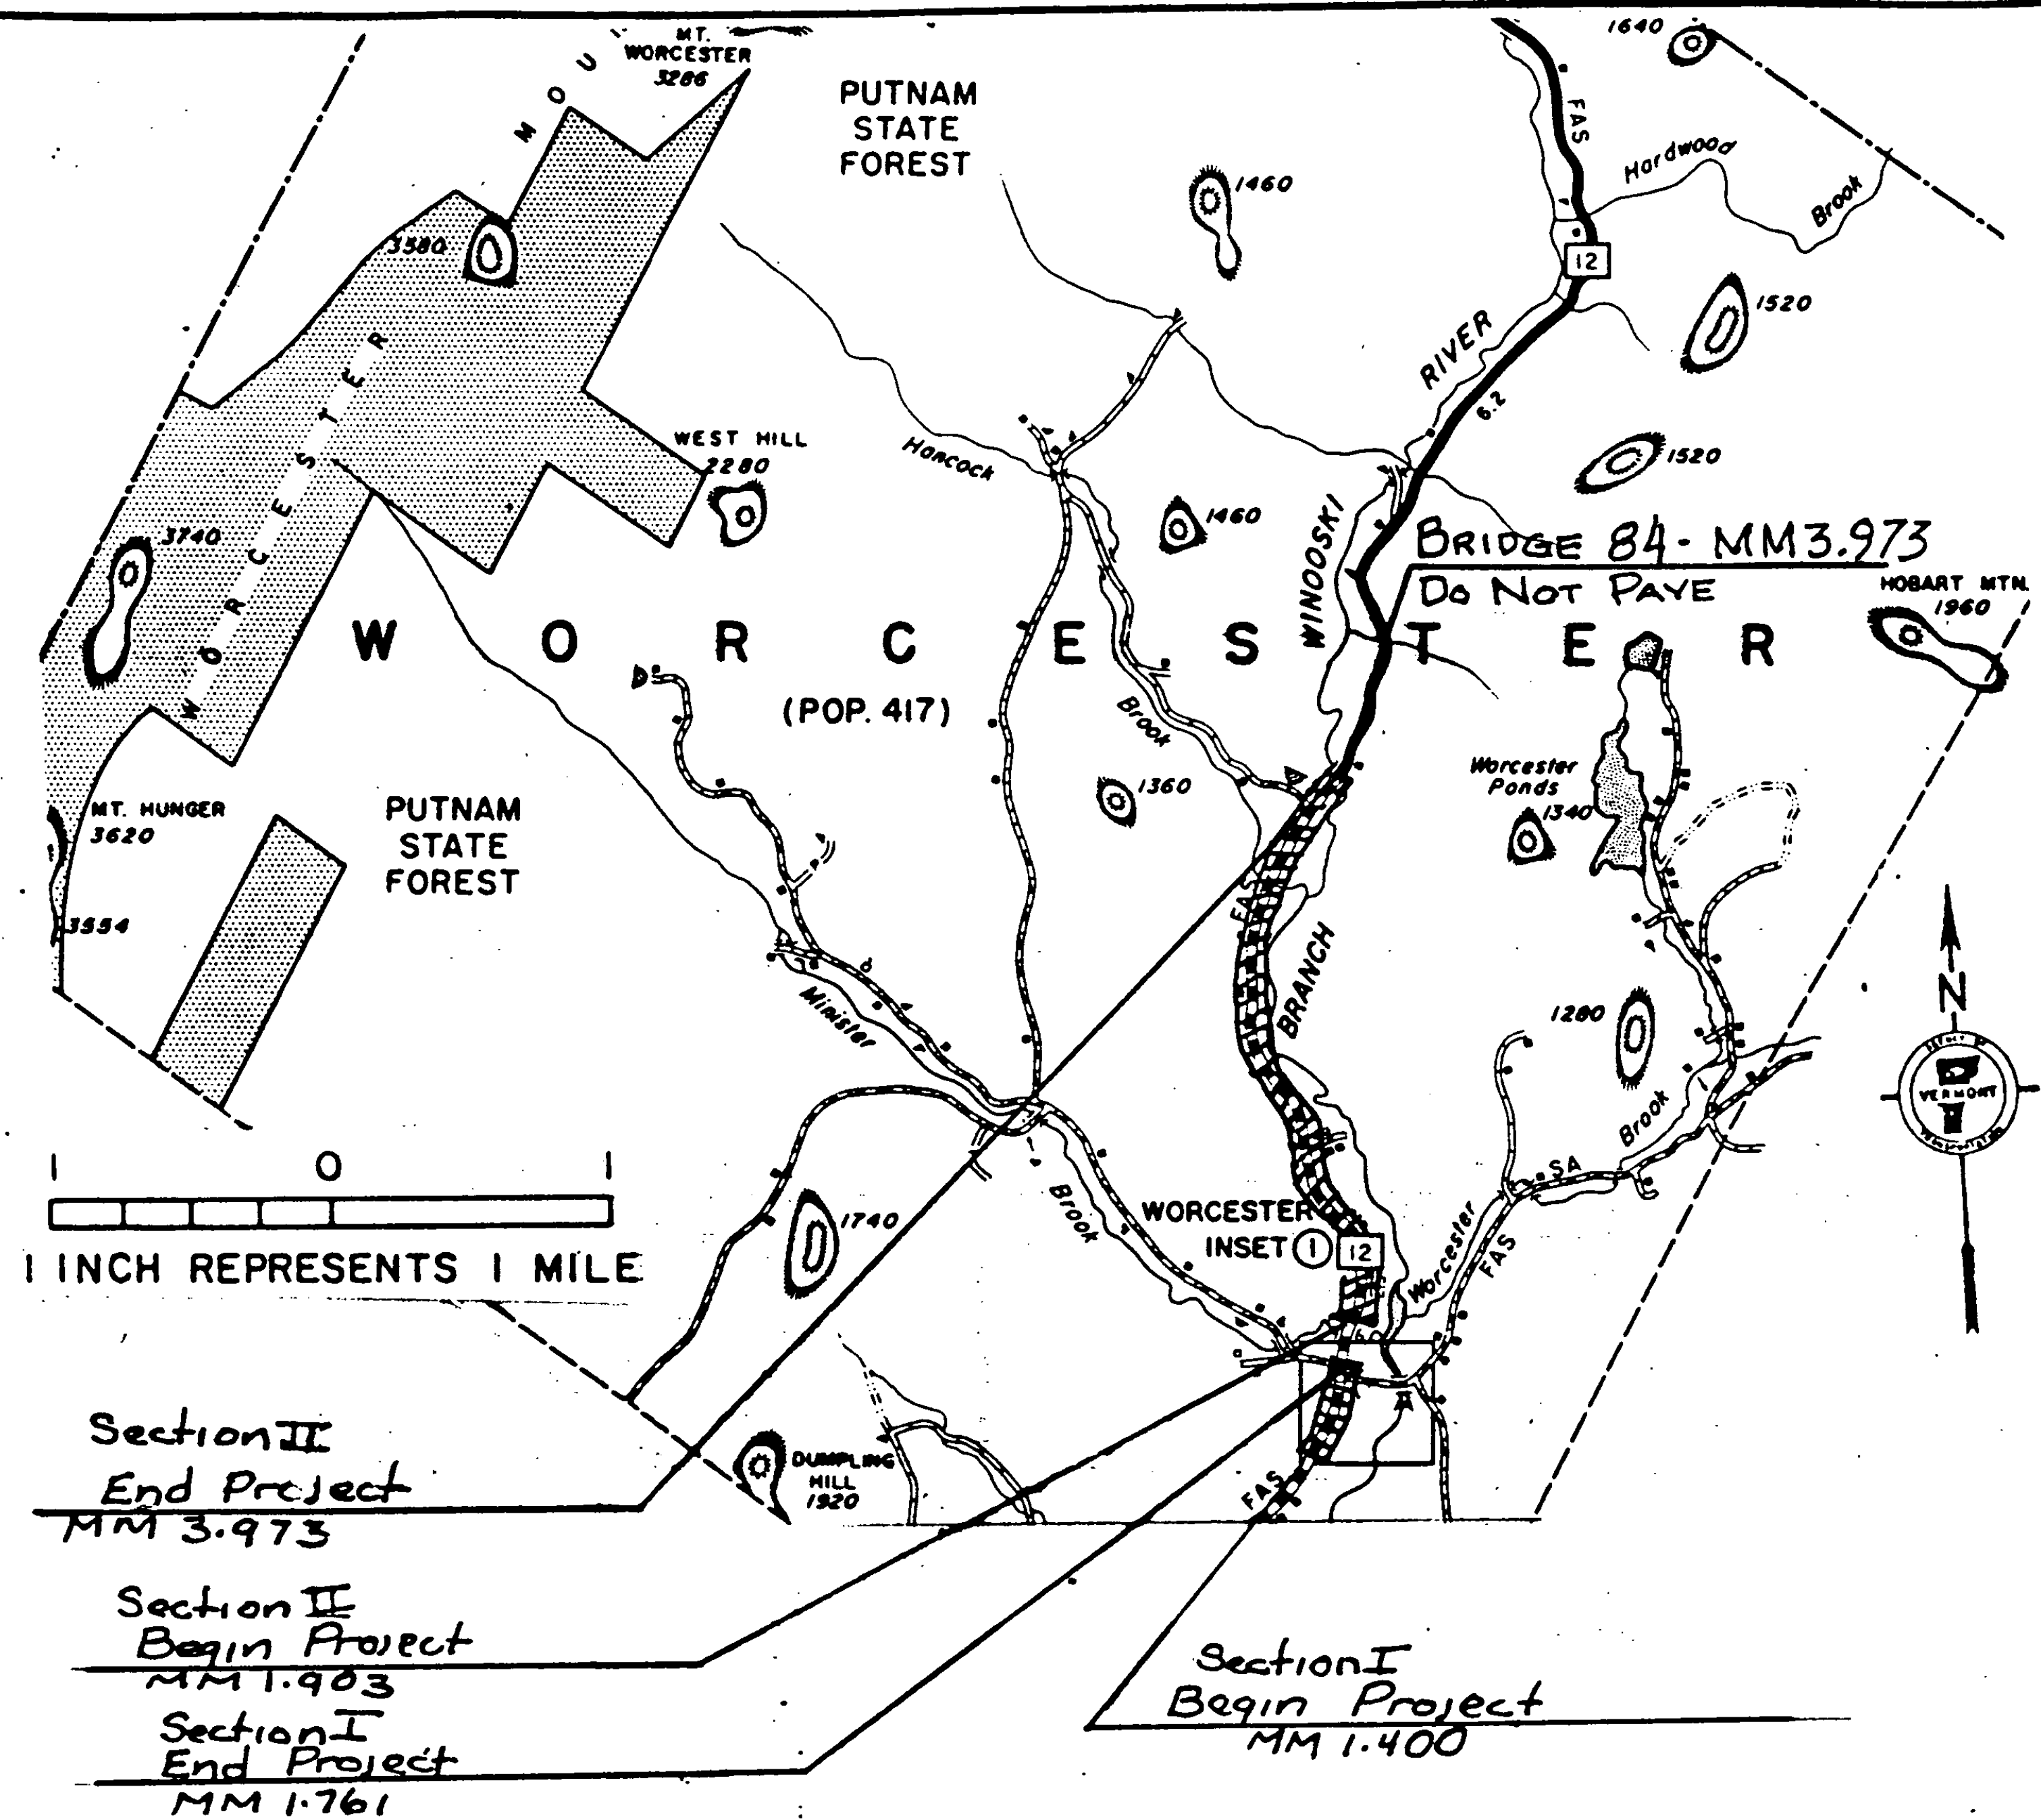

Vt 12 Section I Beginning in the Town of Worcester at MM 1.400
 And extending northerly for 0.361 miles to MM 1.761

Section II Beginning in the Town of Worcester at MM 1.903
 and extending northerly 2.070 miles to MM 3.973

Length of Project

Section I	0.361 miles	1906 Feet
Section II	2.070 miles	10930 Feet