


PROJECT DESCRIPTION AND LOCATION

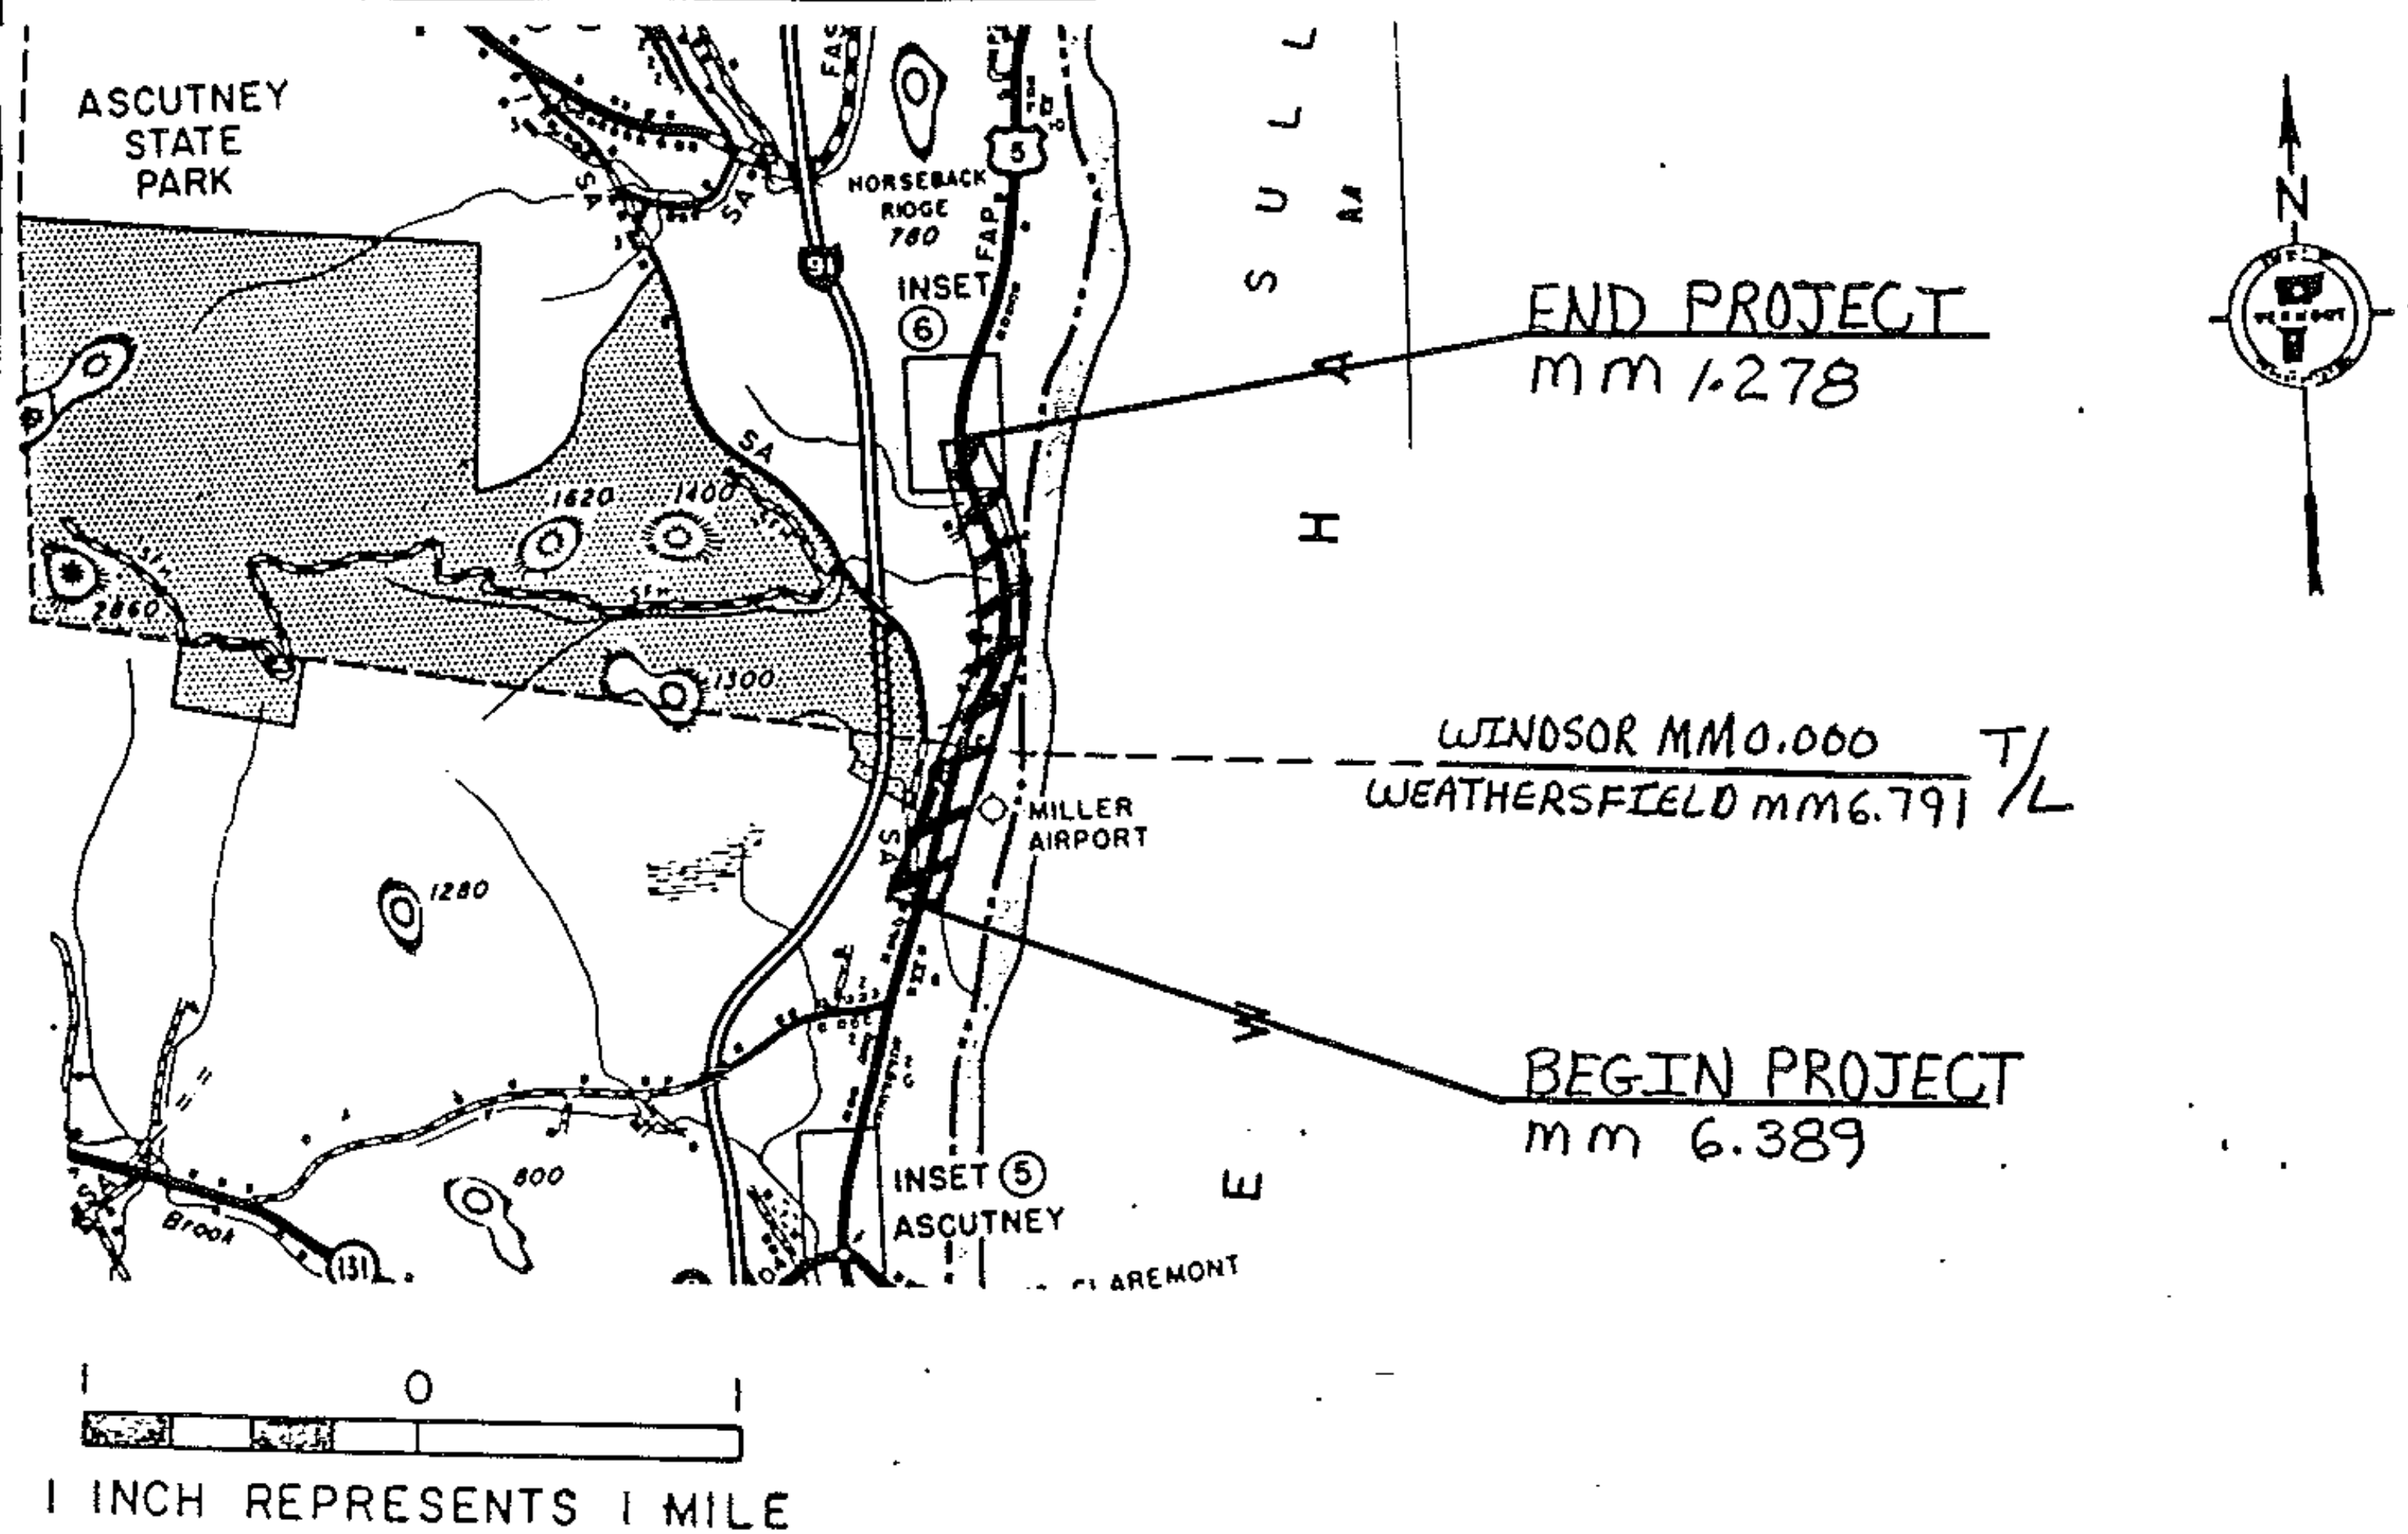

ON US 5 - BEGINNING IN THE TOWN OF WEATHERSFIELD AT
MM 6.389 AND EXTENDING 1.680 MILES NORTHERLY TO MM 1.278
IN THE TOWN OF WINDSOR.

LENGTH OF PROJECT
1.680 MILES
8870 FEET