


TYPICAL SECTIONS & DESIGN DATA

ITEM 406.25 BITUMINOUS CONCRETE PAVEMENT
LEVELING COURSE TYPE III OR IV (350 TONS/MILE)
AS DIRECTED BY THE ENGINEER
3/4" WEARING COURSE, "(±1/4)" TYPE IV

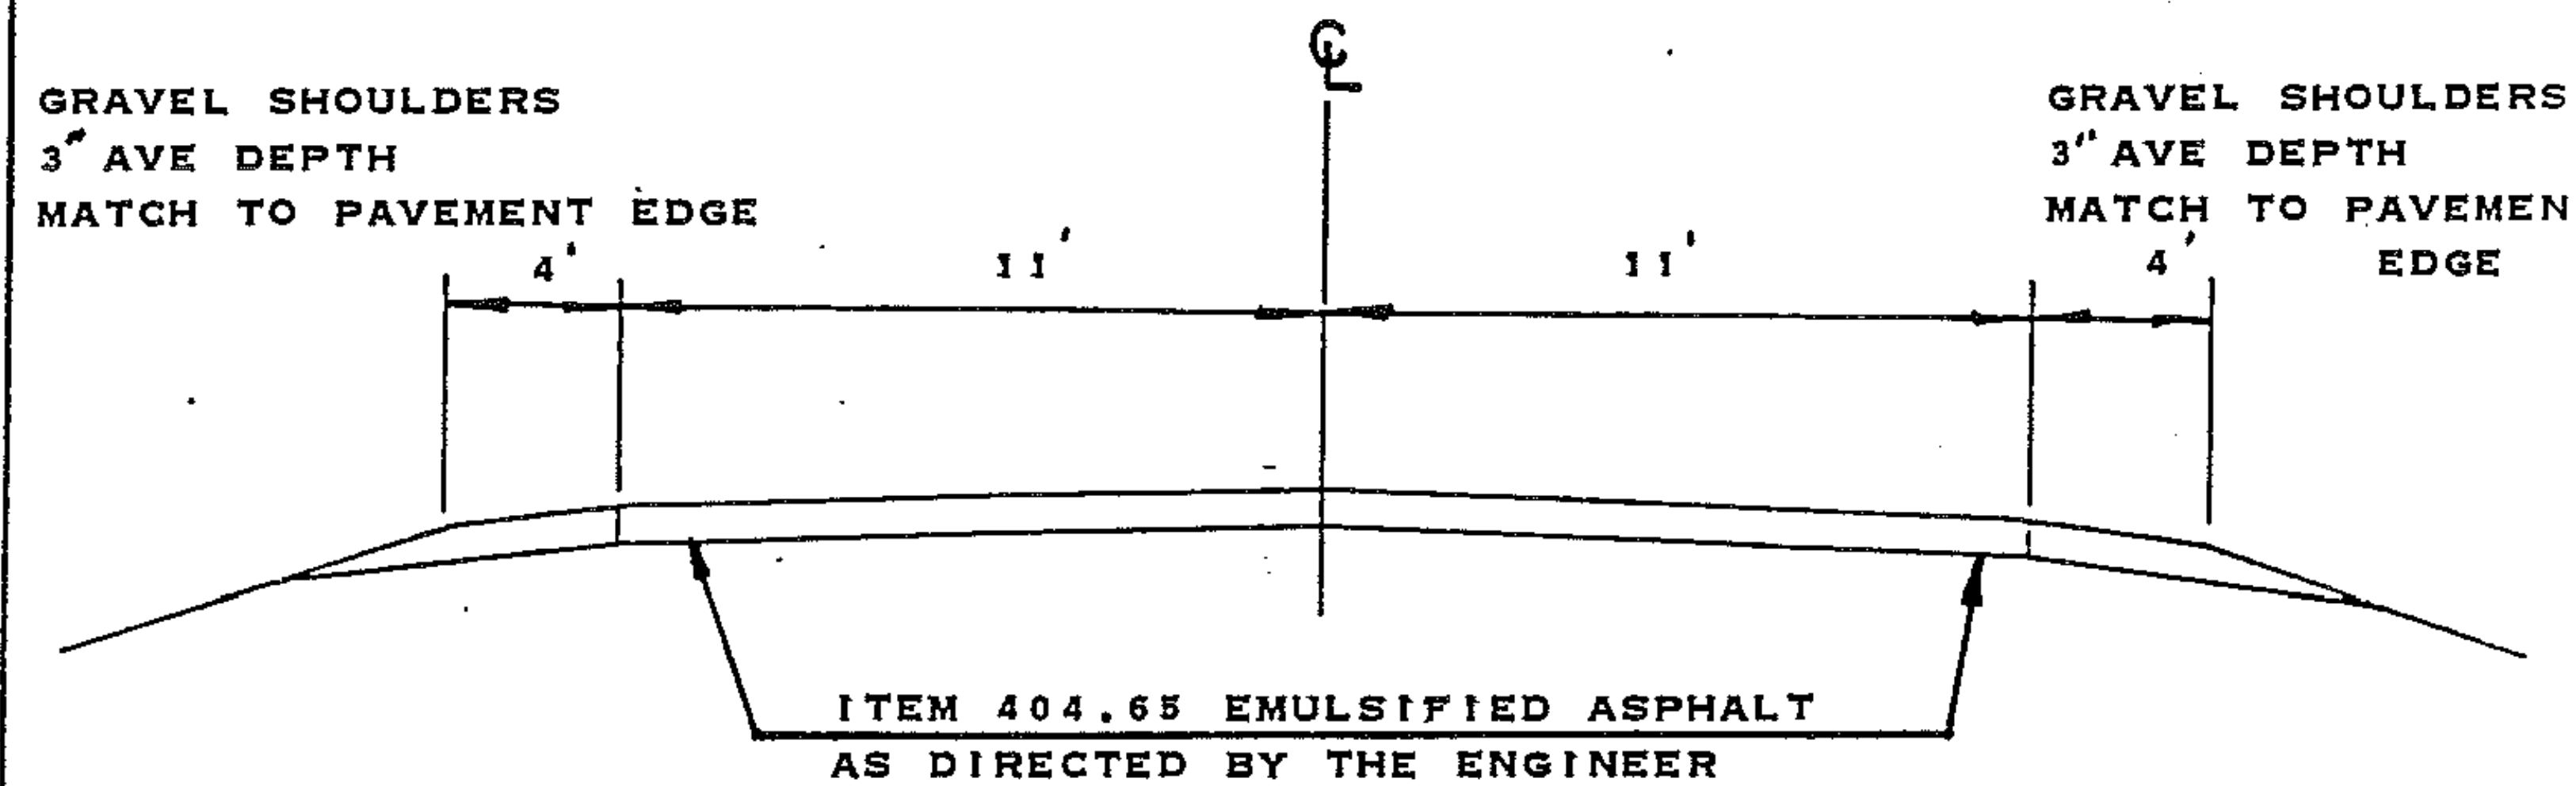

HARTLAND
MM 0.450-MM 7.705
1982 ADT 1190
V 50

NO. HMA 2616

SHEET 9 OF 21 SHEETS

PROJECT HARTLAND