


PROJECT DESCRIPTION AND LOCATION

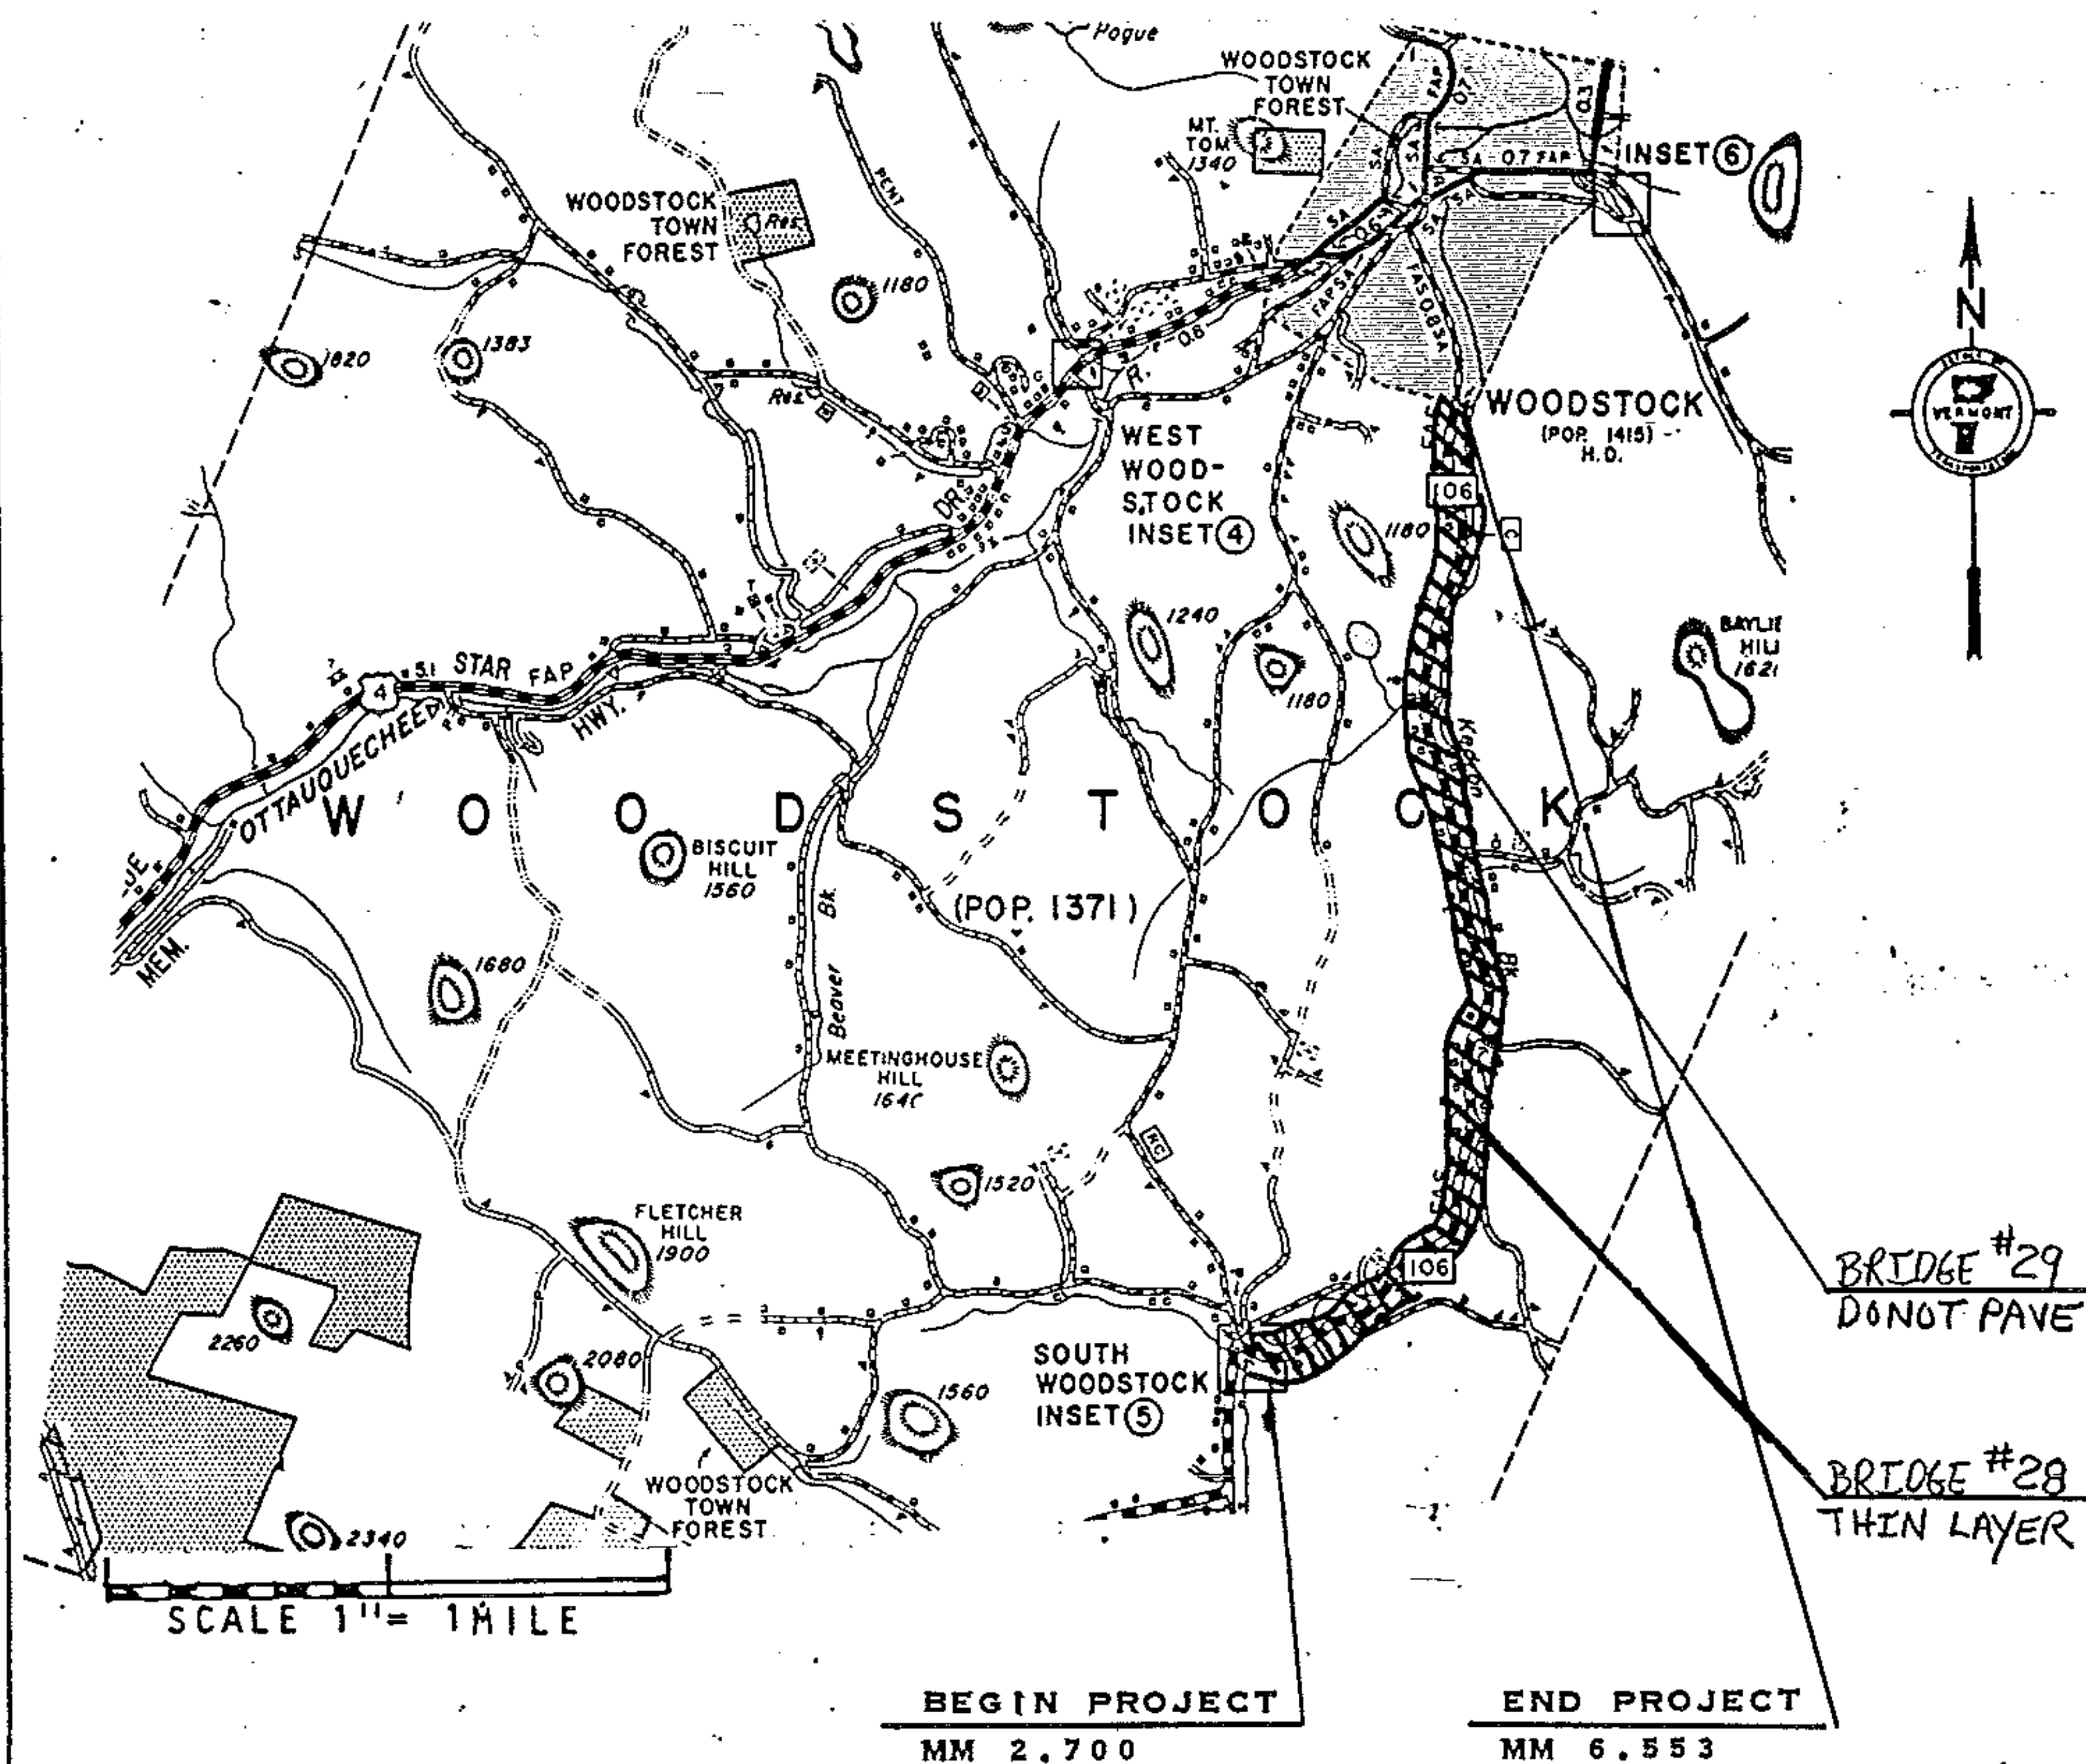

VT 106 - IN THE TOWN OF WOODSTOCK BEGINNING AT MM 2.700 AND
EXTENDING 3.853 MILES TO MM 6.553

LENGTH OF PROJECT
3.853 MILES
20344 FEET

PROJECT WOODSTOCK

NO. HMA 2617

SHEET 12 OF 27 SHEETS