


TYPICAL SECTIONS & DESIGN DATA

ITEM 406.25 BITUMINOUS CONCRETE PAVEMENT
LEVELING COURSE TYPE III OR IV (273 TONS/MILE)
AS DIRECTED BY THE ENGINEER
3/4" WEARING COURSE ($\pm 1/4$ ") TYPE IV

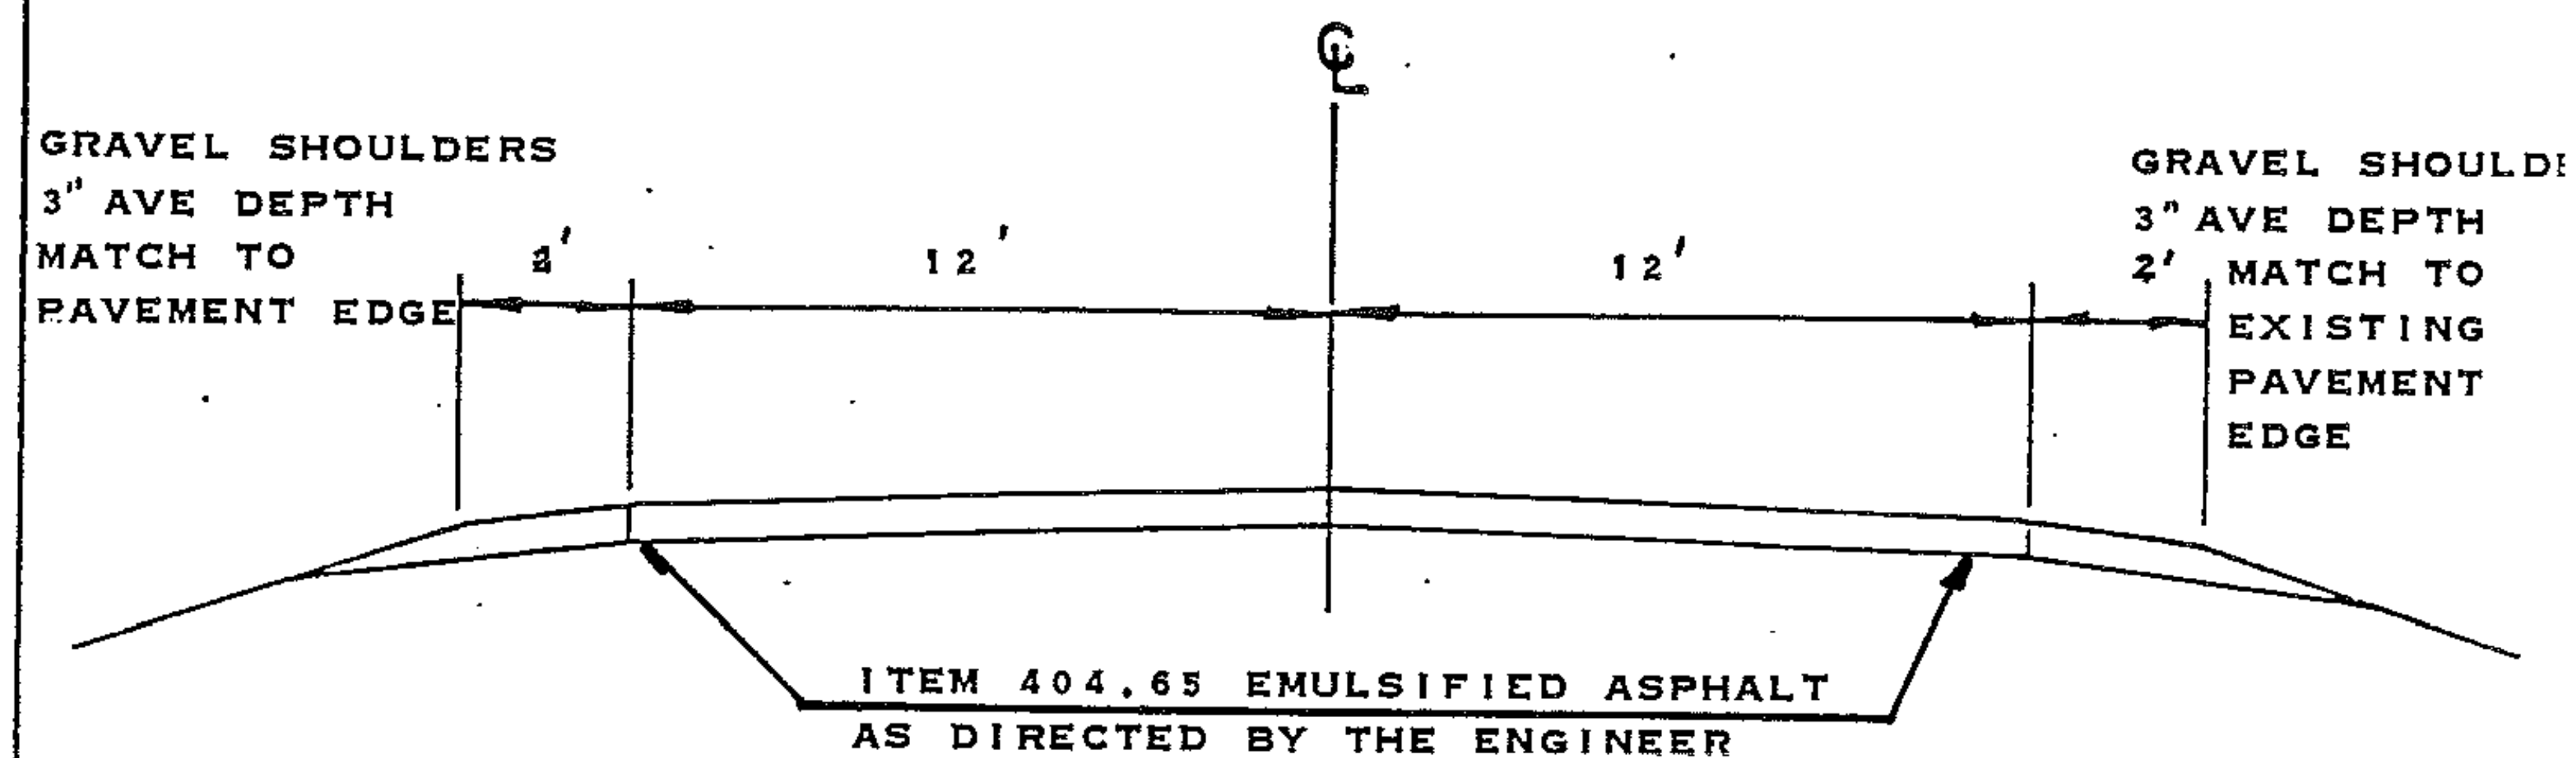

WOODSTOCK .
MM 2.700 MM 6.553
VT 106

1982 ADT 1620
V 50

PROJECT WOODSTOCK

NO. HMA 2617

SHEET ¹³ OF ₂₇ SHEETS