



TYPICAL SECTIONS & DESIGN DATA

ITEM 406.25 BITUMINOUS CONCRETE PAVEMENT
 LEVELING COURSE TYPE III OR IV (150 TONS/MILE)
 AS DIRECTED BY THE ENGINEER
 1 1/4" WEARING COURSE ($\pm 1/4$) TYPE III

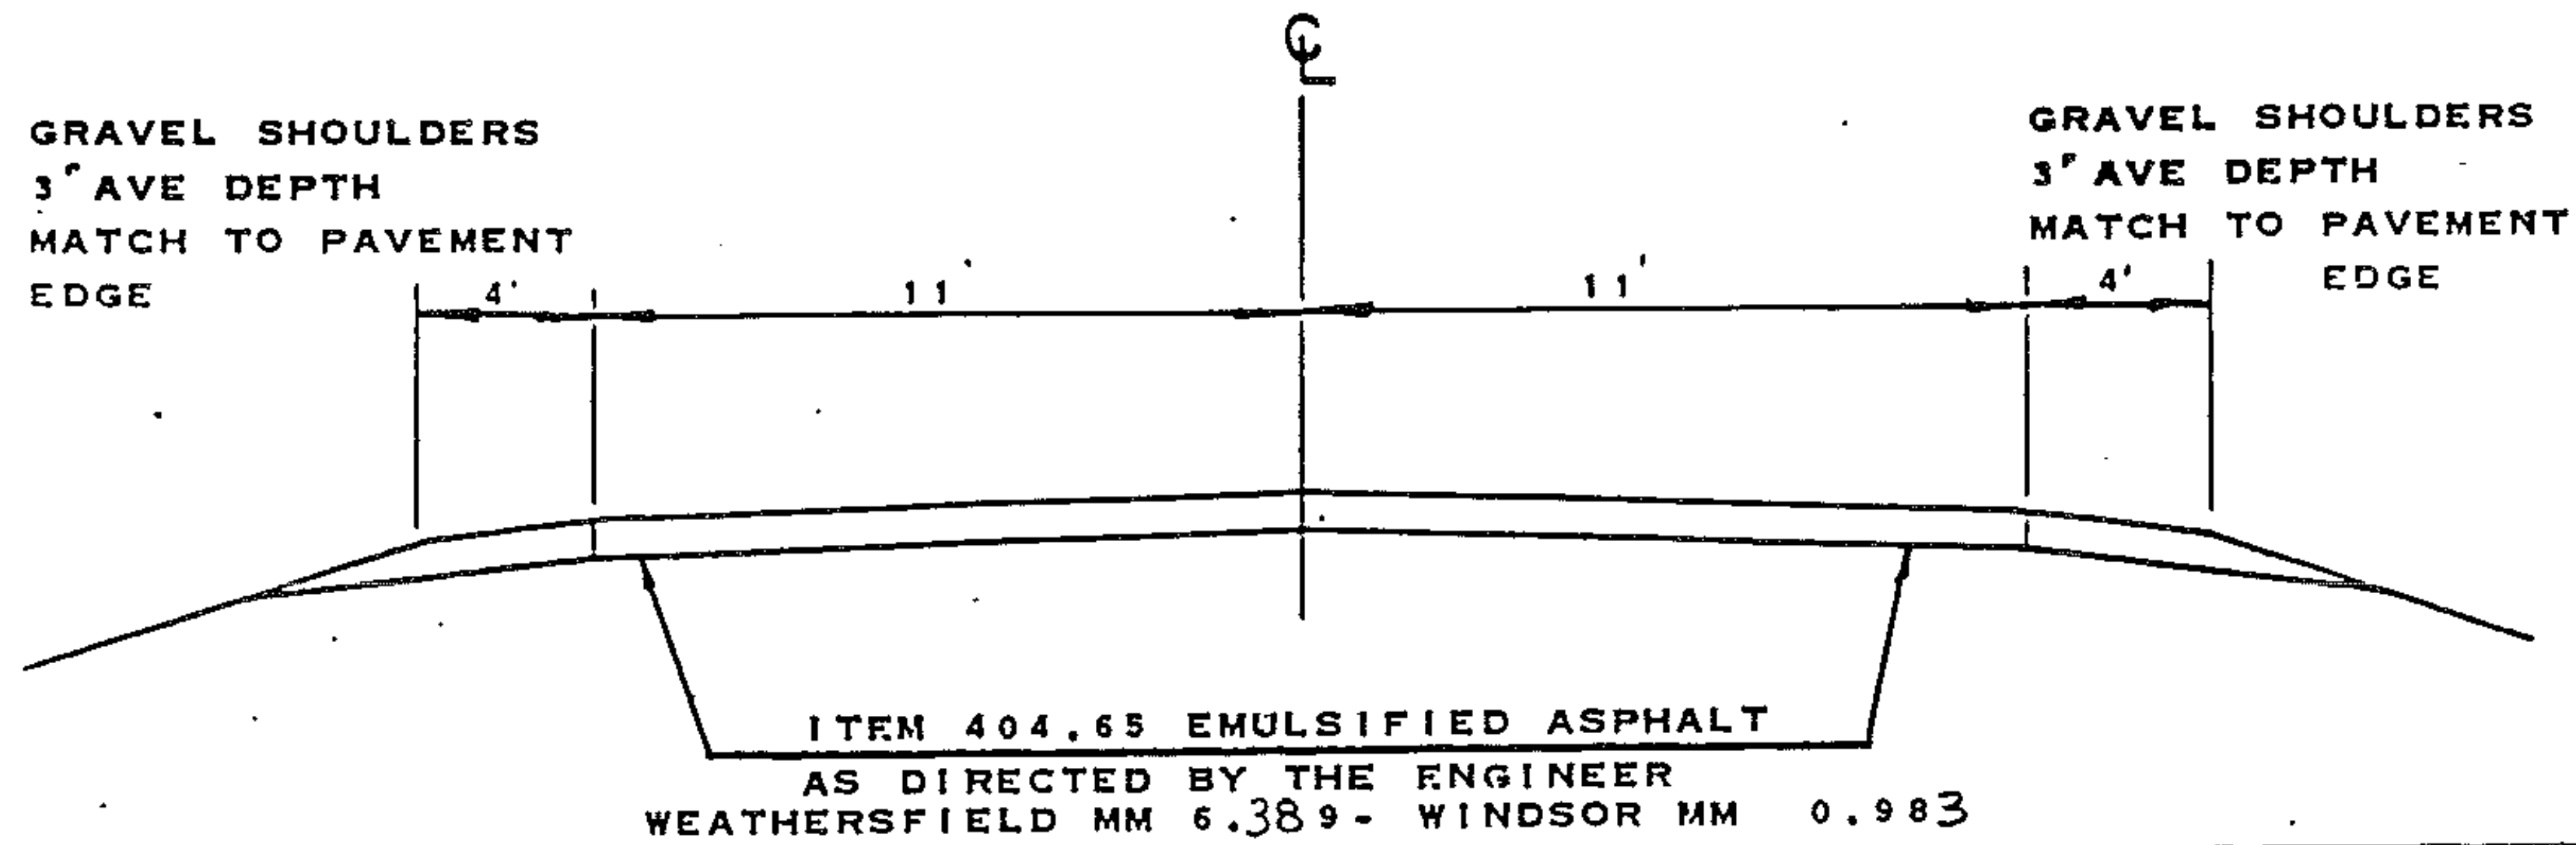

ITEM 406.25 BITUMINOUS CONCRETE PAVEMENT
 LEVELING COURSE TYPE III OR IV (164 TONS/MILE)
 AS DIRECTED BY THE ENGINEER
 1 1/4" WEARING COURSE ($\pm 1/4$) TYPE III

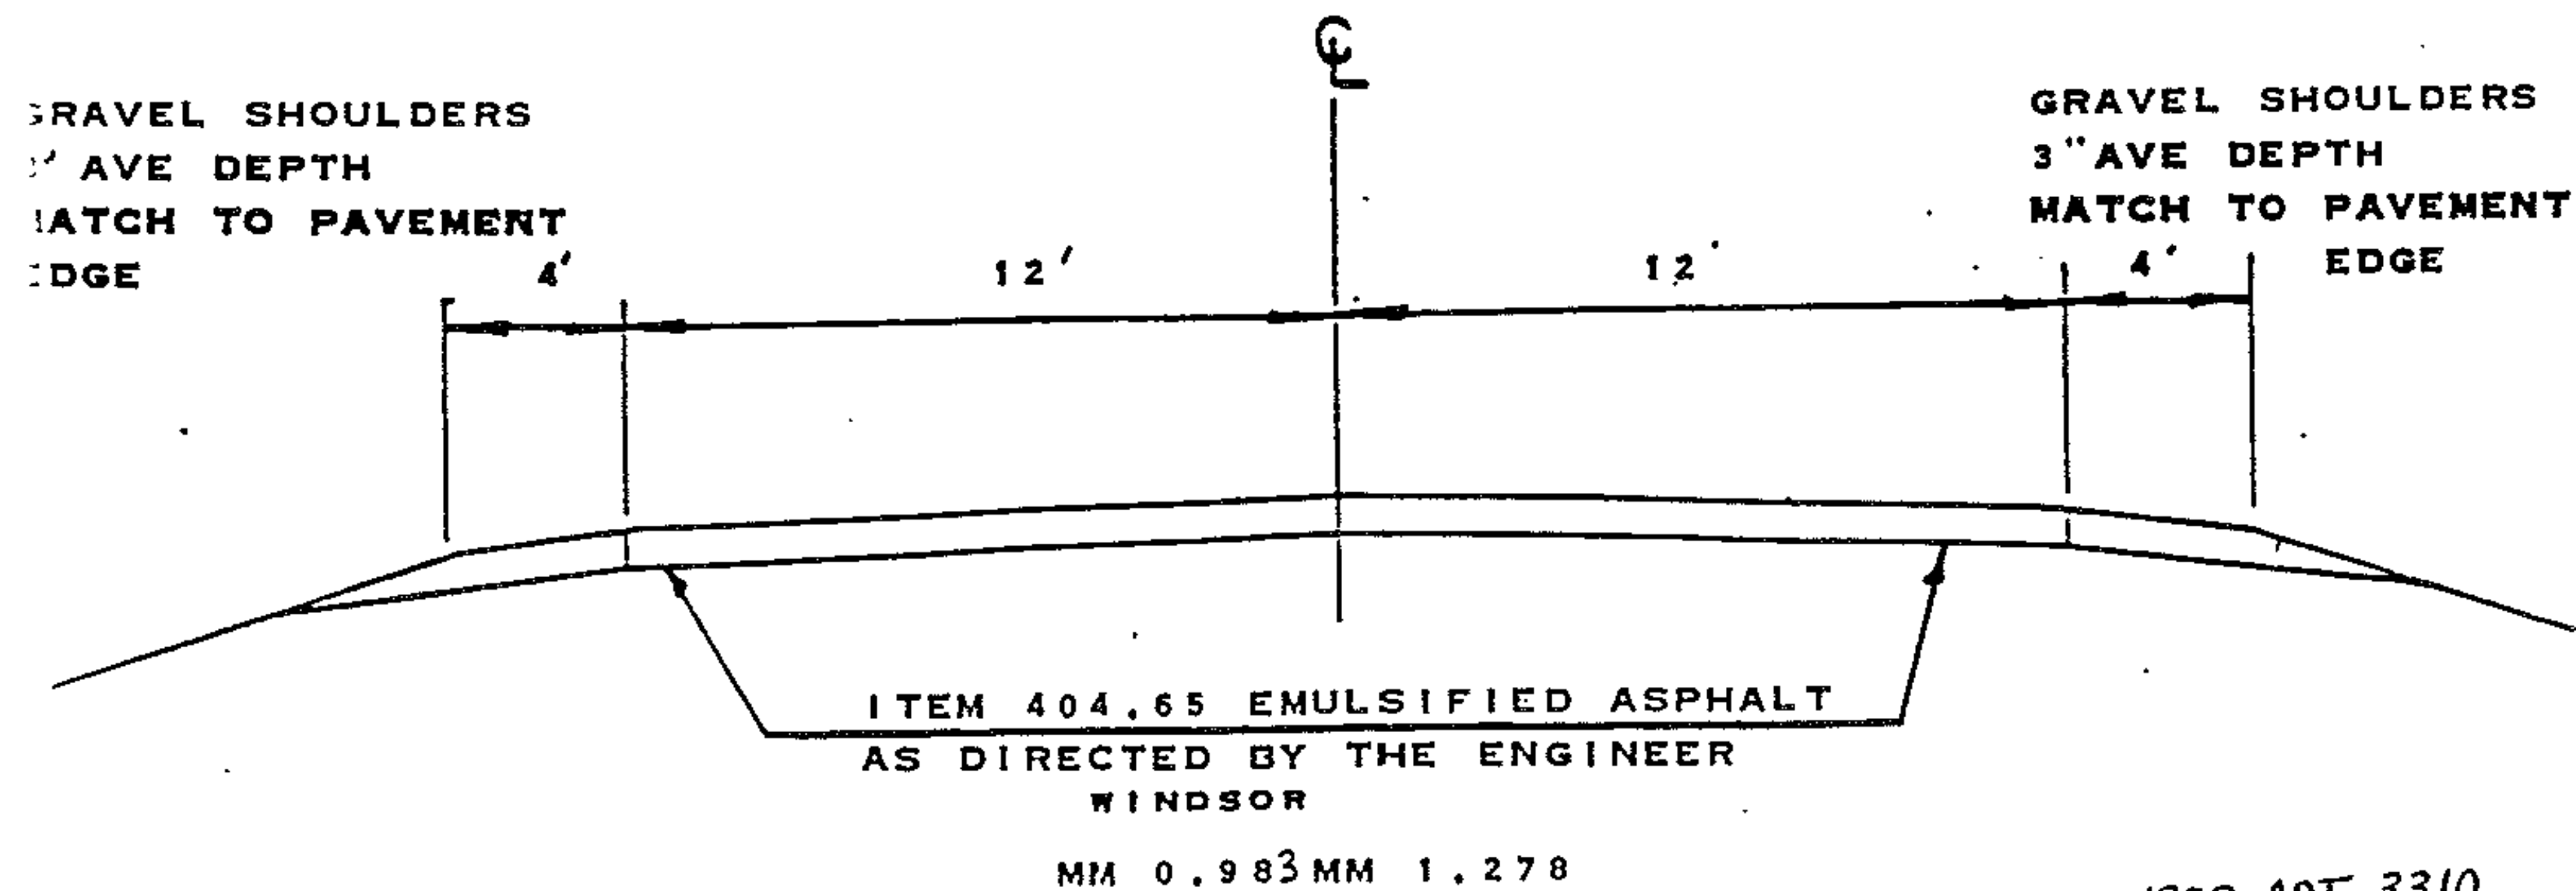

Note: Topsoil, Item 653.10 to be applied as directed by the Engineer.
 Seed, Fertilizer, Limestone and Mulch Items to be applied as required,
 payment to be subsidiary to the Topsoil item.

NO. HMA 2645

PROJECT WEATHERSFIELD-WINDSOR

SHEET 5 OF 12 SHEETS