


PROJECT DESCRIPTION AND LOCATION

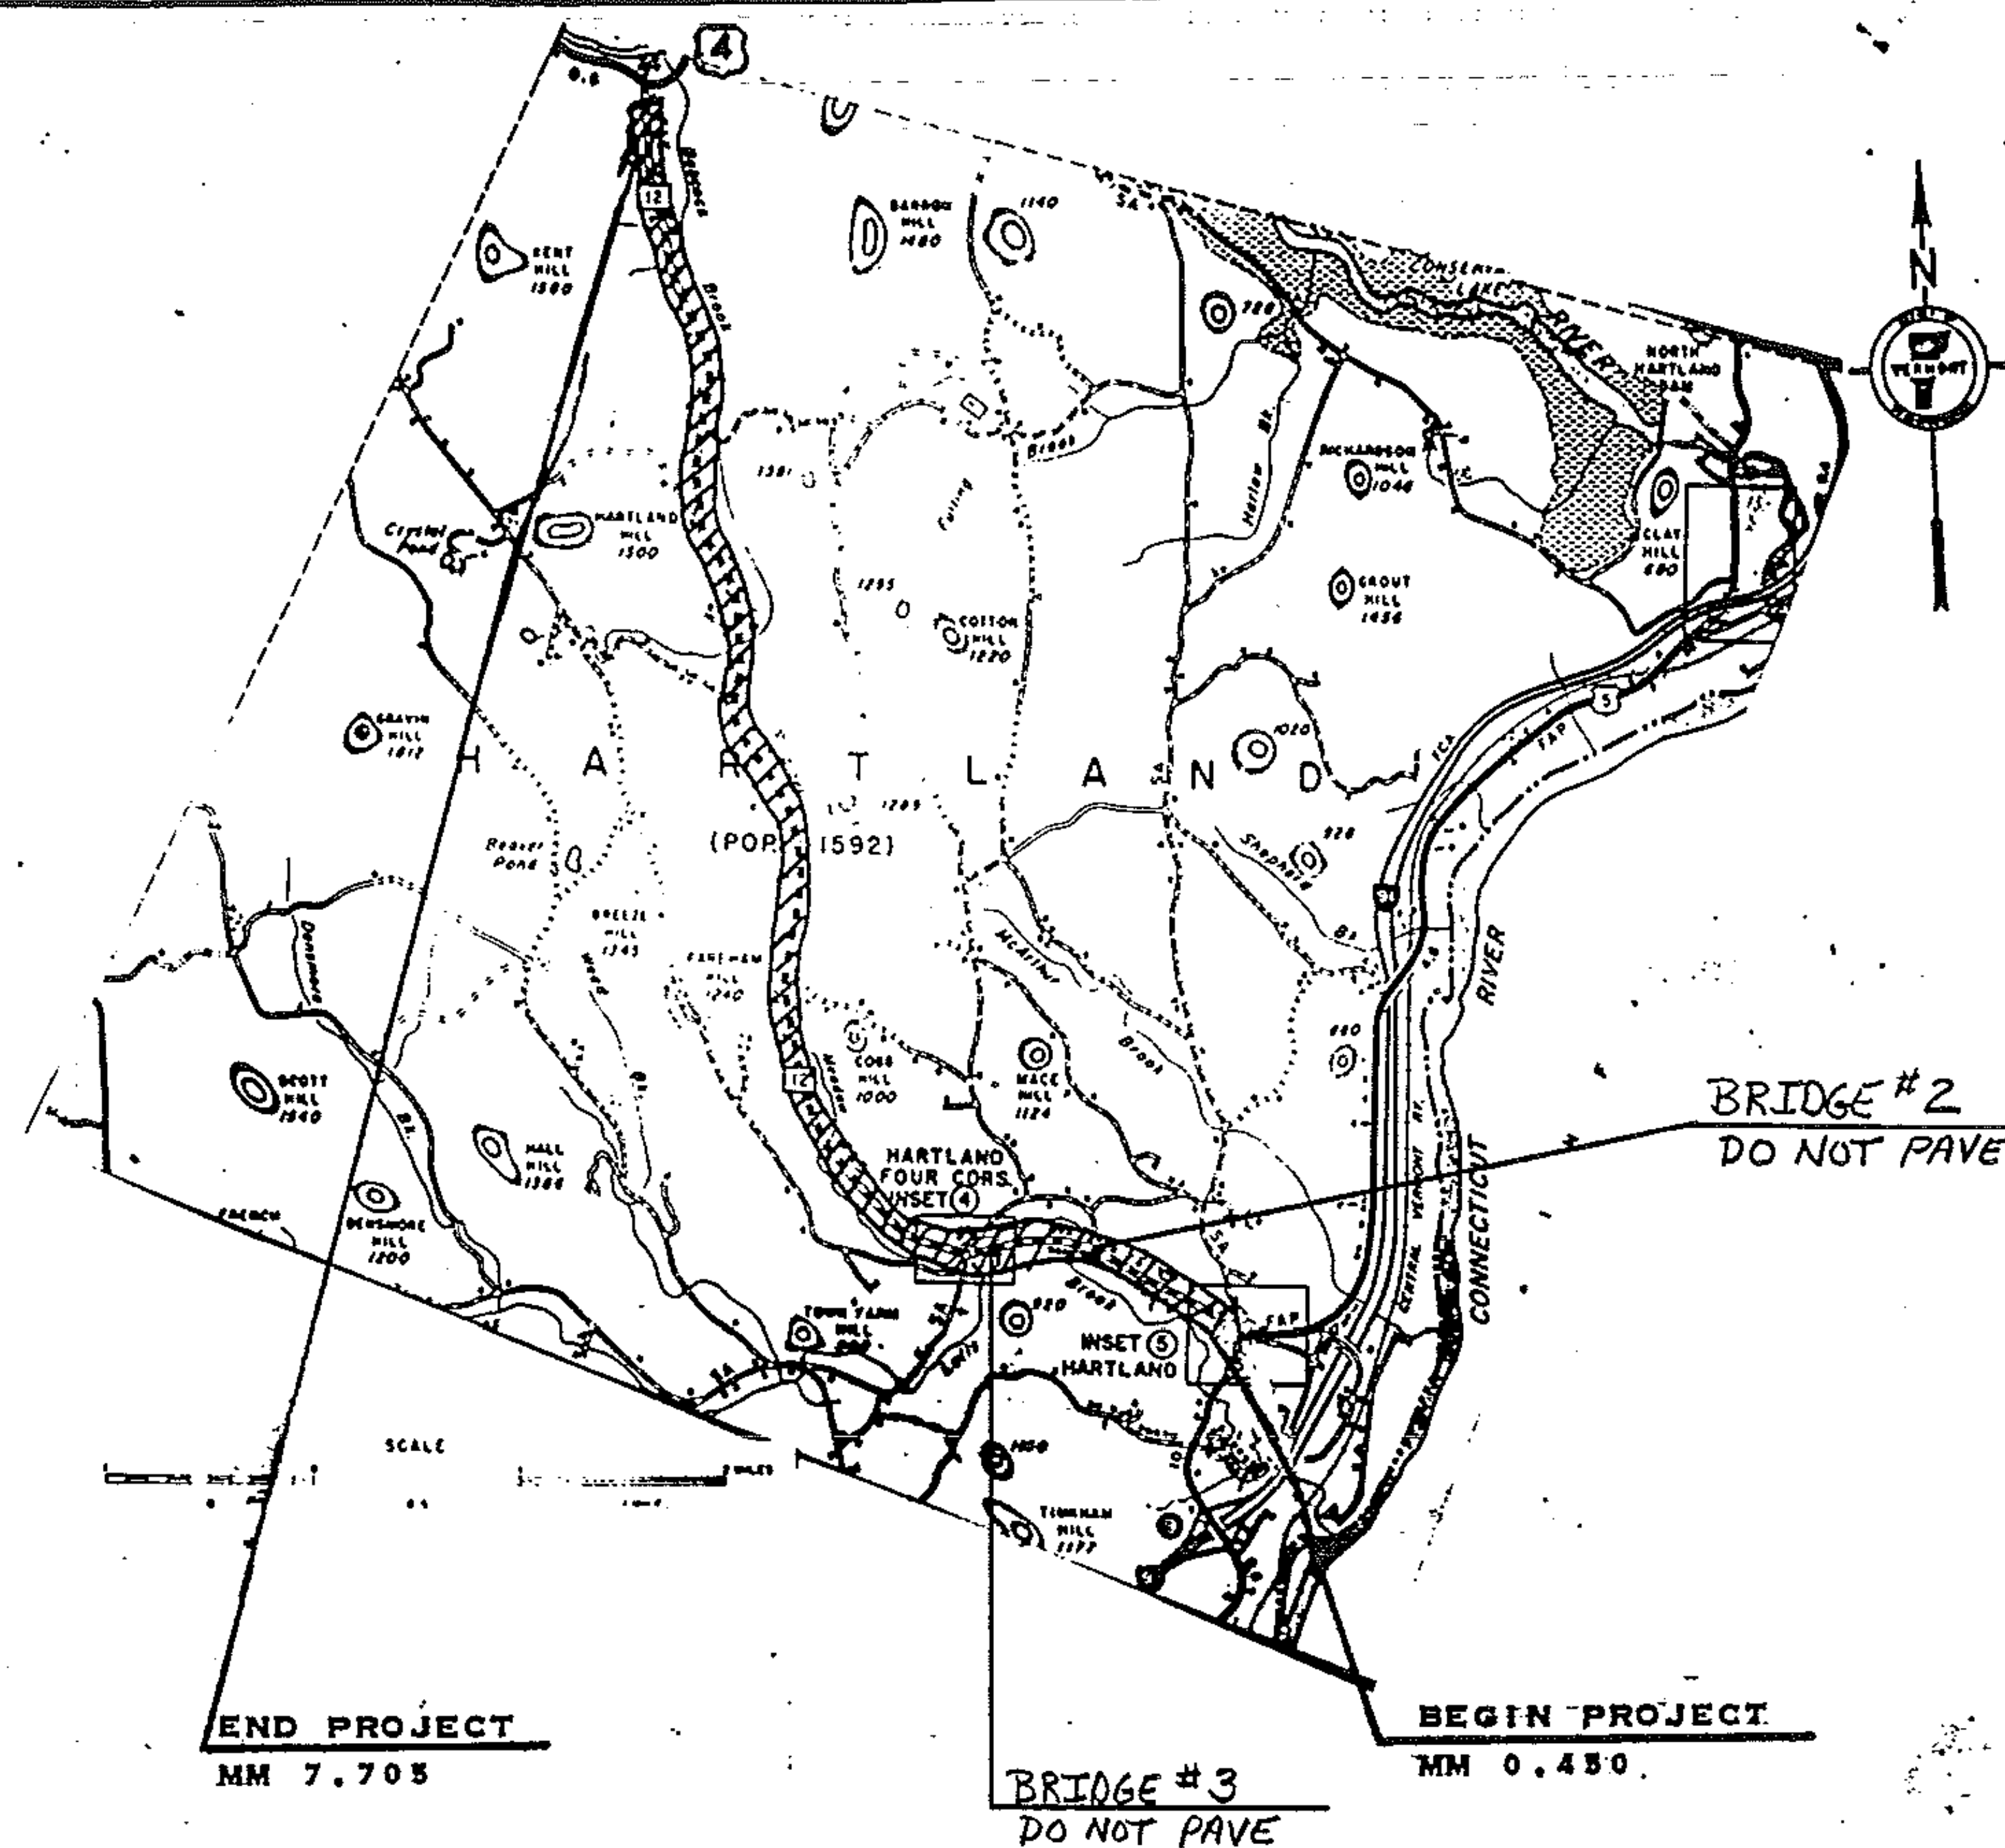

VT 12- BEGINNING IN THE TOWN OF HARTLAND AT MM 0.450 AND
EXTENDING NORTHERLY 7.255 MILES TO MM 7.705

LENGTH OF PROJECT
7.255 MILES
38306 FEET

PROJECT HARTLAND

NO. HMA 2616

SHEET 8 OF 27 SHEETS