


PROJECT DESCRIPTION AND LOCATION

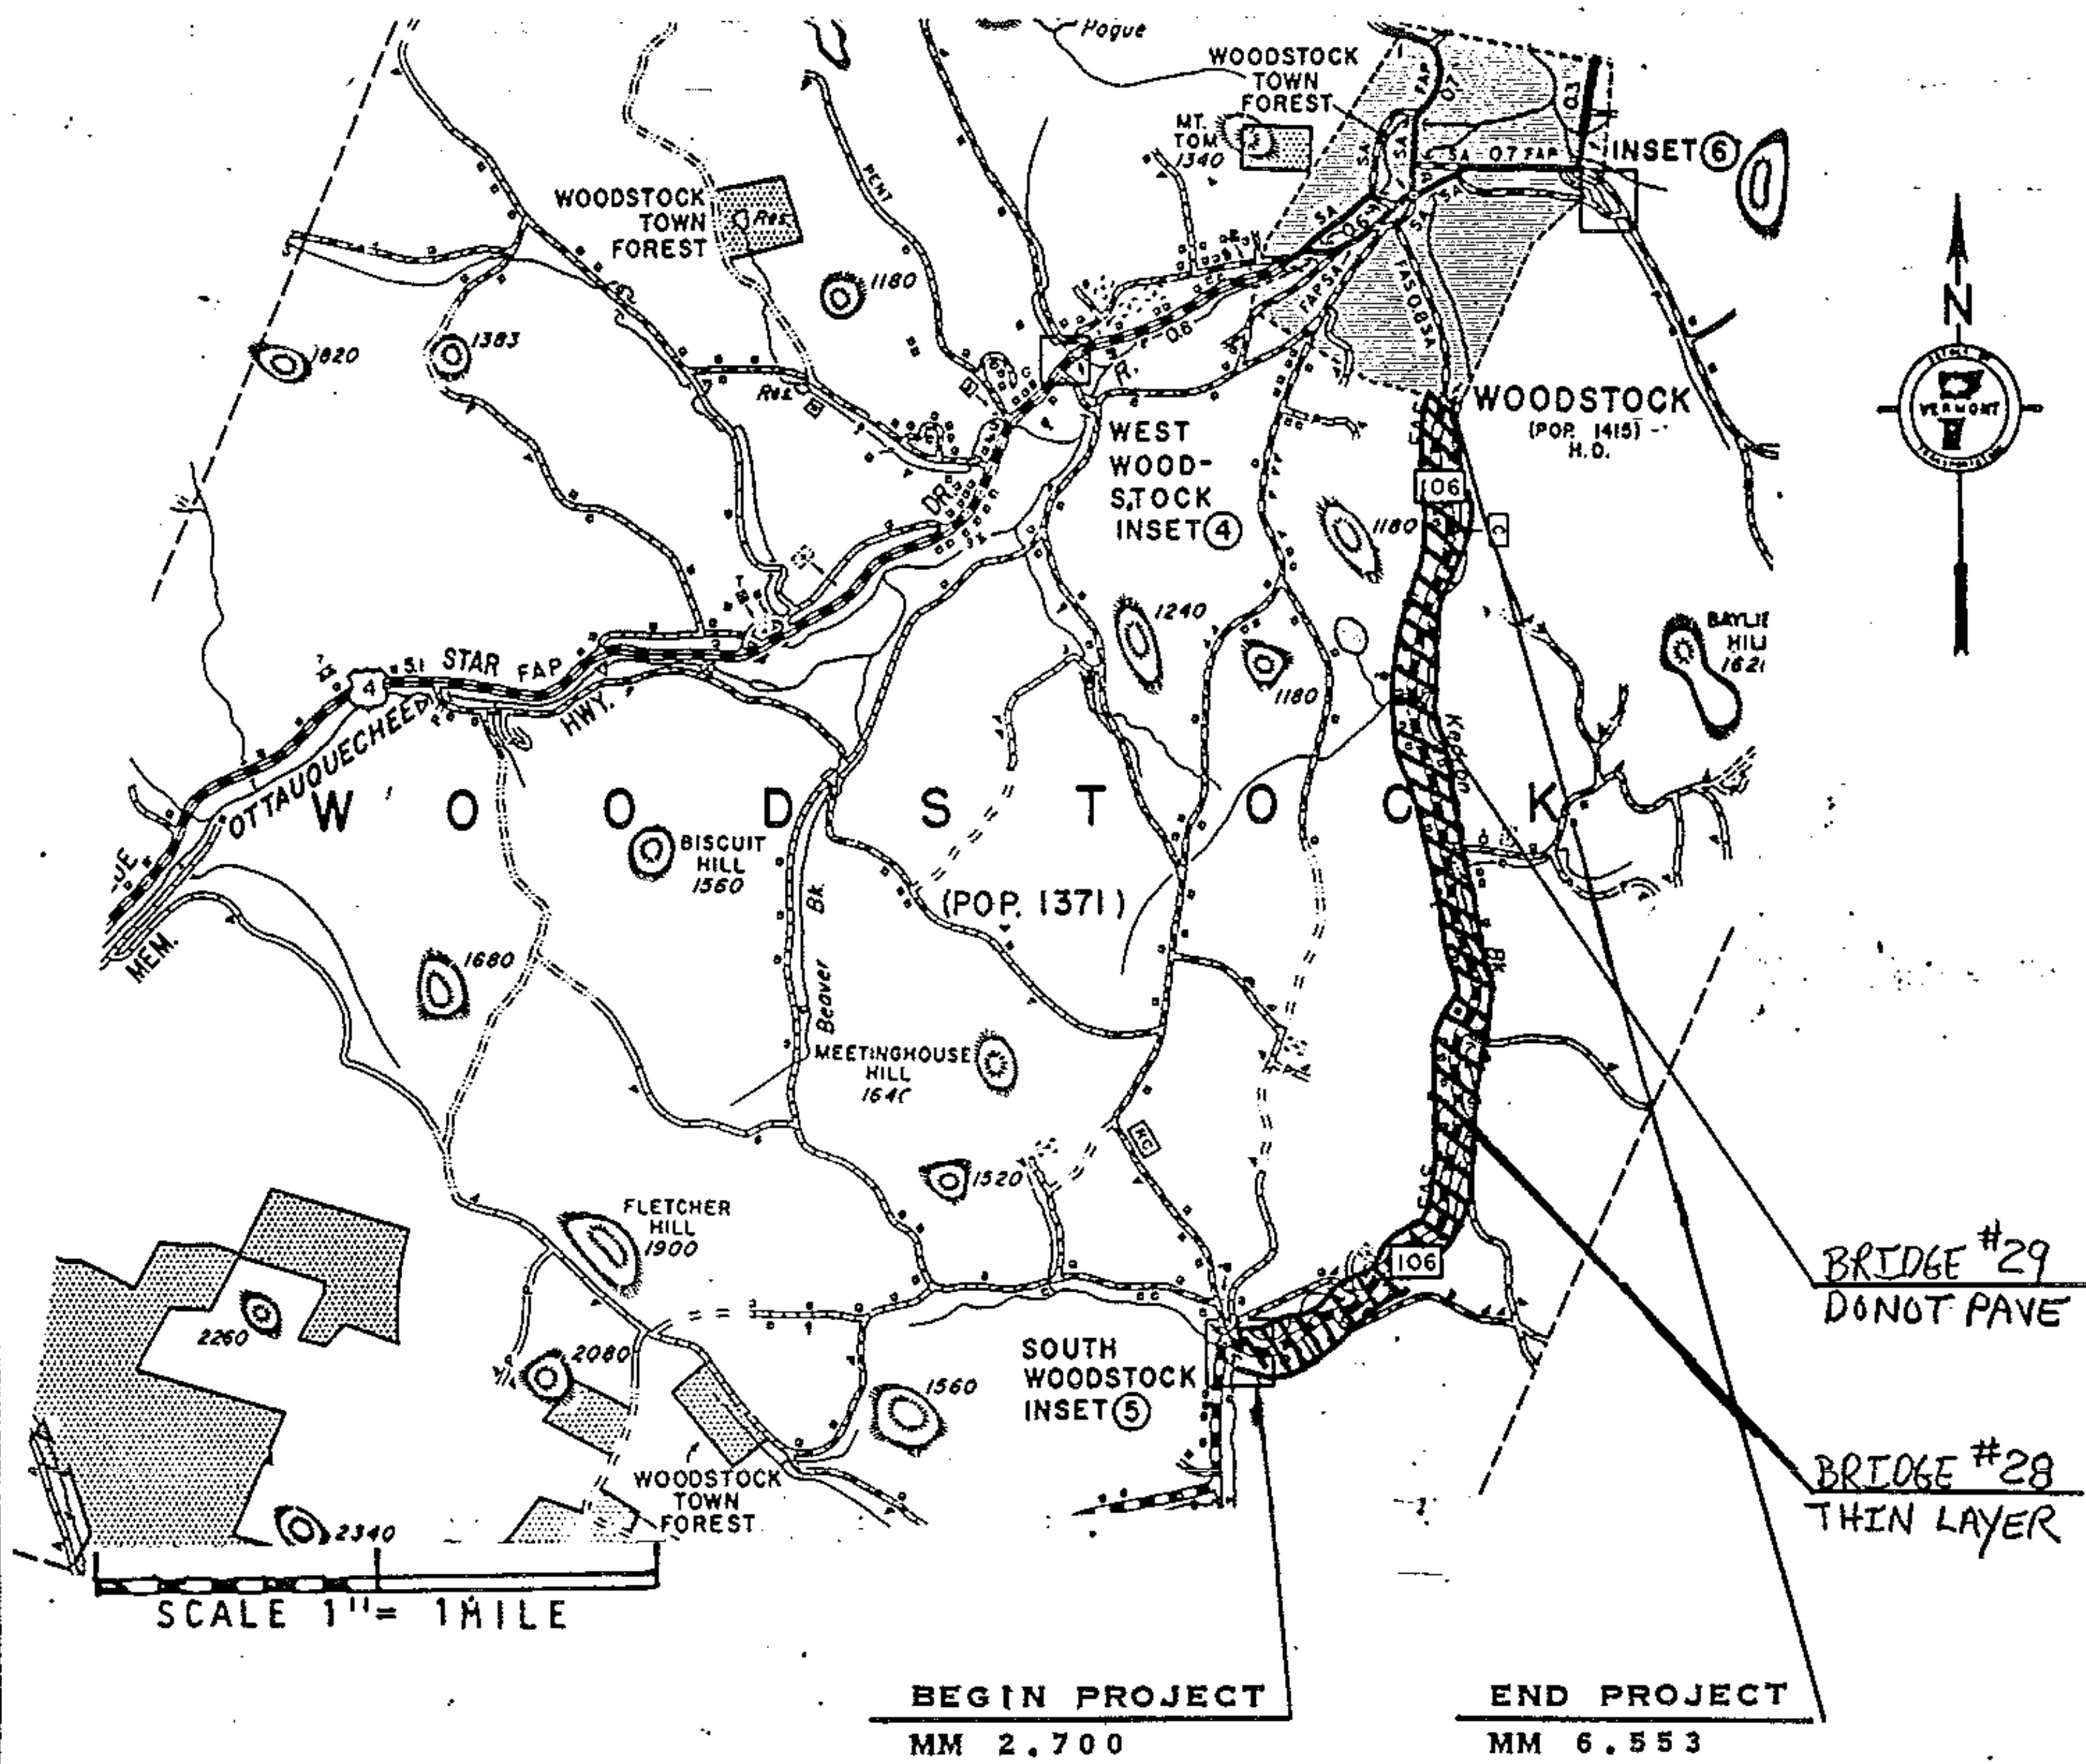

VT 106 - IN THE TOWN OF WOODSTOCK BEGINNING AT MM 2.700 AND EXTENDING 3.853 MILES TO MM 6.553

LENGTH OF PROJECT
3.853 MILES
20344 FEET

PROJECT <u>WOODSTOCK</u>	NO. <u>HMA 2617</u> SHEET <u>12</u> OF <u>27</u> SHEETS
--------------------------	--