


# DETAILS

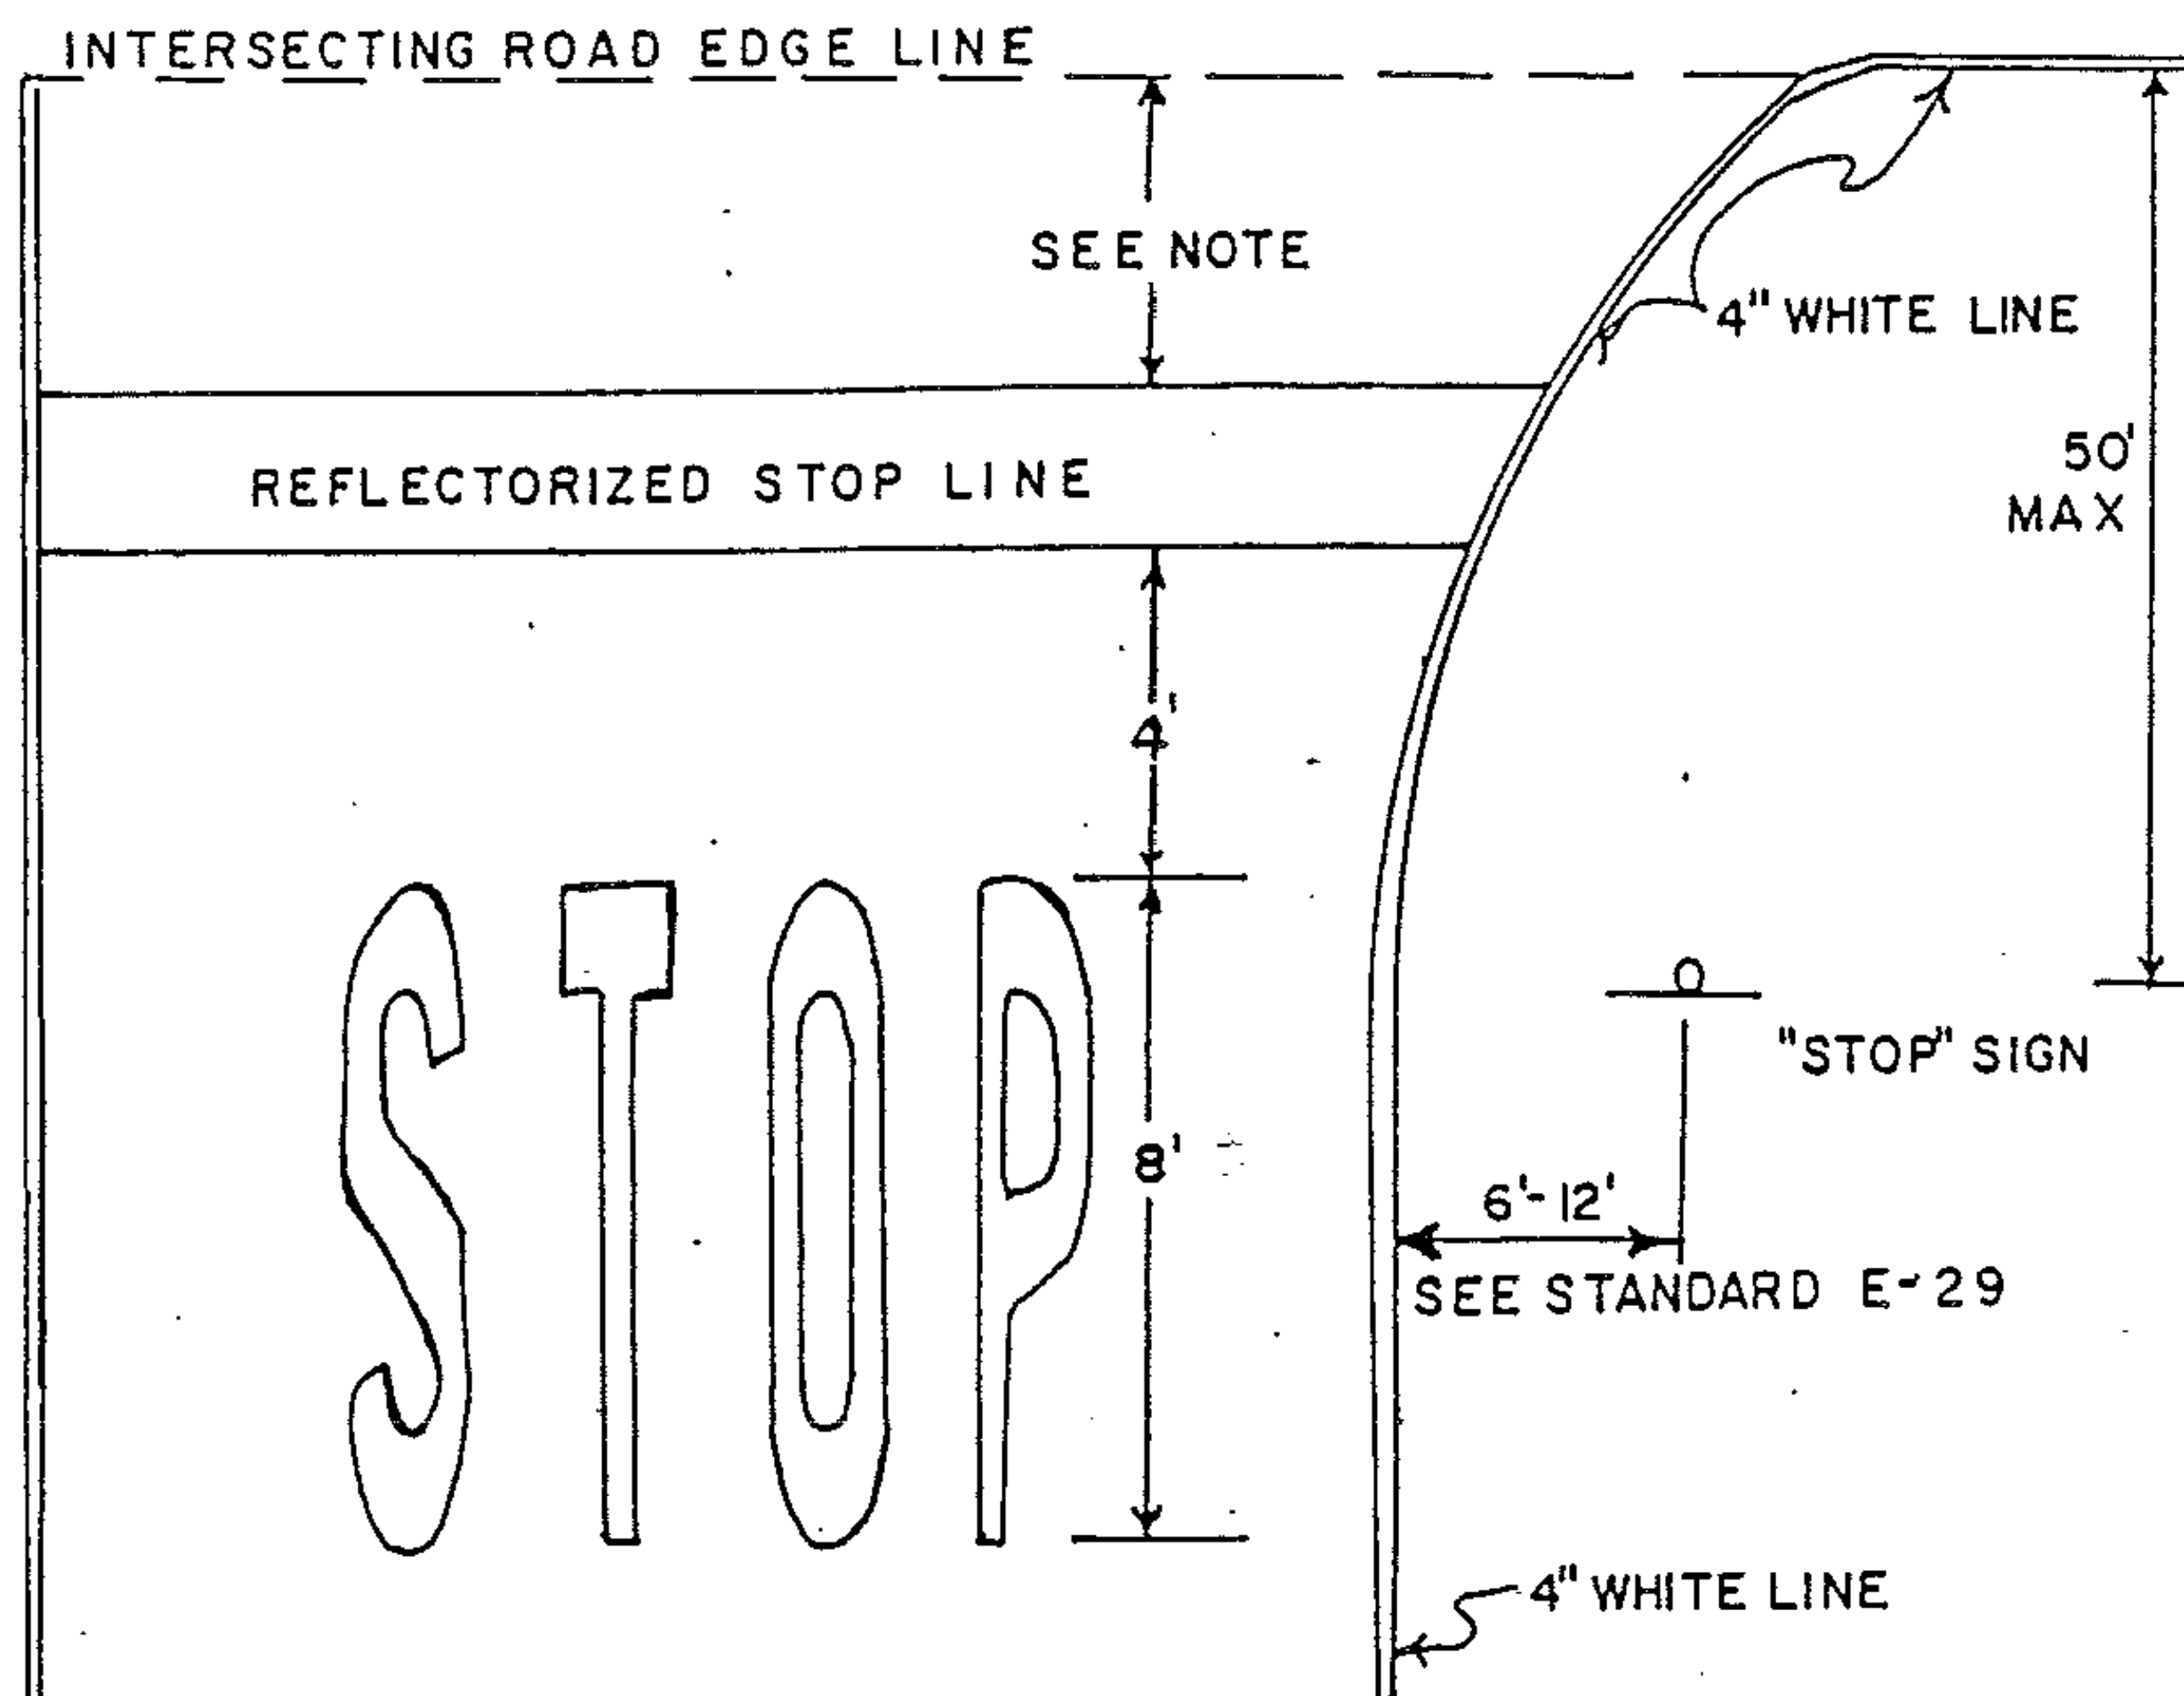

NOTE.

PAVEMENT MARKING DETAILS

1. THE STOP LINE SHOULD BE PLACED AT THE DESIRED STOPPING POINT, IN NO CASE MORE THAN 30 FEET OR LESS THAN 4' FROM THE NEAREST EDGE OF THE INTERSECTING ROADWAY.

PROJECT WEATHERSFIELD-WINDSOR  
HARTLAND

NO. HMA 2645  
HMA 2616  
SHEET 21 OF 27 SHEETS