


* Centerline treatment shall consist of a minimum of 400 feet of solid line in advance of the intersection and shall be paired with either a solid or dashed line depending on sight distance availability in the opposing lane.

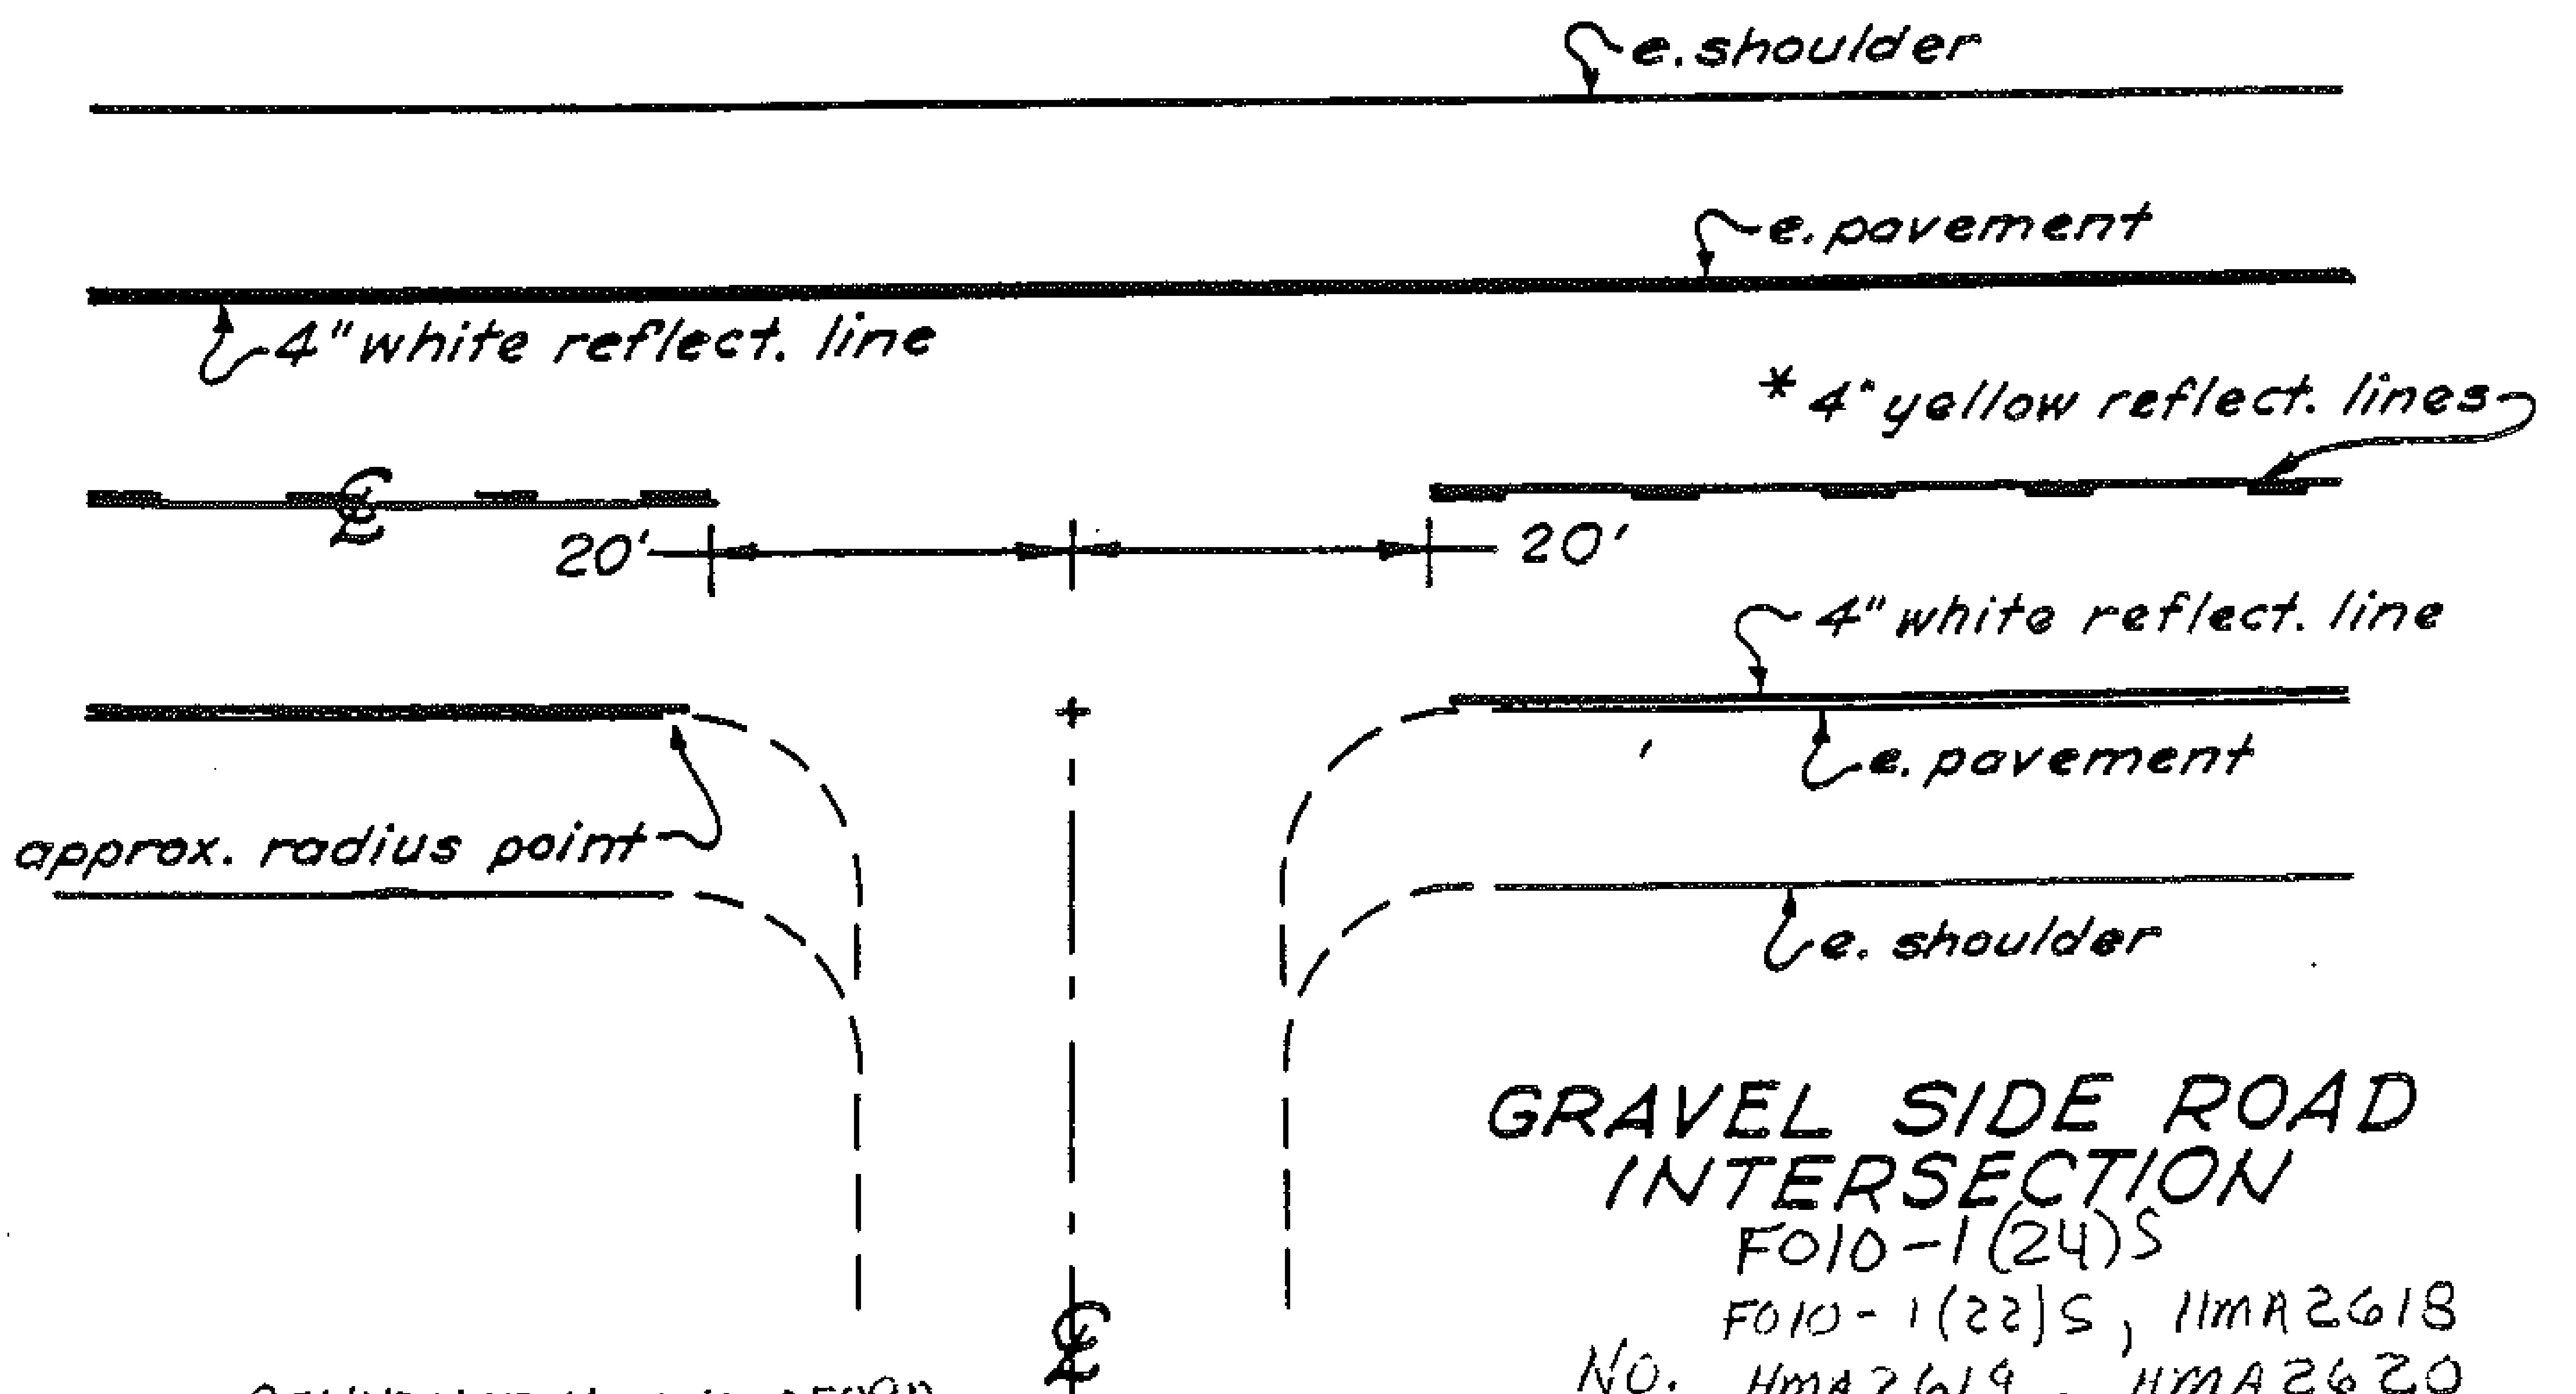

GRAVEL SIDE ROAD INTERSECTION

F010-1(24)S
 F010-1(22)S, HMA 2618
 NO. HMA 2619, HMA 2620

BENNINGTON - WOODFORD

PROJECT: SEARCUMS - WILMINGTON - SHAFTELDAY

SHEET 6 OF 50 SHEETS