


RAMP A ADT 1982 285  
V=35

RAMP H ADT 1982 1370  
V=35

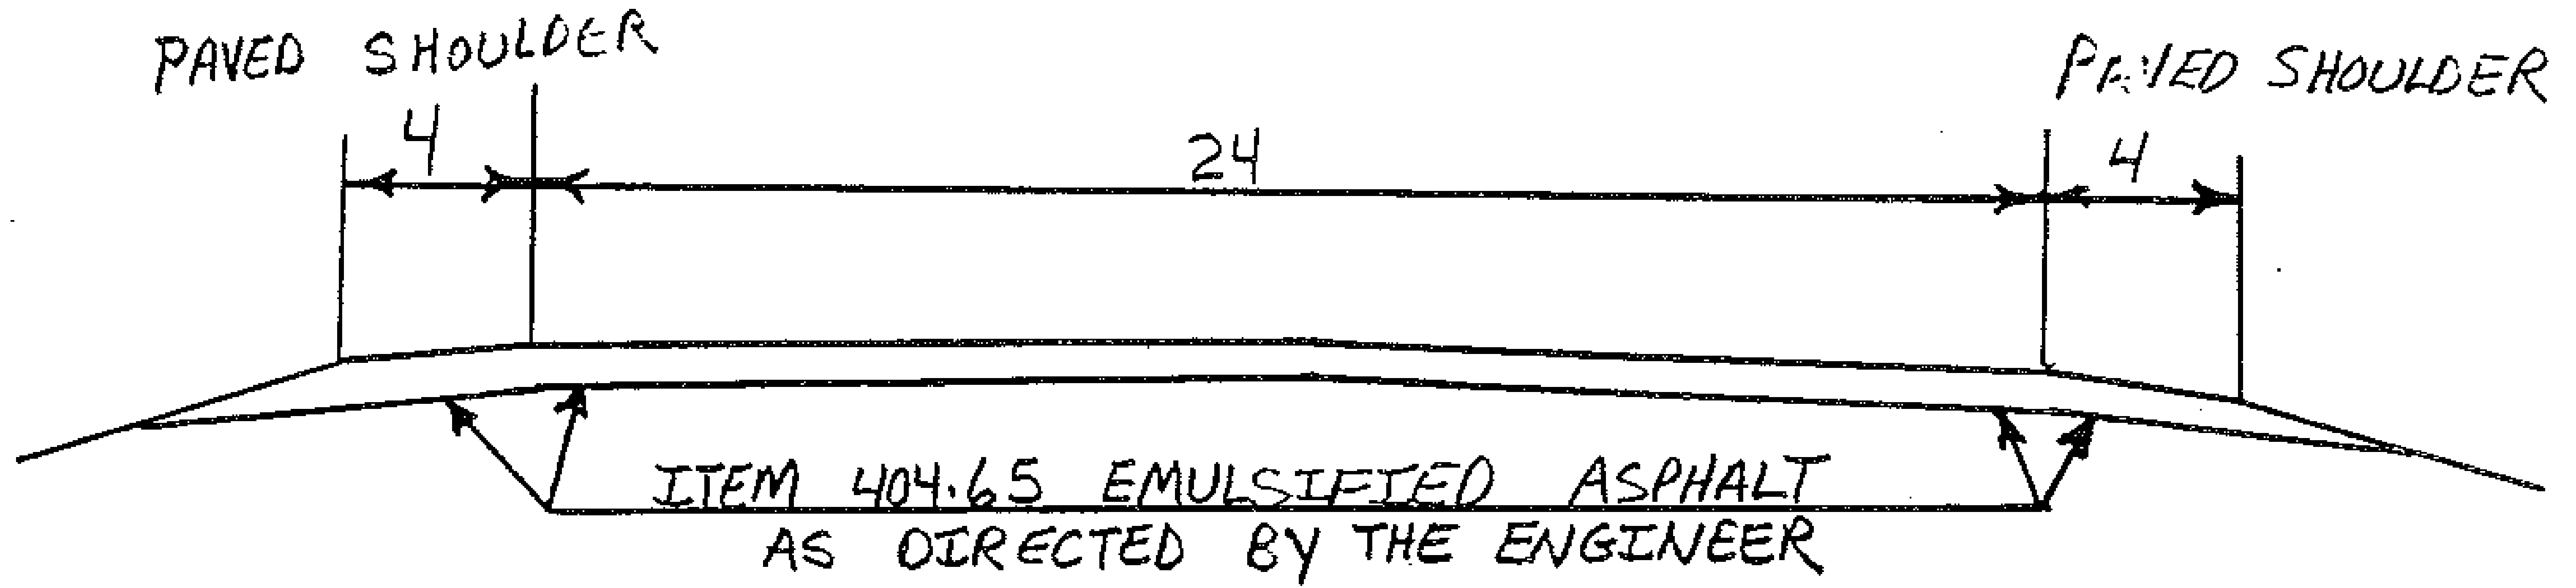

RAMP A MM 0.445 ~ MM 0.836

PROJECT BENNINGTON

NO. F019-1(22)S  
SHEET 9A OF 50