
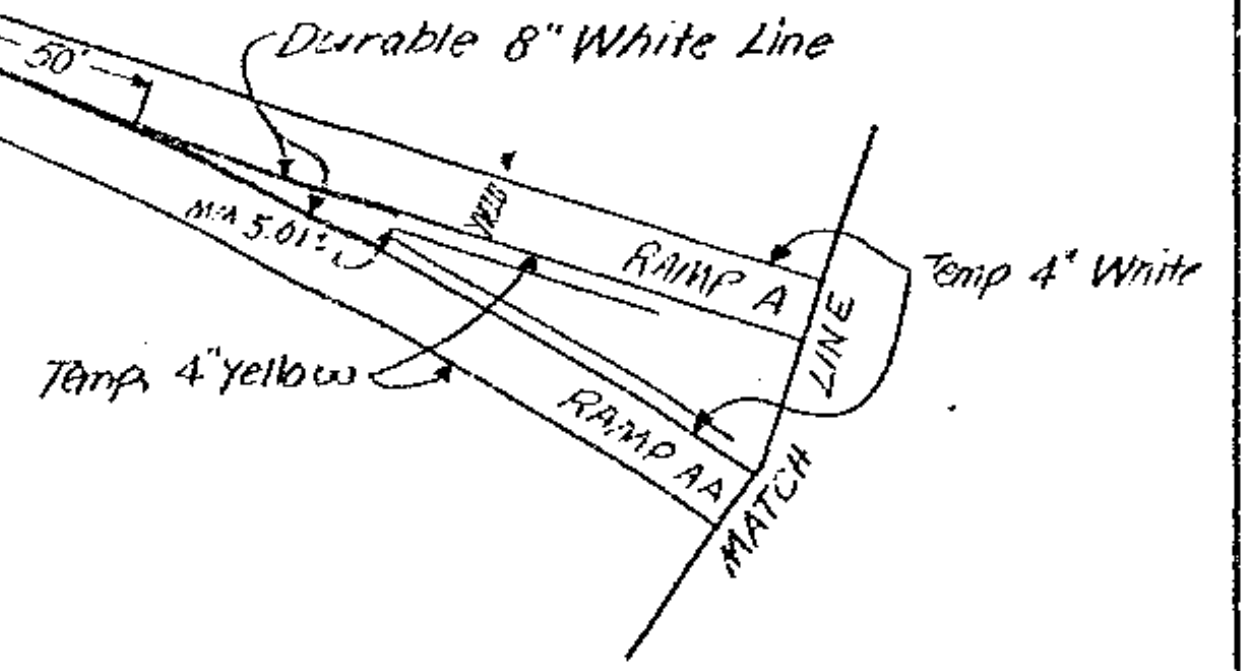
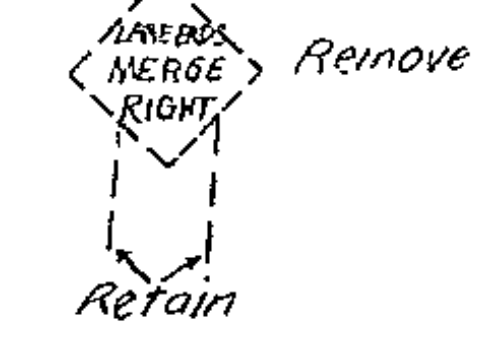
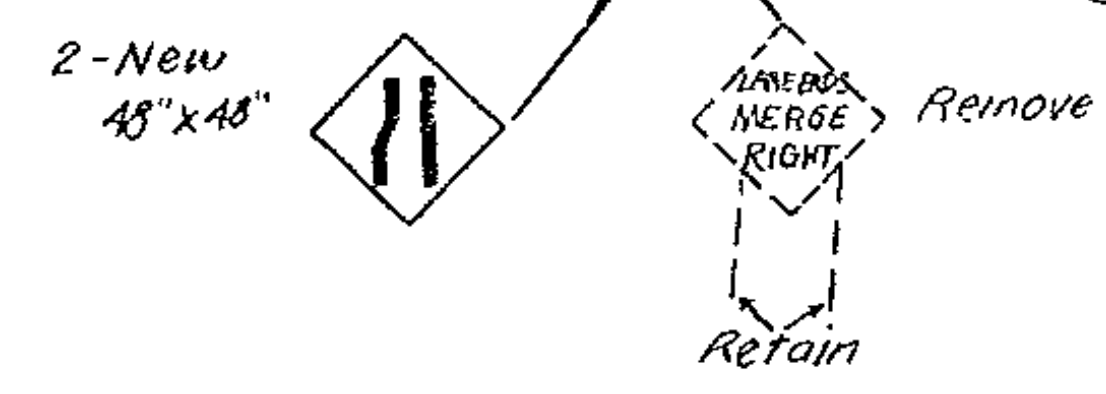
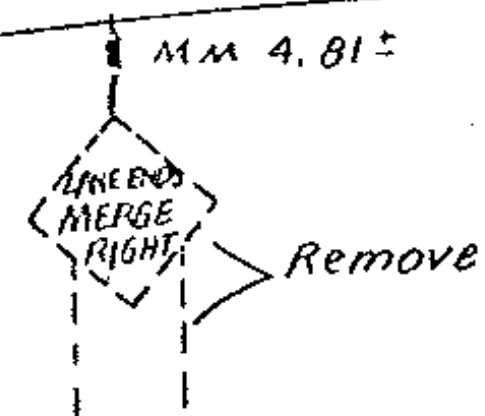


Temp. 4" White Line  
 Edgelines - Rt.  
 Centerline - Dashed As Shown

Temp. 4" Yellow Line  
 Edgelines - Lt.


Durable 8" White Line  
 Ramp A & AA Gore - As Shown

Durable Letter In Word Markings  
 Ramp A ~ 'YIELD'

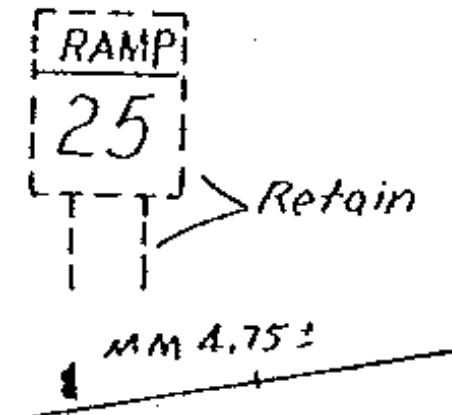

US 7 SB

DATUM	_____
VERTICAL	_____
HORIZONTAL	_____

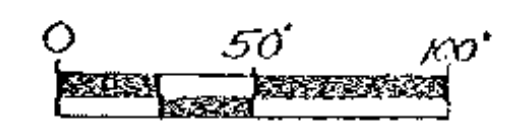

SURVEYED BY _____	DATE _____
DRAWN BY <u>J.B.</u>	DATE <u>6-85</u>
TRACED BY <u>J.B.</u>	DATE <u>6-85</u>
BENNINGTON	
PROJ. F	NO. 019-1(22)5
SHEET 12A OF 50	