


MM 8.600 ~ MM 1.010

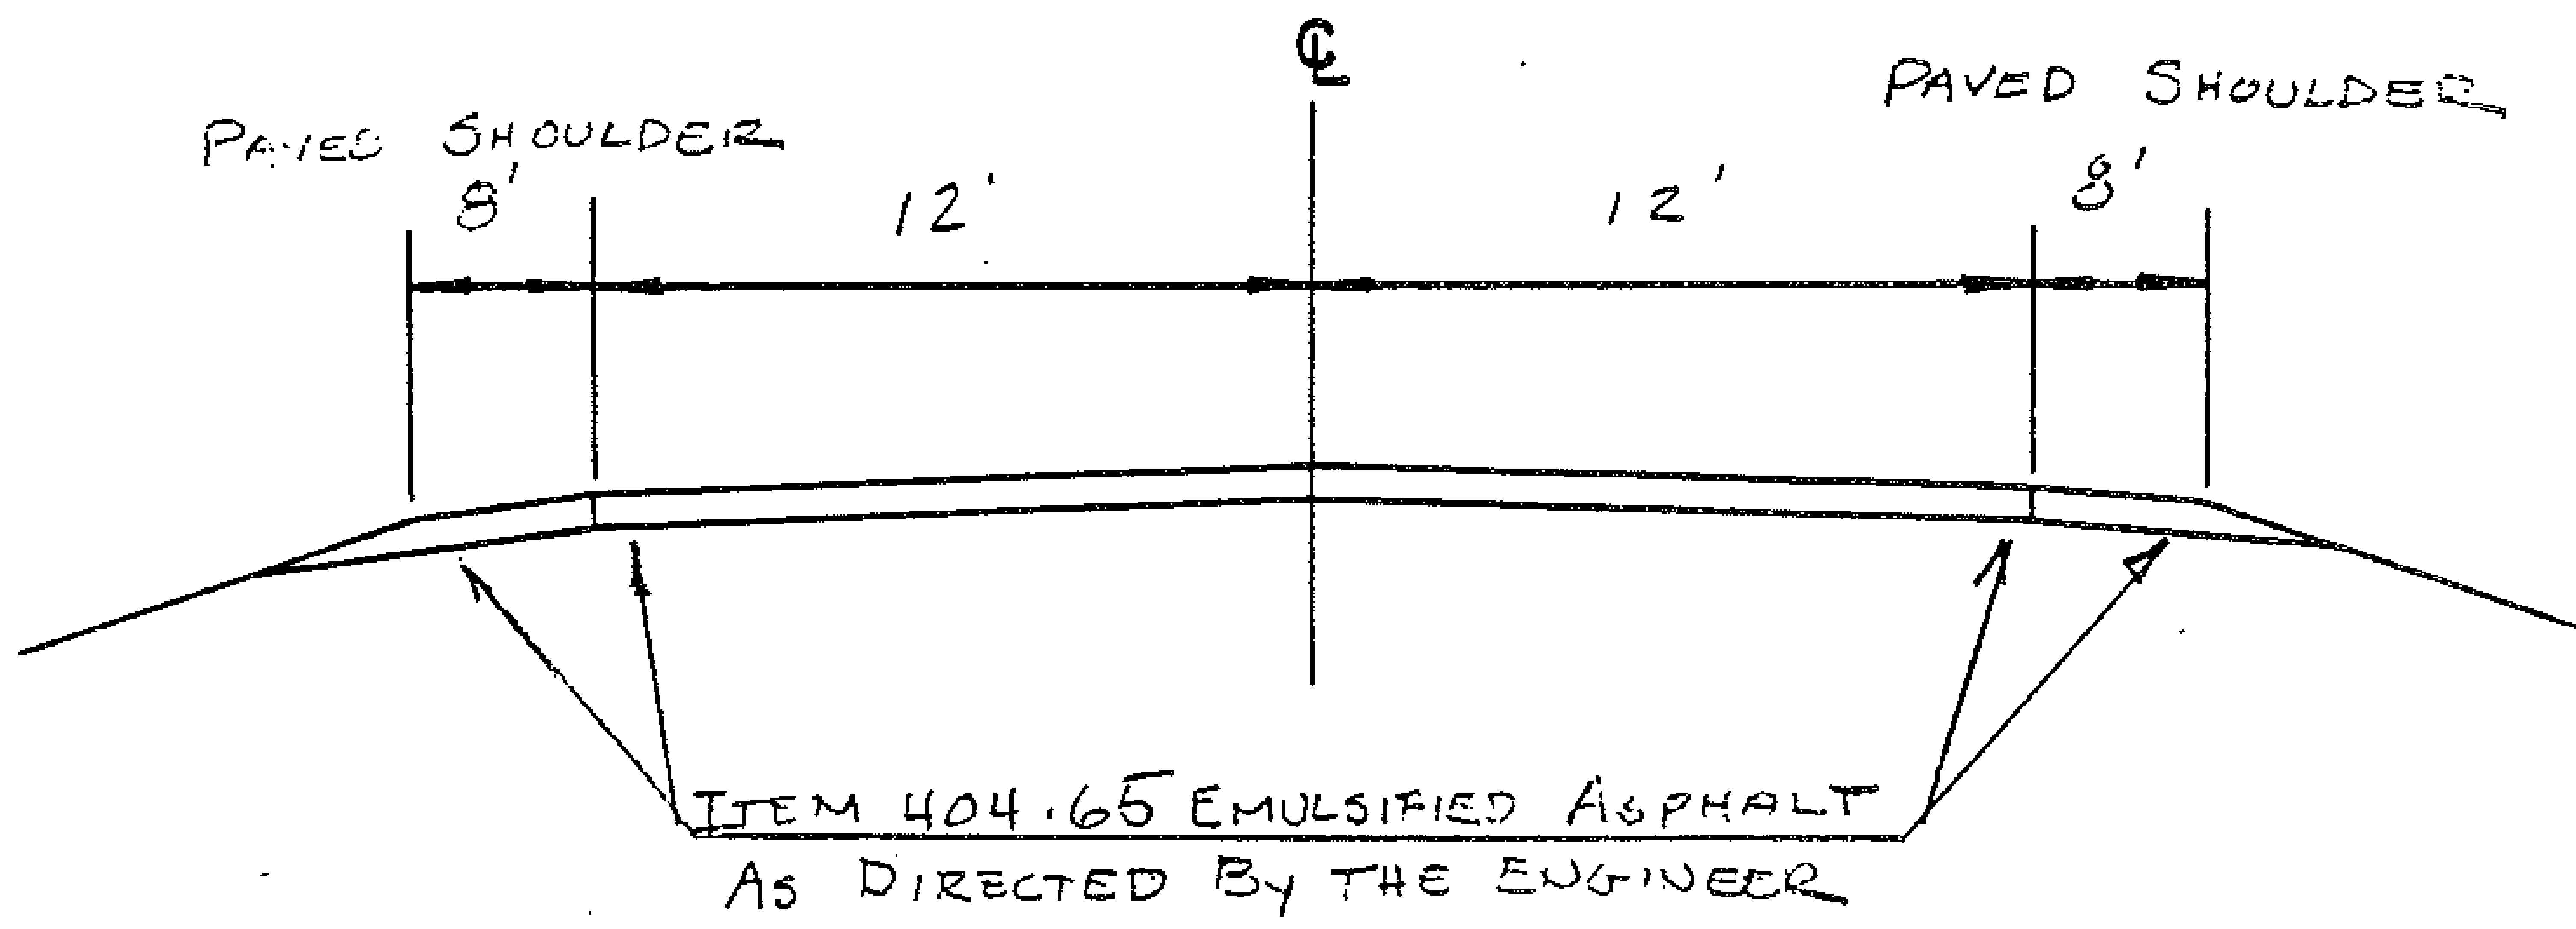

PROJECT WOODFORD - SCARBOROUGH

NO. F010-1(24)S
SHEET 22 OF 50