


ITEM 406.25 BITUMINOUS CONCRETE PAVEMENT
LEVELING COURSE TYPE III OR IV (218 TONS/MILE)
AS DIRECTED BY THE ENGINEER
3/4" WEARING COURSE TYPE IV (±1/4")

PAVED SHOULDER

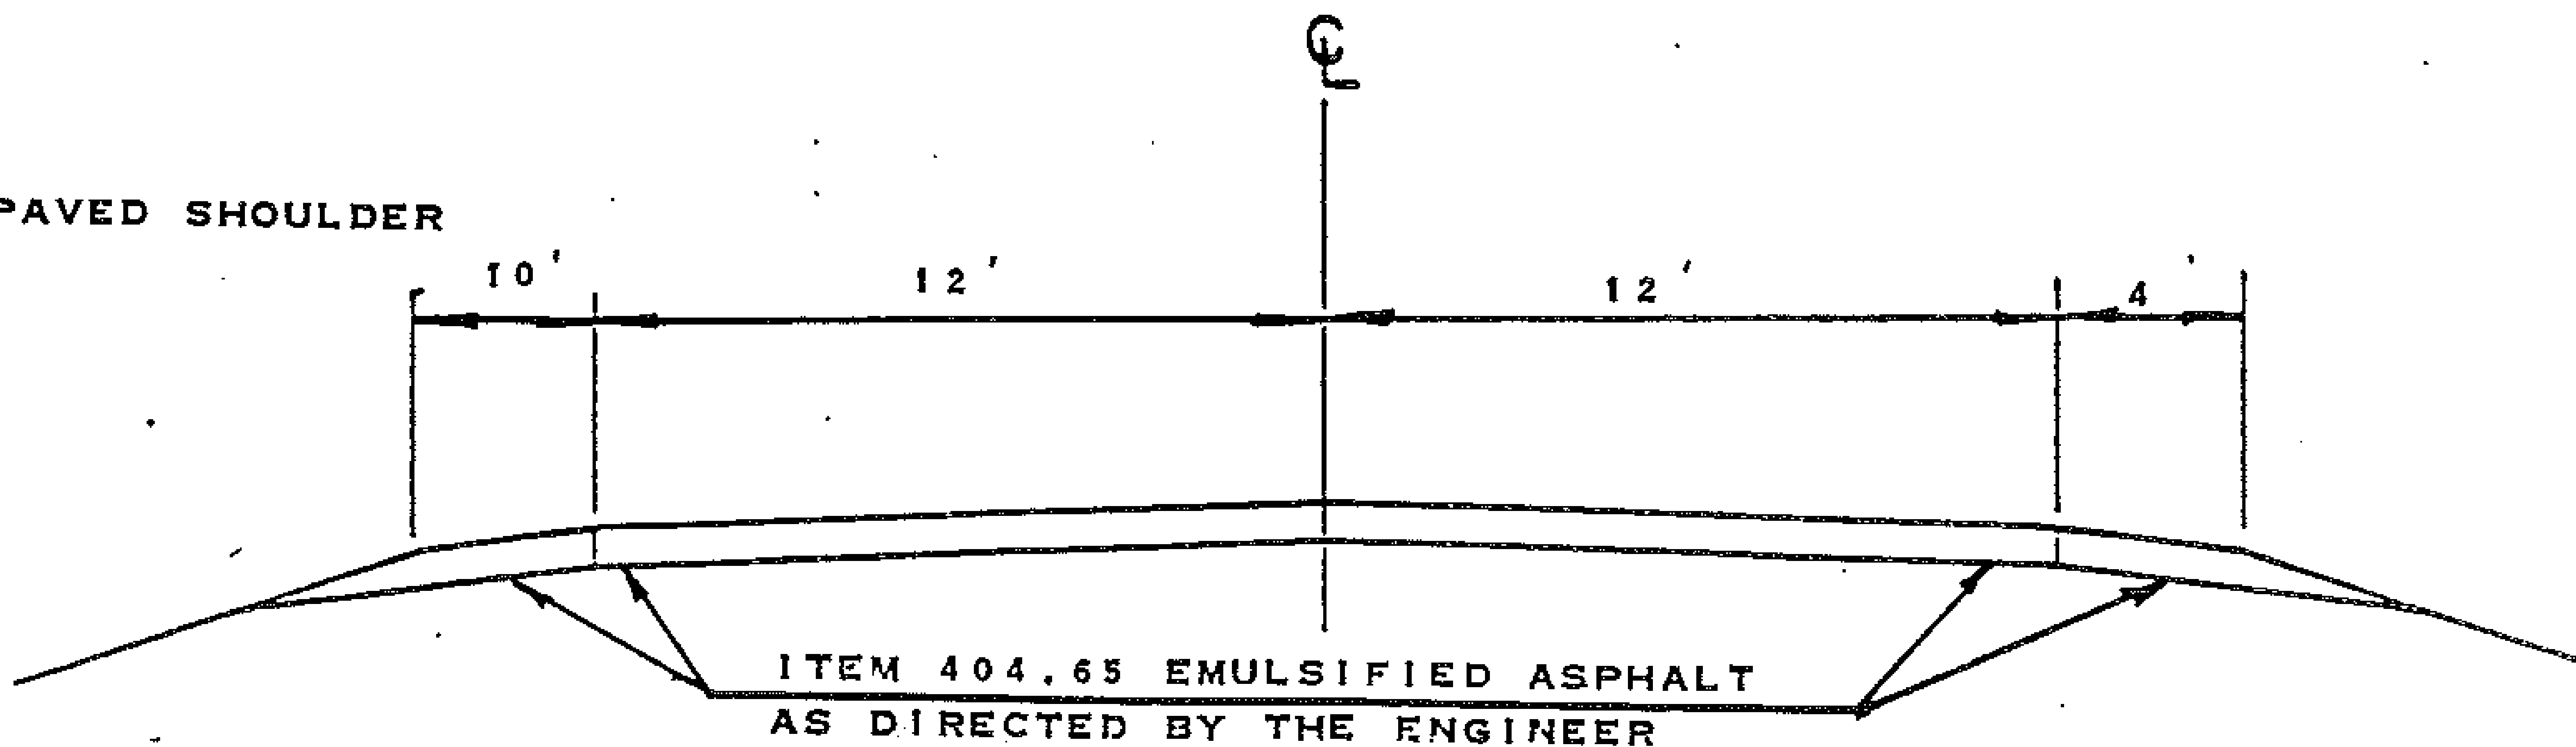

ITEM 404.65 EMULSIFIED ASPHALT
AS DIRECTED BY THE ENGINEER

BENNINGTON MM 0.250-MM 0.779
EAST BOUND

1982 ADT 1970
V 50

PROJECT

BENNINGTON - VT 67A CONN.

NO. HMA 2620

SHEET 35 OF 50 SHEETS