


Turn Lane and Painted Curb Detail

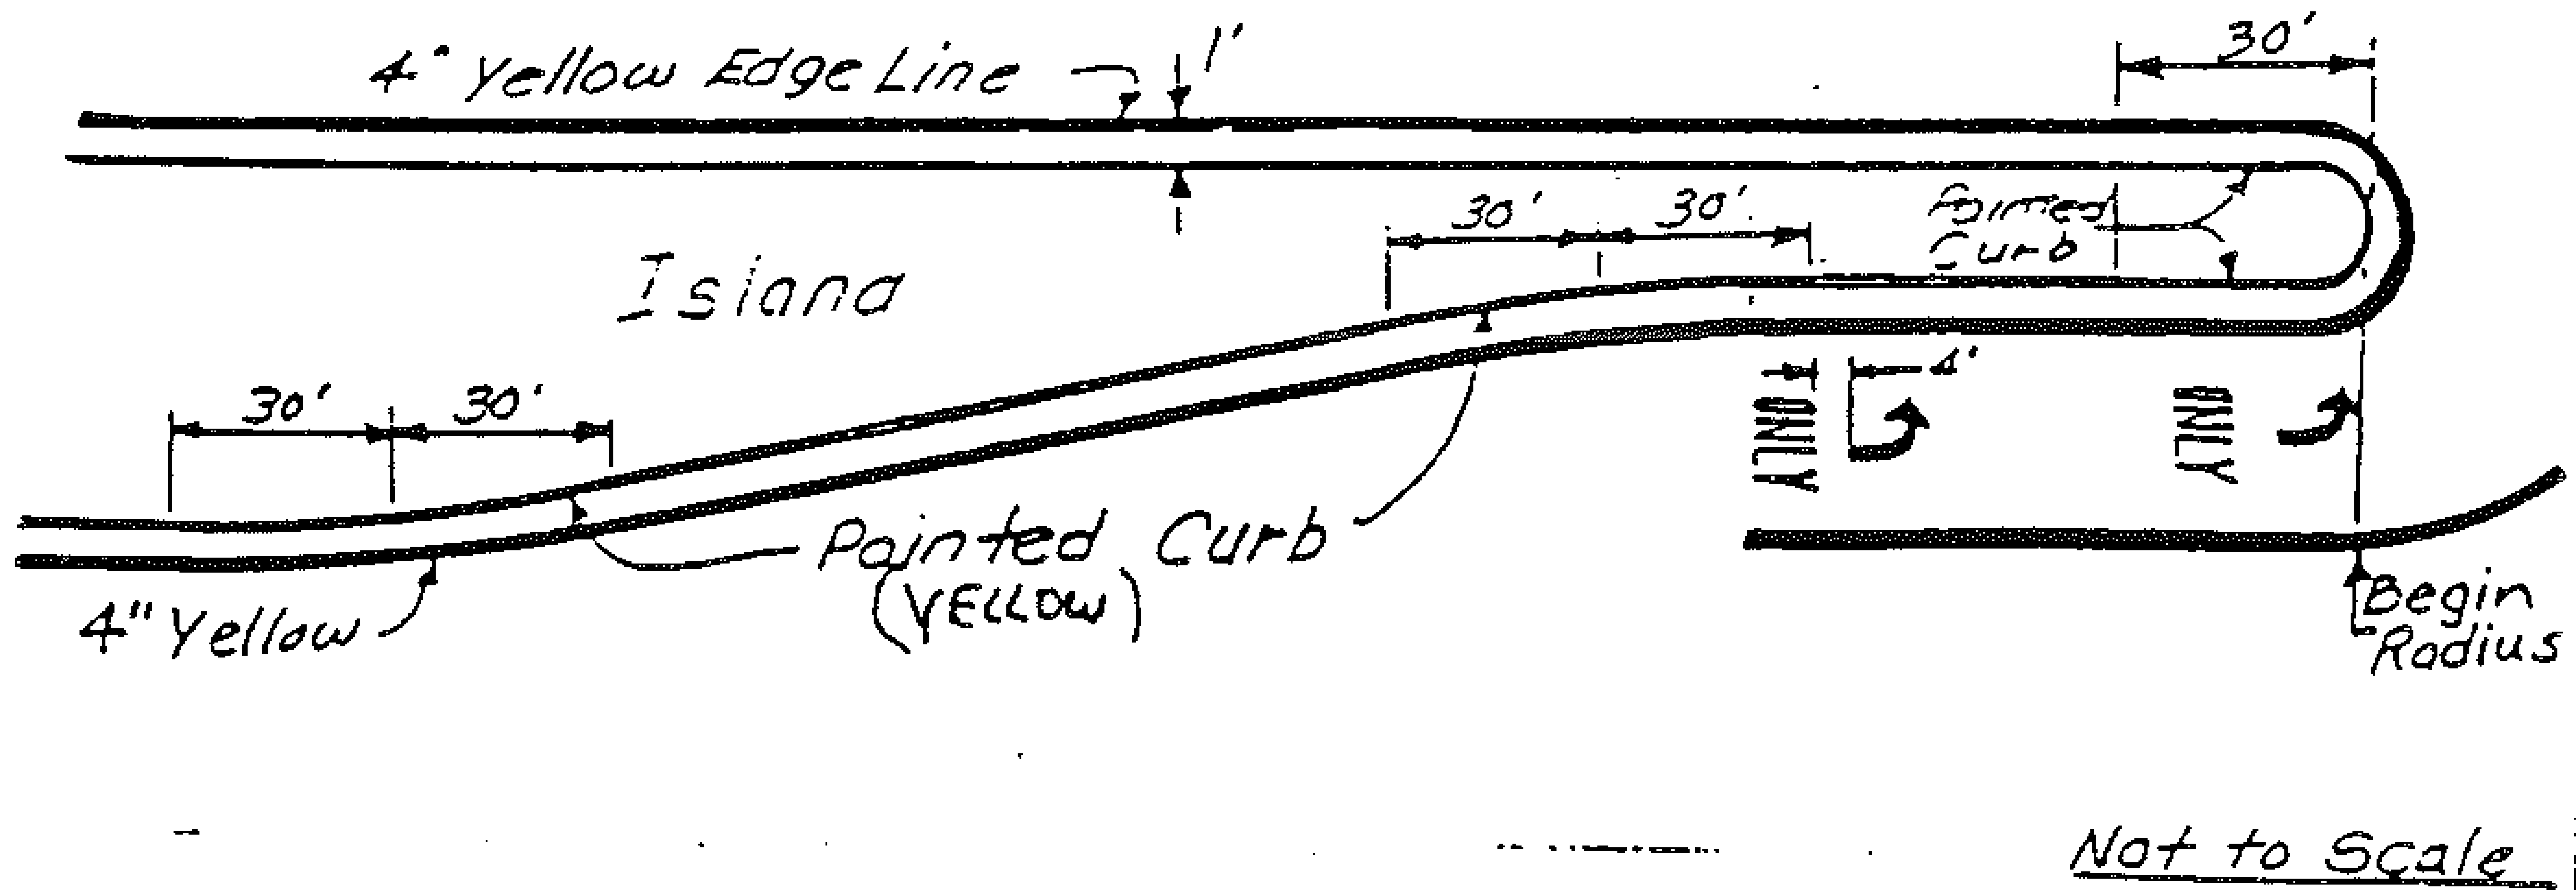

PROJECT: BENNINGTON V4.67A CONN.

No. HMA 21.20
SHEET 39 OF 50 SHEETS