


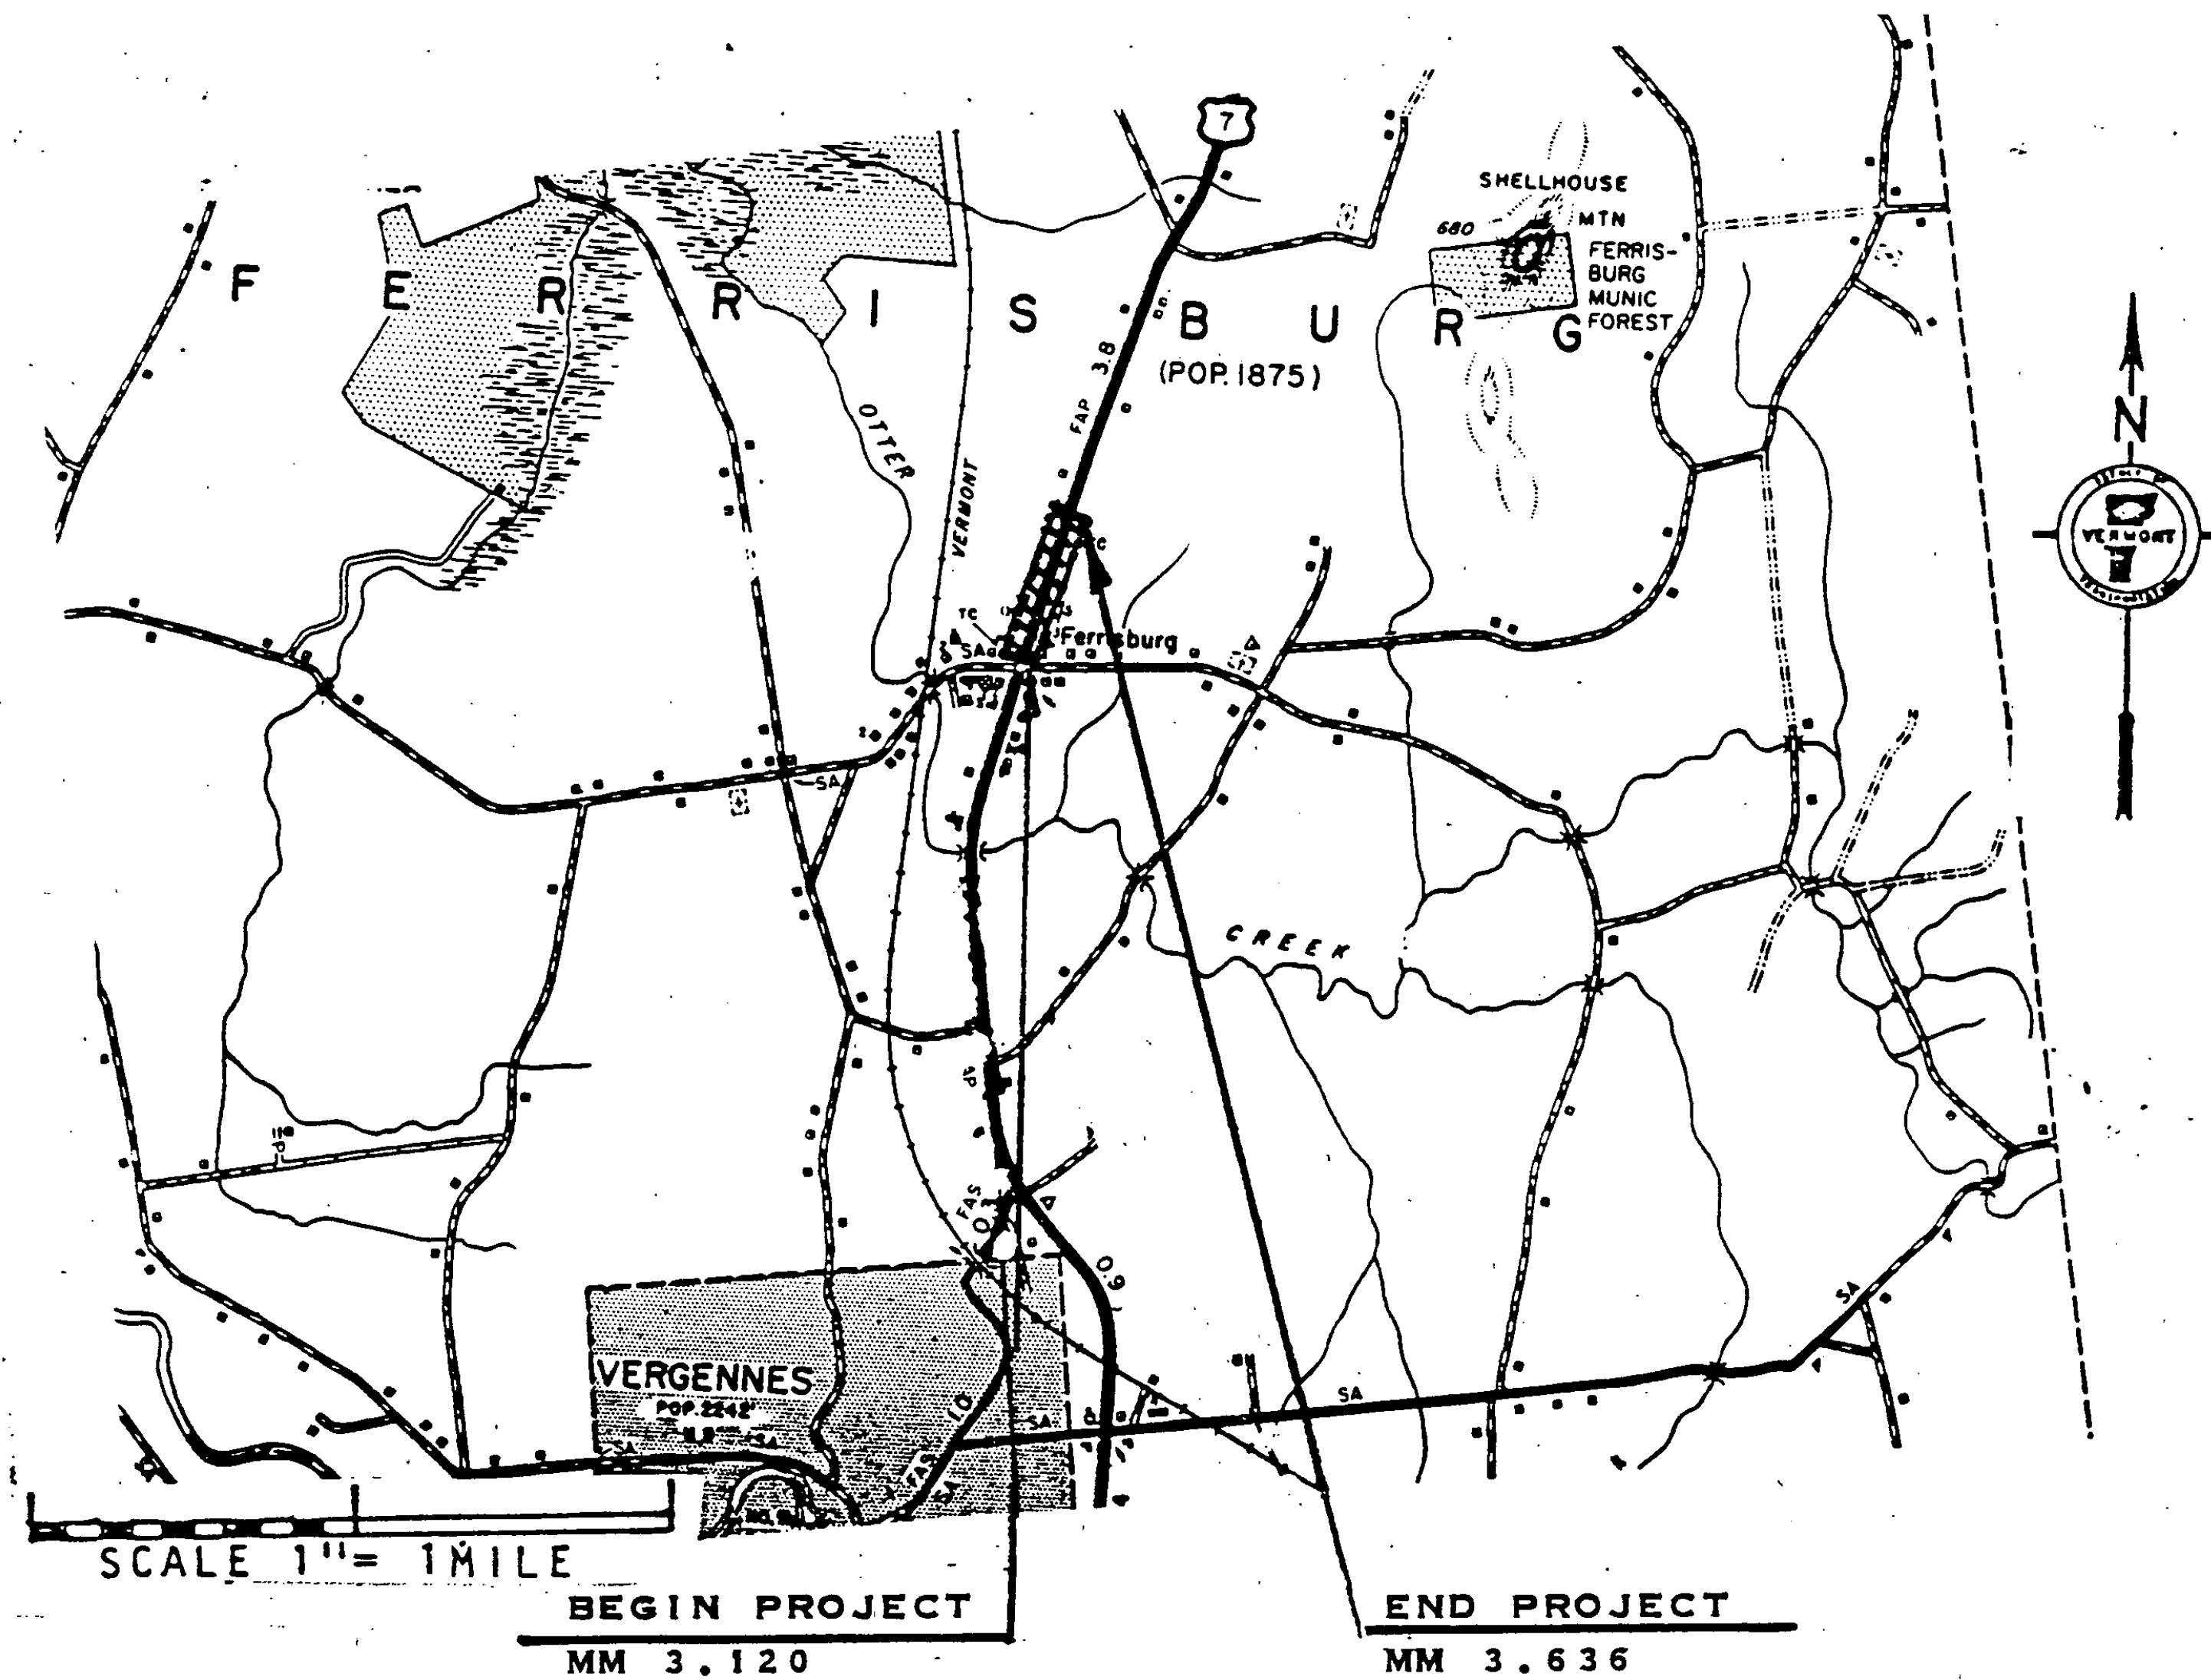

US 7- IN THE TOWN OF FERRISBURG BEGINNING AT MM 3.120 AND EXTENDING
0.516 MILES NORTHERLY TO MM3.636

LENGTH OF PROJECT
0.516 MILES
2725 FEET

PROJECT FERRISBURG

NO. HMA 2622
SHEET 8 OF 28 SHEETS