


ITEM 406.25 BITUMINOUS CONCRETE PAVEMENT  
LEVELING COURSE TYPE III OR IV (300 TONS/MILE)  
AS DIRECTED BY THE ENGINEER  
1 1/2" WEARING COURSE (3 1/4") TYPE III

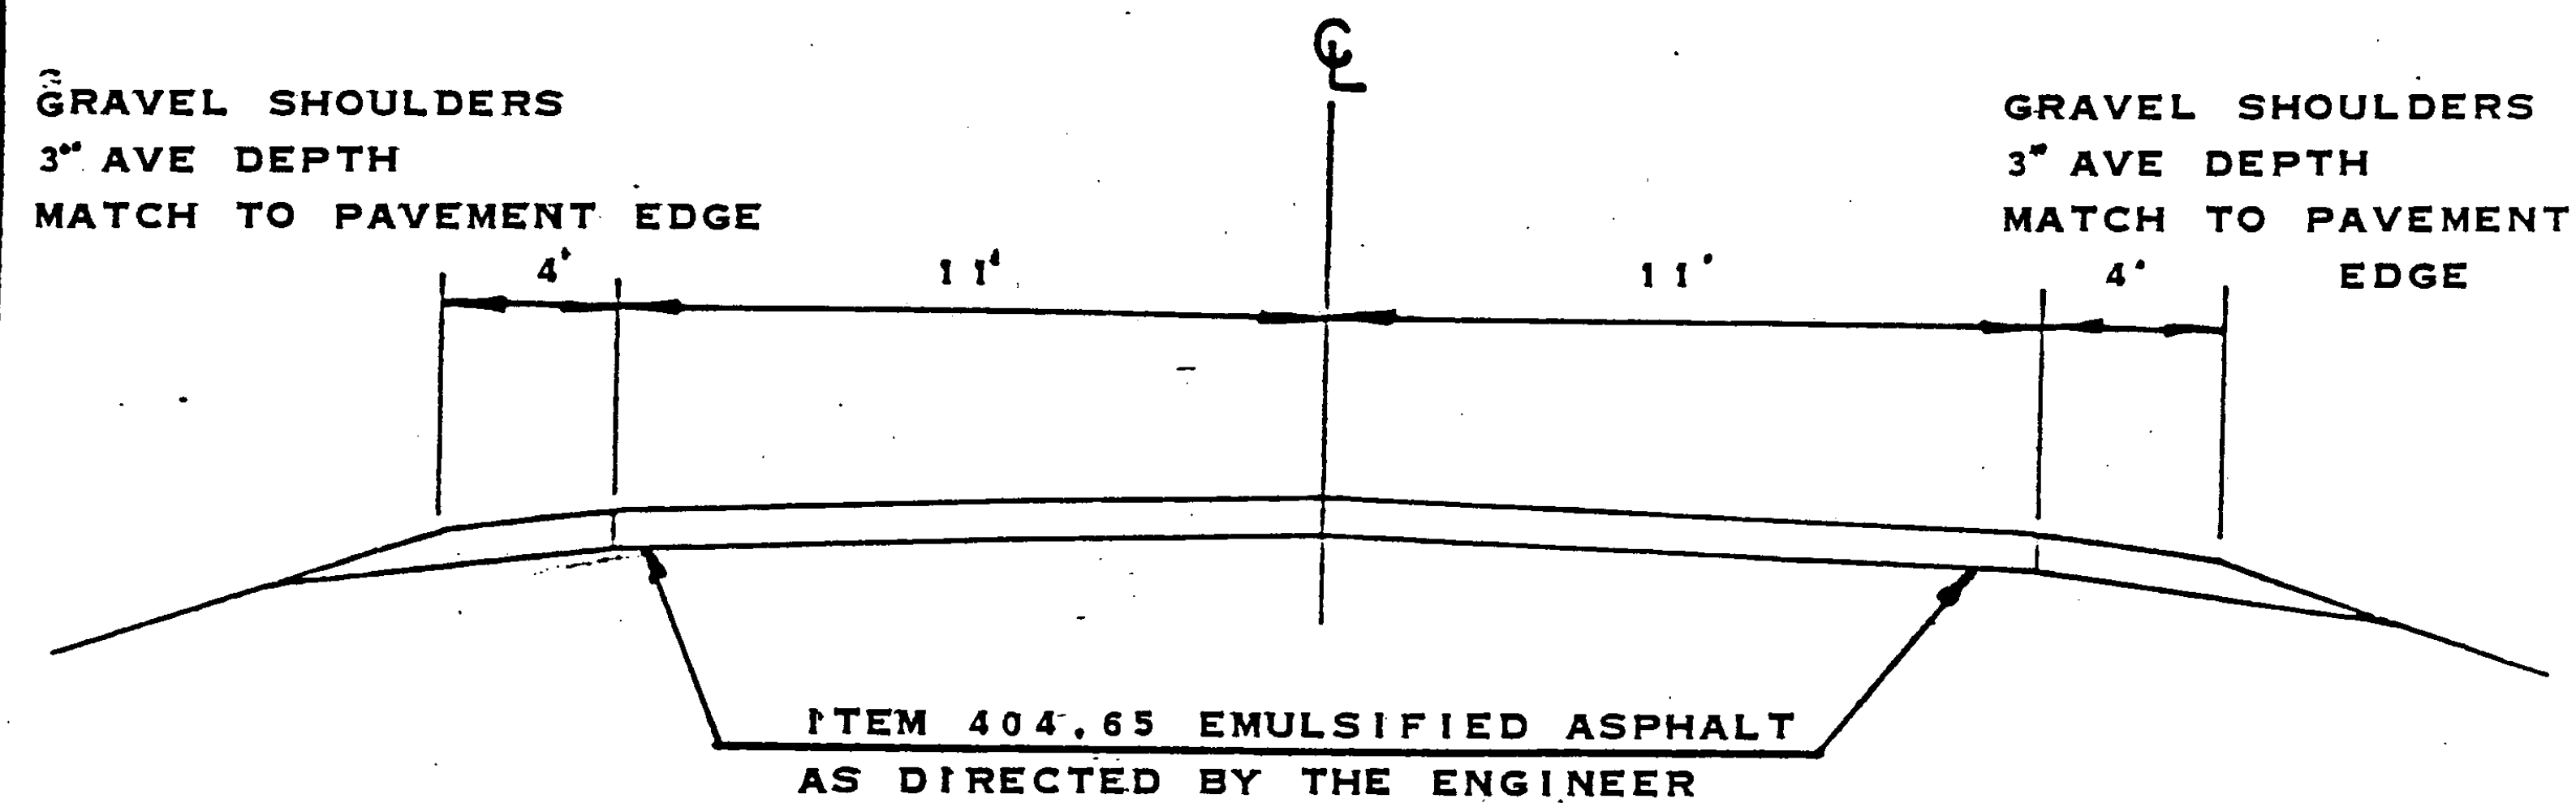

1982 ADT 7490  
V 50

PROJECT FERRISBURG

NO. HMA 2622

SHEET 9 OF 28 SHEETS