


ITEM 406.25 BITUMINOUS CONCRETE PAVEMENT
LEVELING COURSE TYPE III OR IV (261 TONS/MILE)
AS DIRECTED BY THE ENGINEER
3/4 WEARING COURSE, TYPE IV

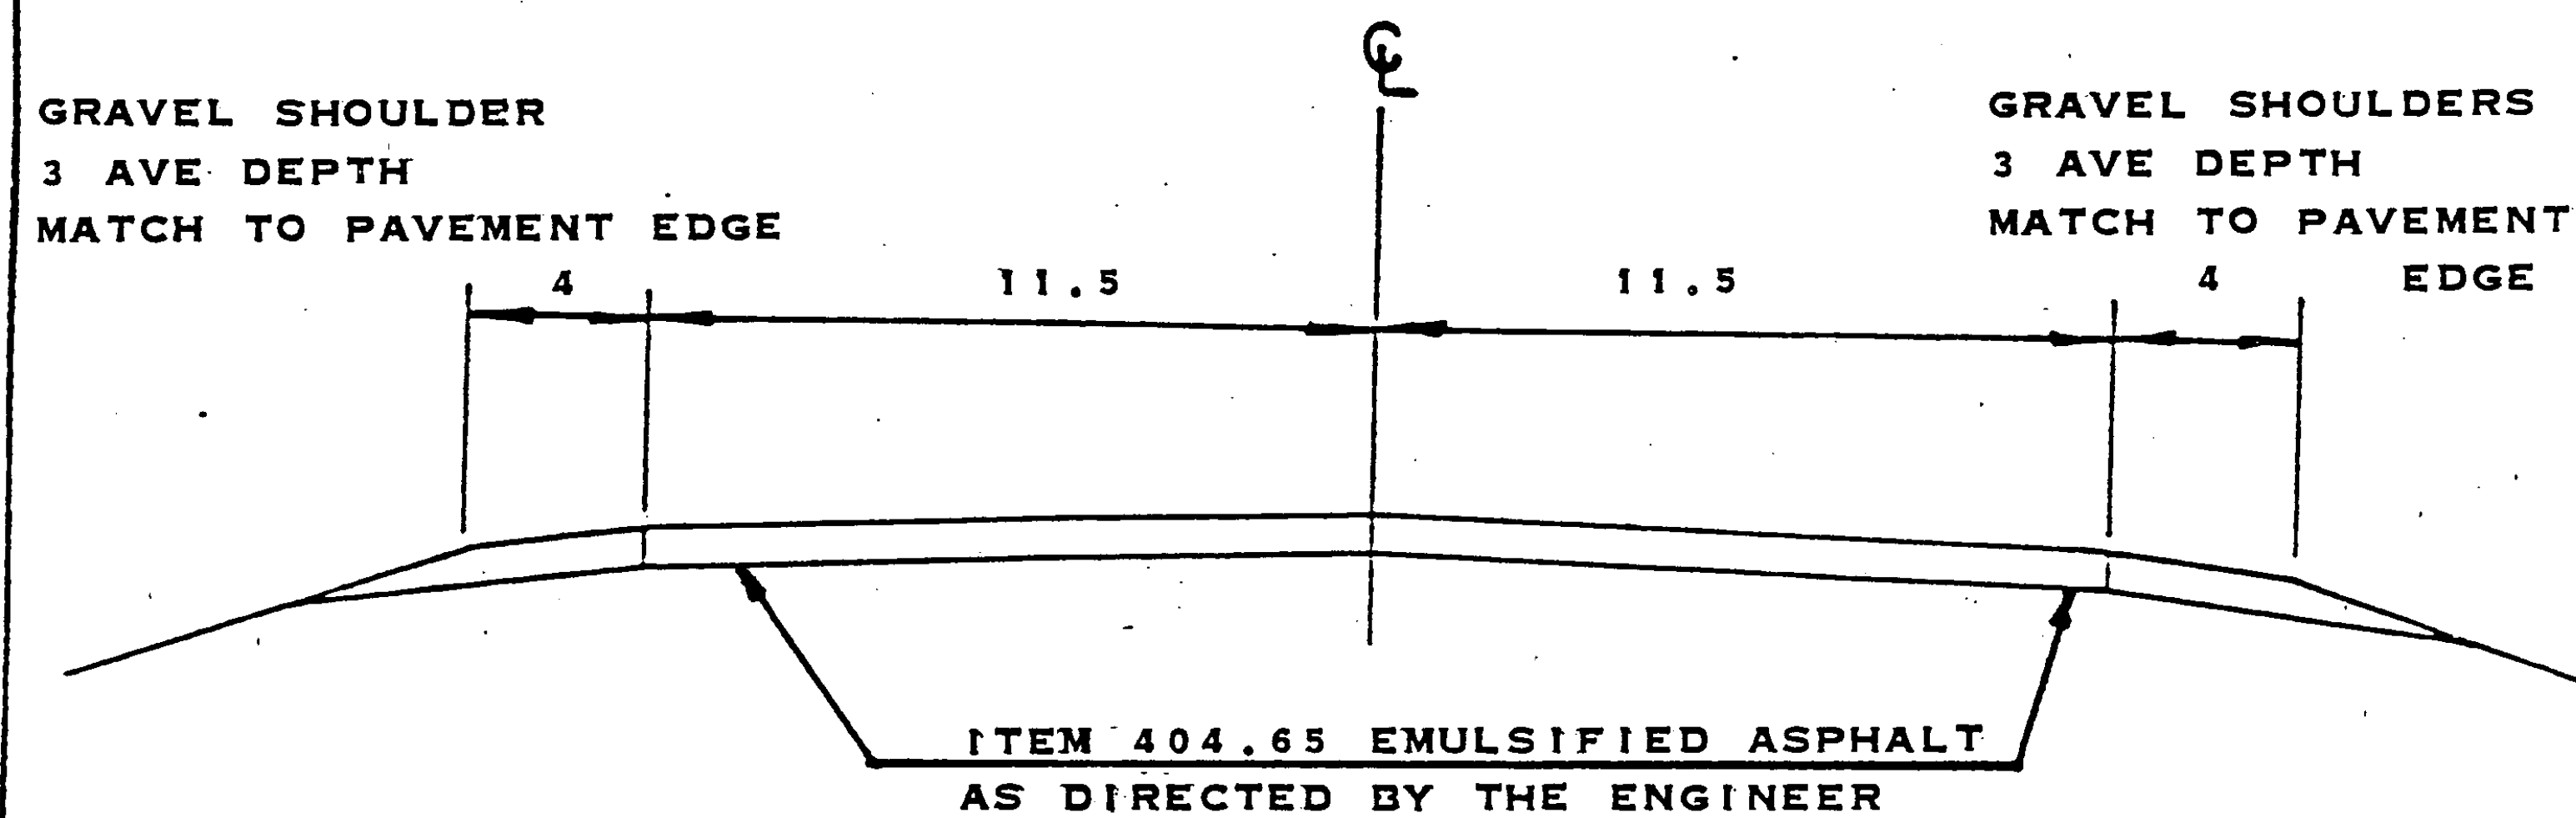

1982 ADT 1680
V 50

PROJECT NEW HAVEN

NO. F 032-1(4)S

SHEET 13 OF 28 SHEETS