
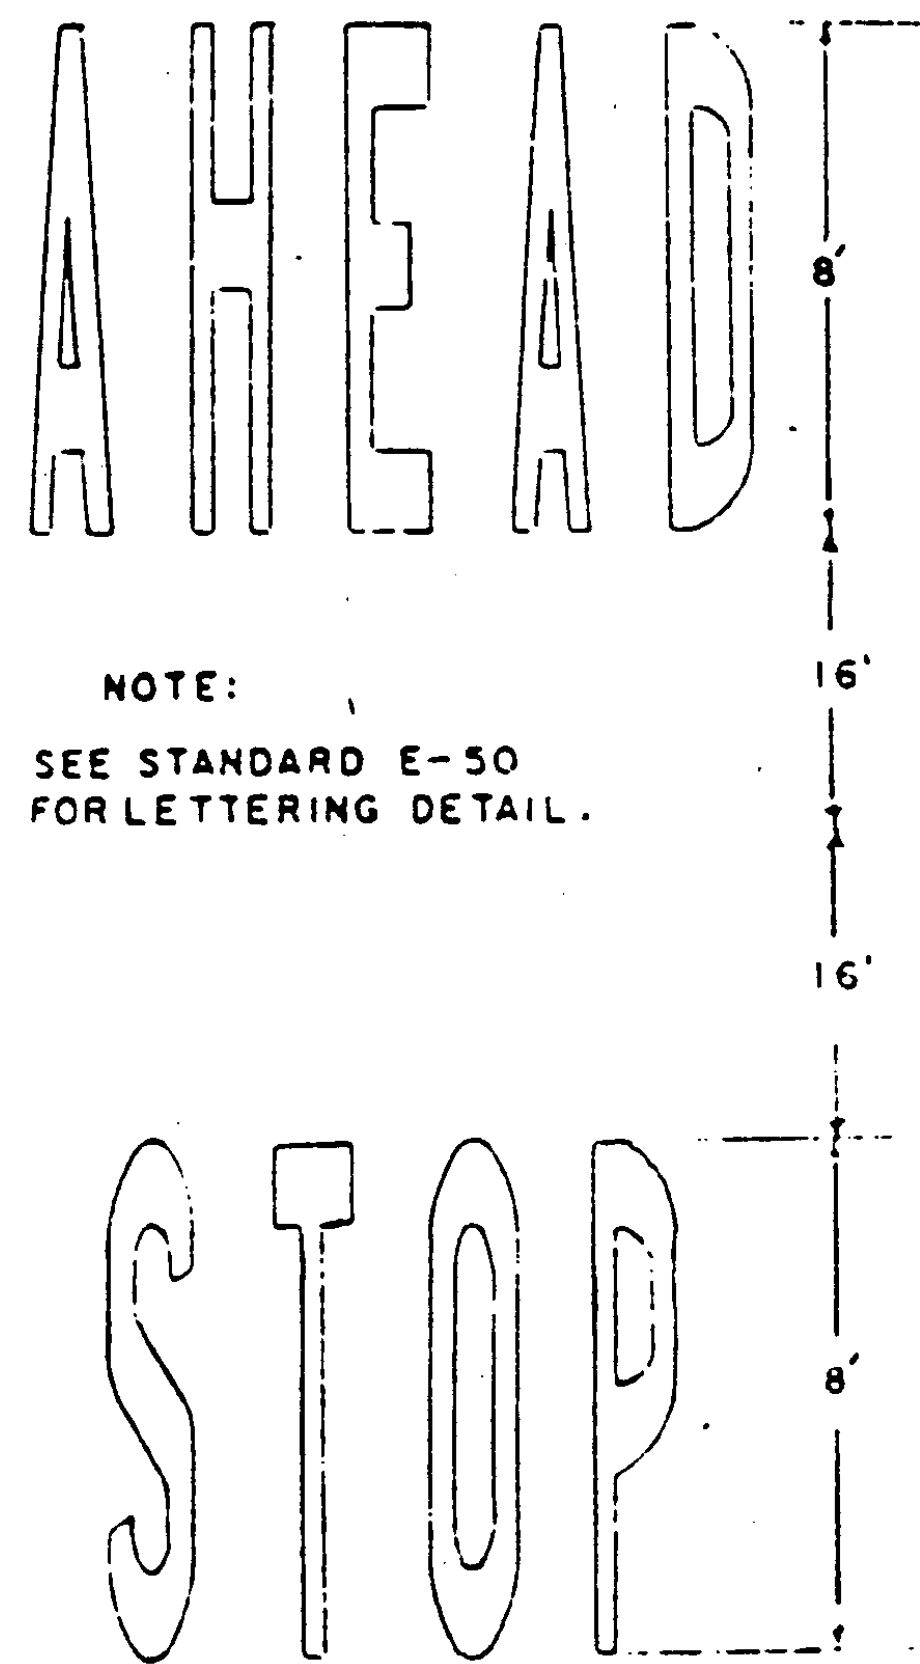


STOP BAR DETAILS

13.

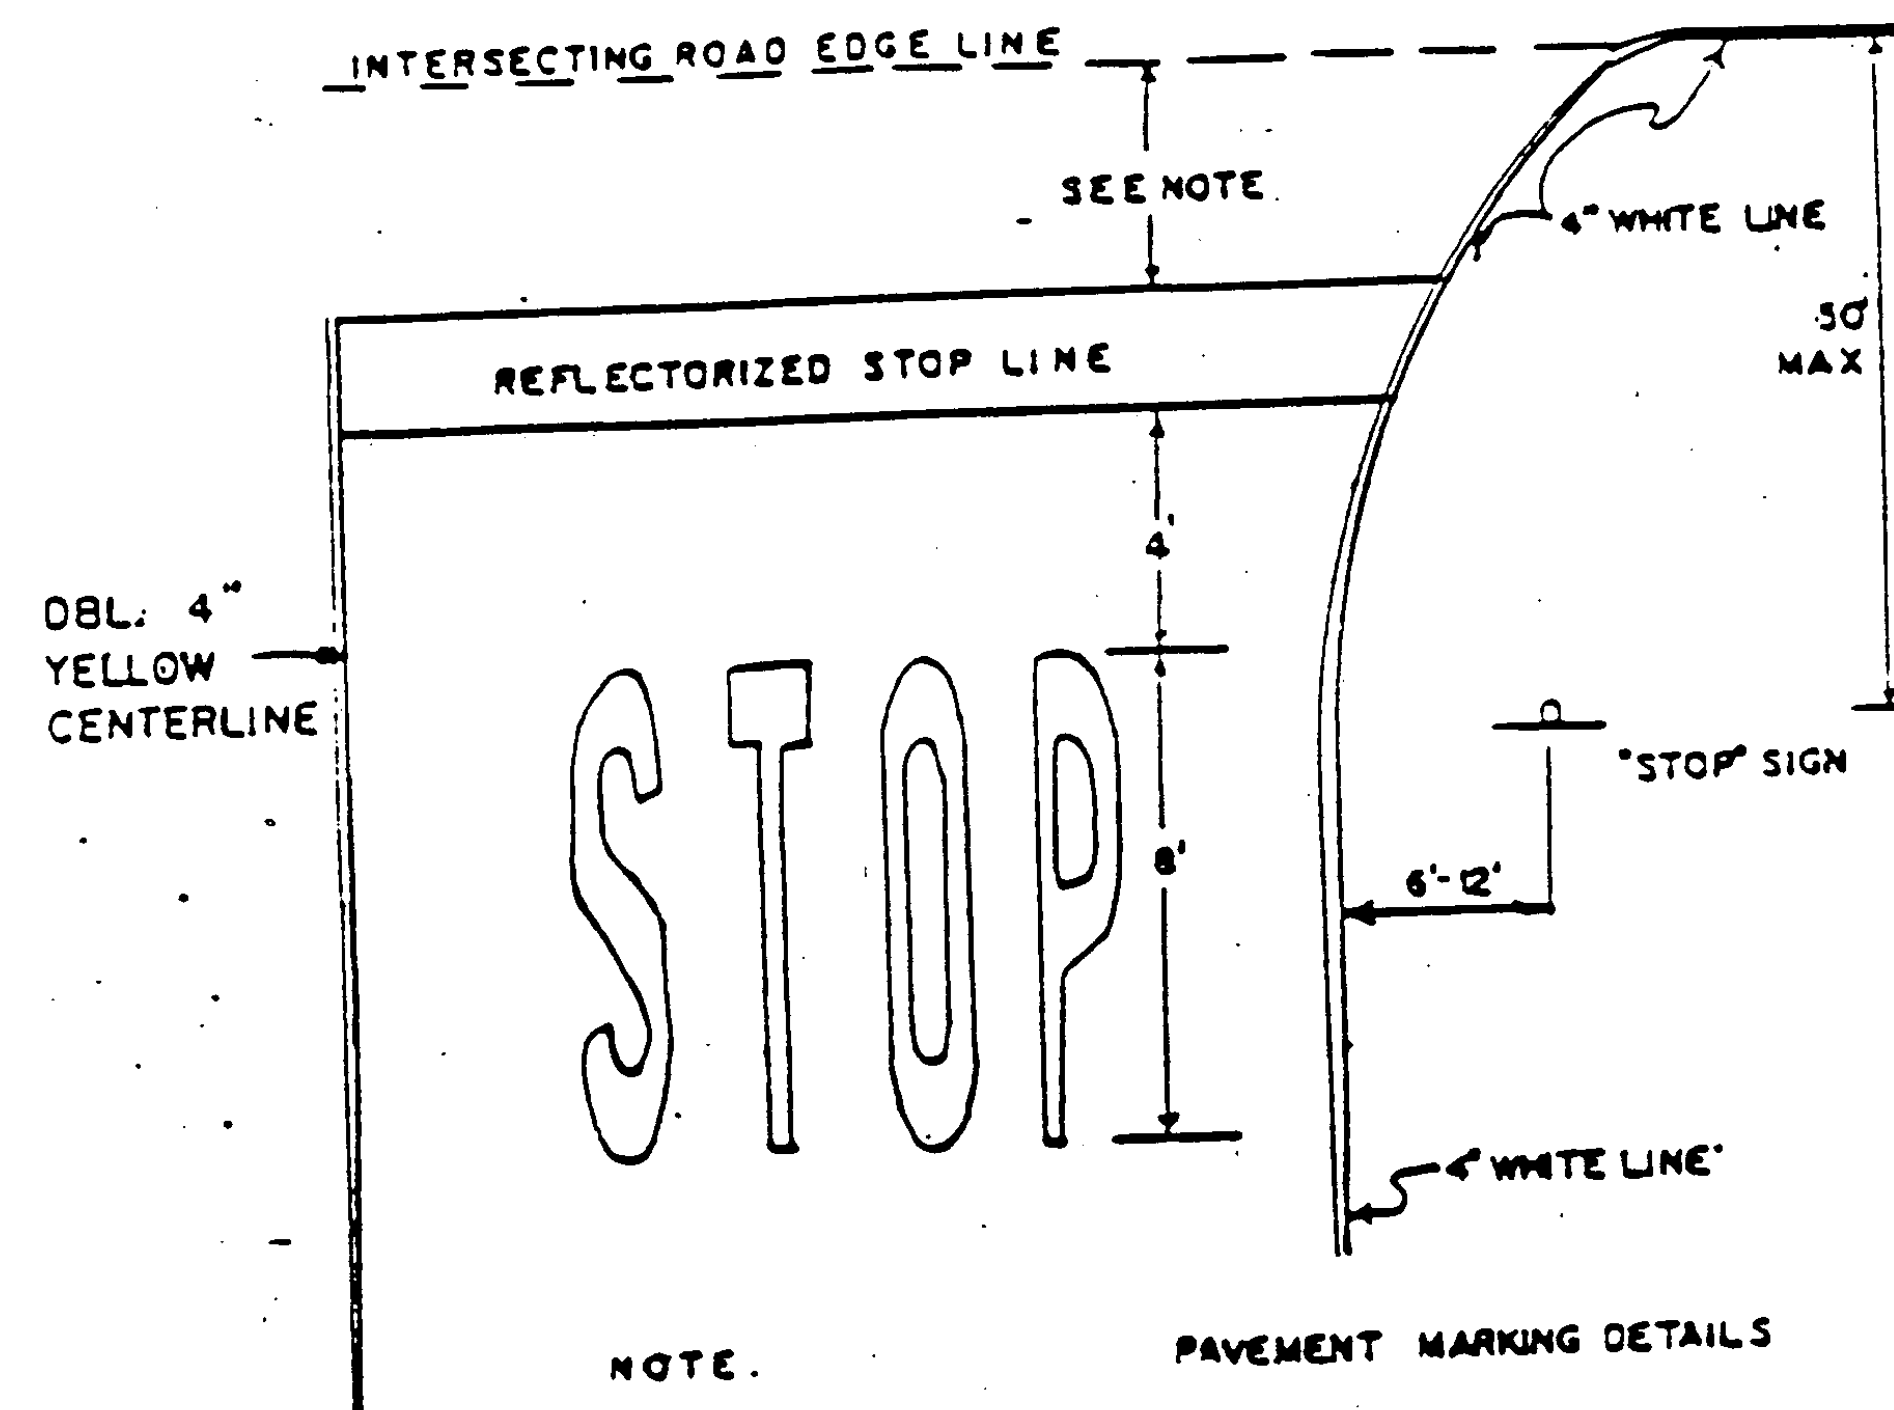

STOP AHEAD SIGN

NEW HAVEN
FO32-1(4)S

SHEET 16 OF 23