


ITEM 406.25 BITUMINOUS CONCRETE PAVEMENT  
LEVELING COURSE TYPE III OR IV (1.57 TONS/MILE)  
AS DIRECTED BY THE ENGINEER  
1" WEARING COURSE TYPE IV (± 1/4")

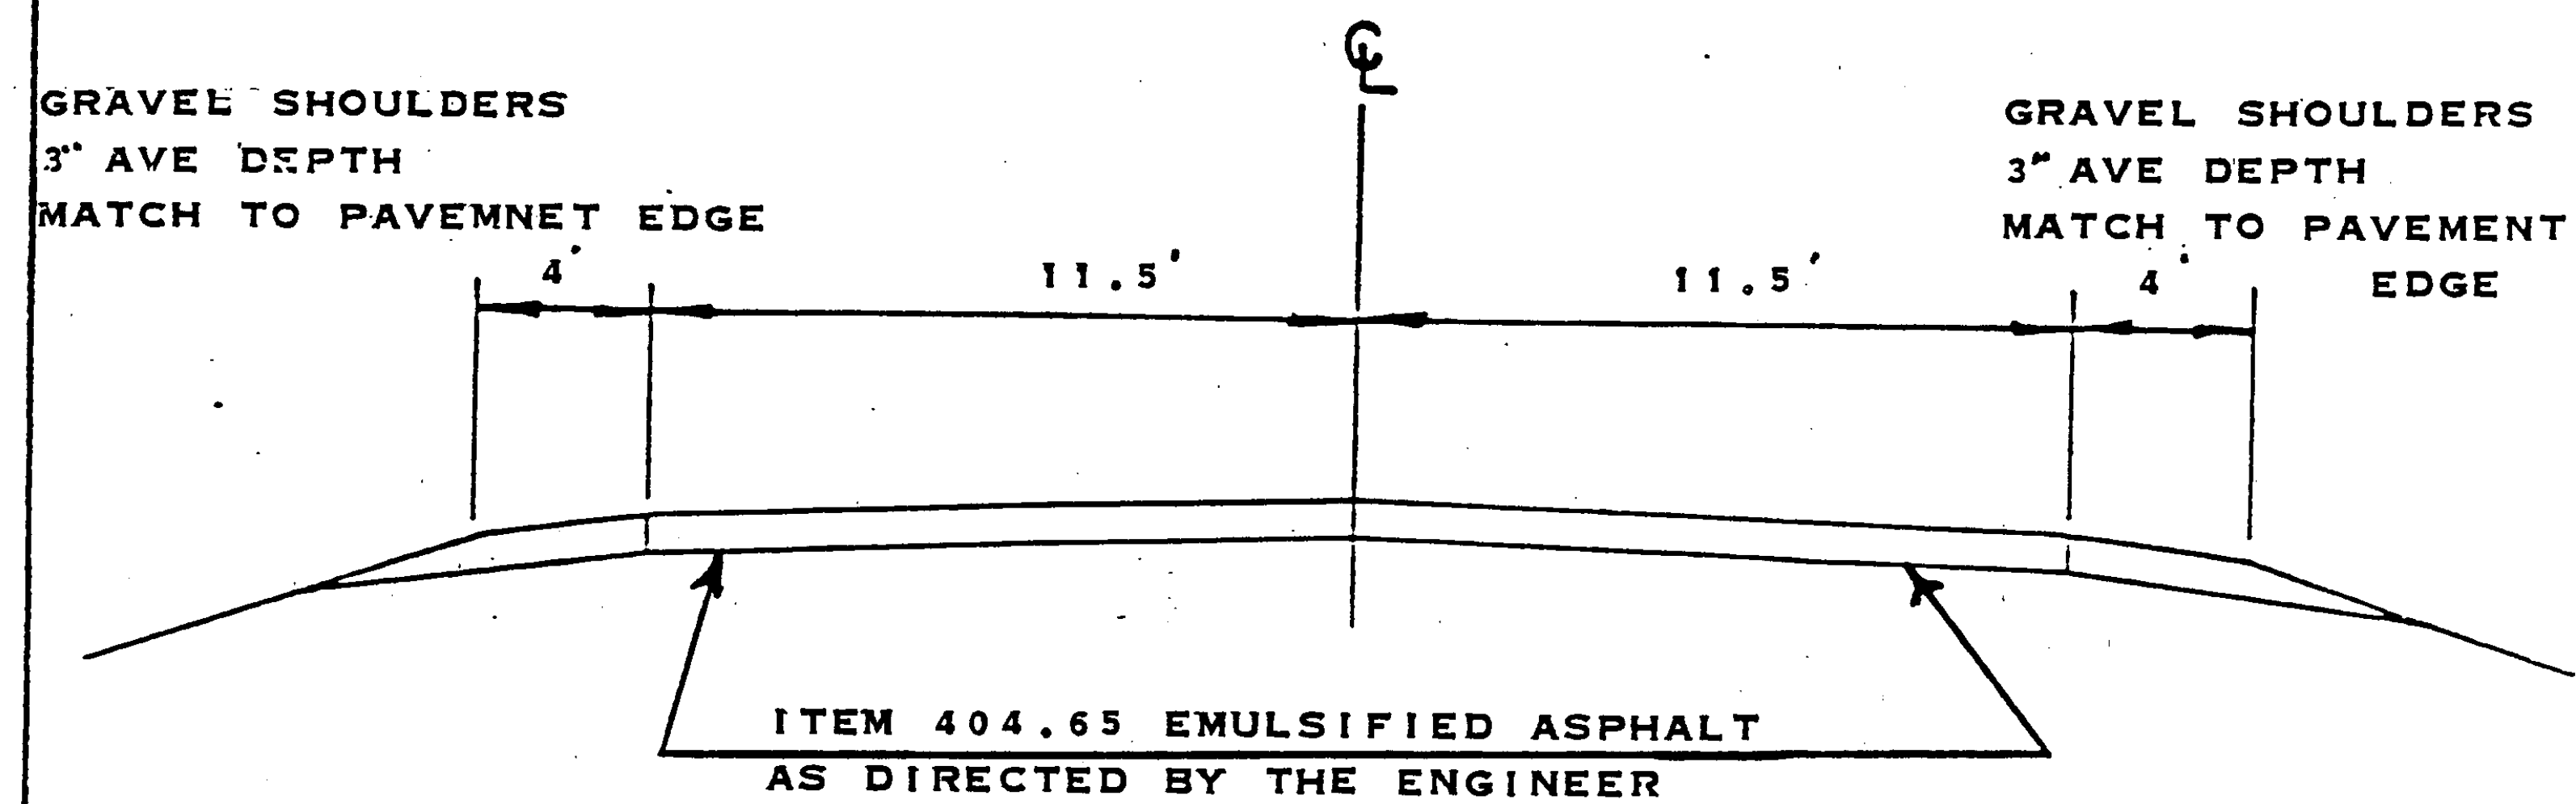

1982 ADT 2570  
V 50

PROJECT ADDISON

NO. HMA 2623

SHEET 19 OF 28 SHEETS