


ITEM 406.25 BITUMINOUS CONCRETE PAVEMENT
LEVELING COURSE TYPE III OR IV (300 TONS/MILE)
AS DIRECTED BY THE ENGINEER
1 1/2" WEARING COURSE (3/4") TYPE III

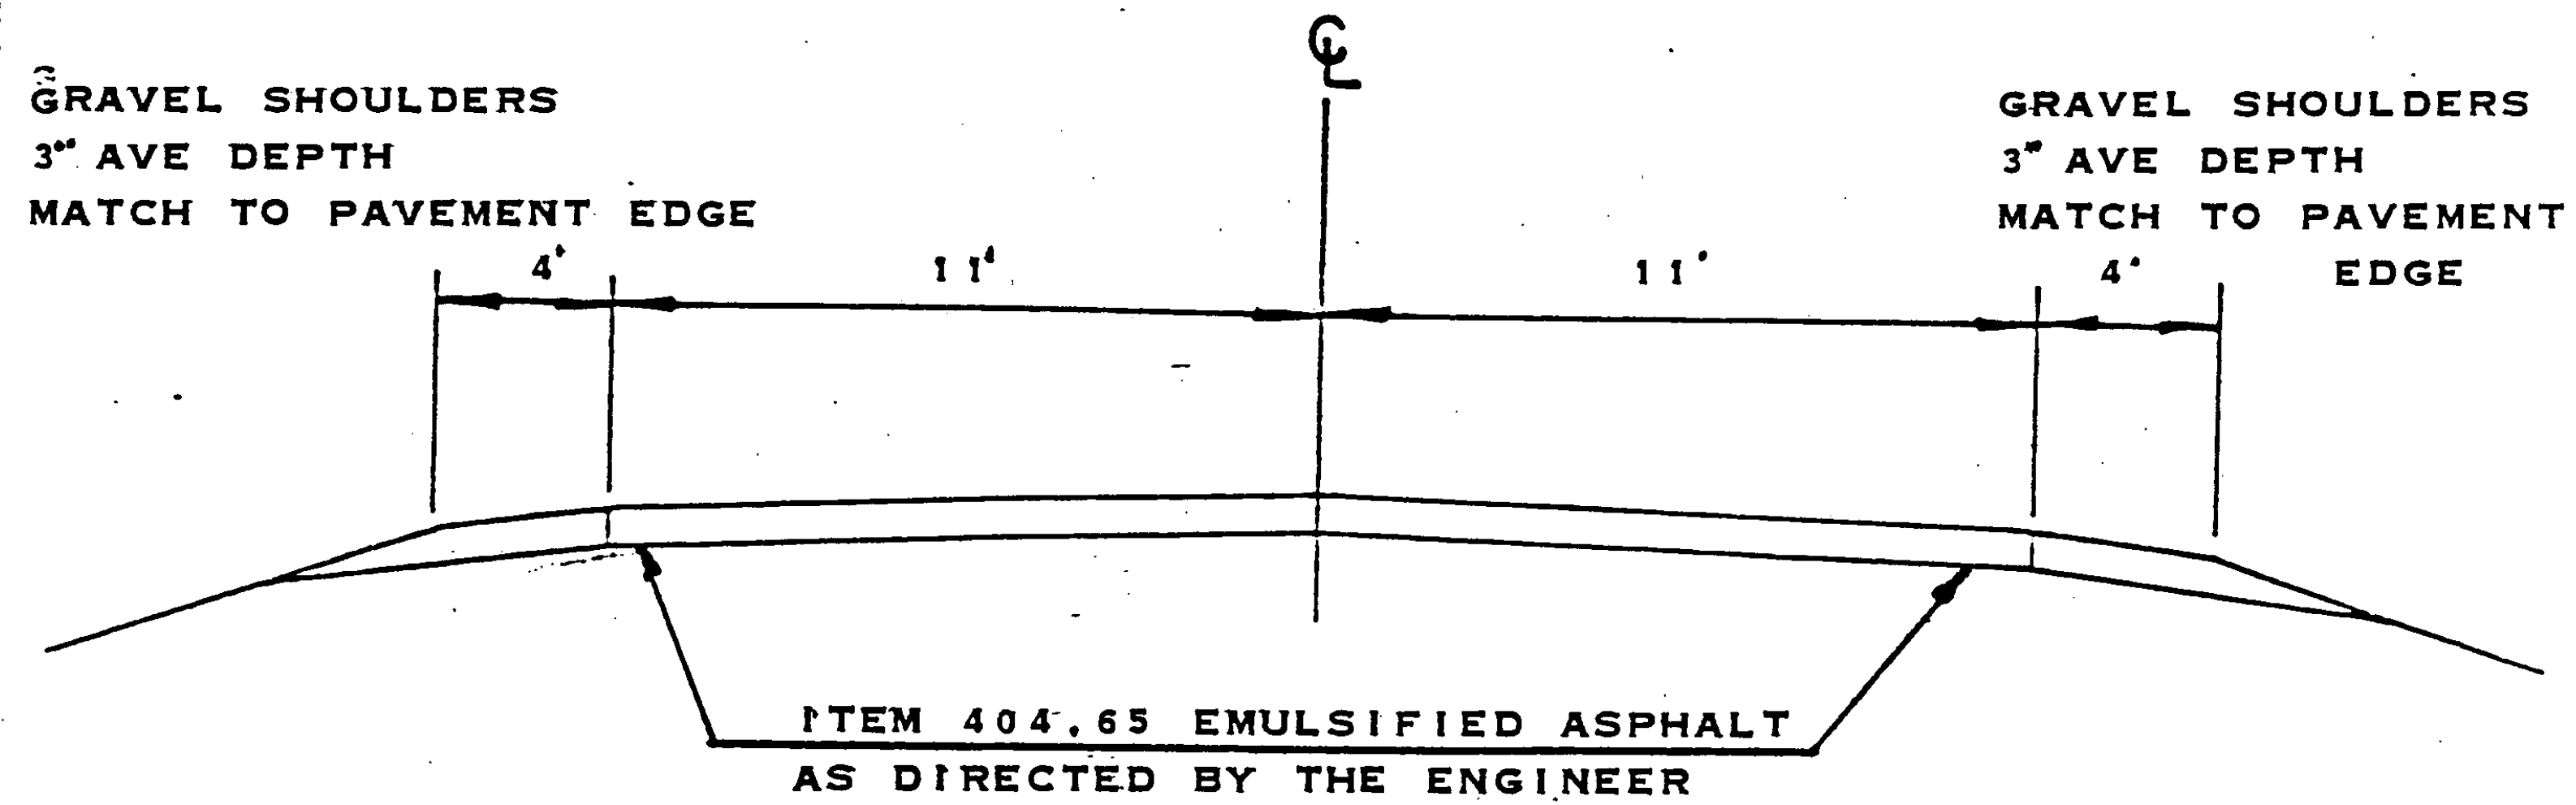

1982 ADT 7490
V 50

PROJECT FERRISBURG

NO. HMA 2622
SHEET 9 OF 28 SHEETS