


PROJECT DESCRIPTION AND LOCATION

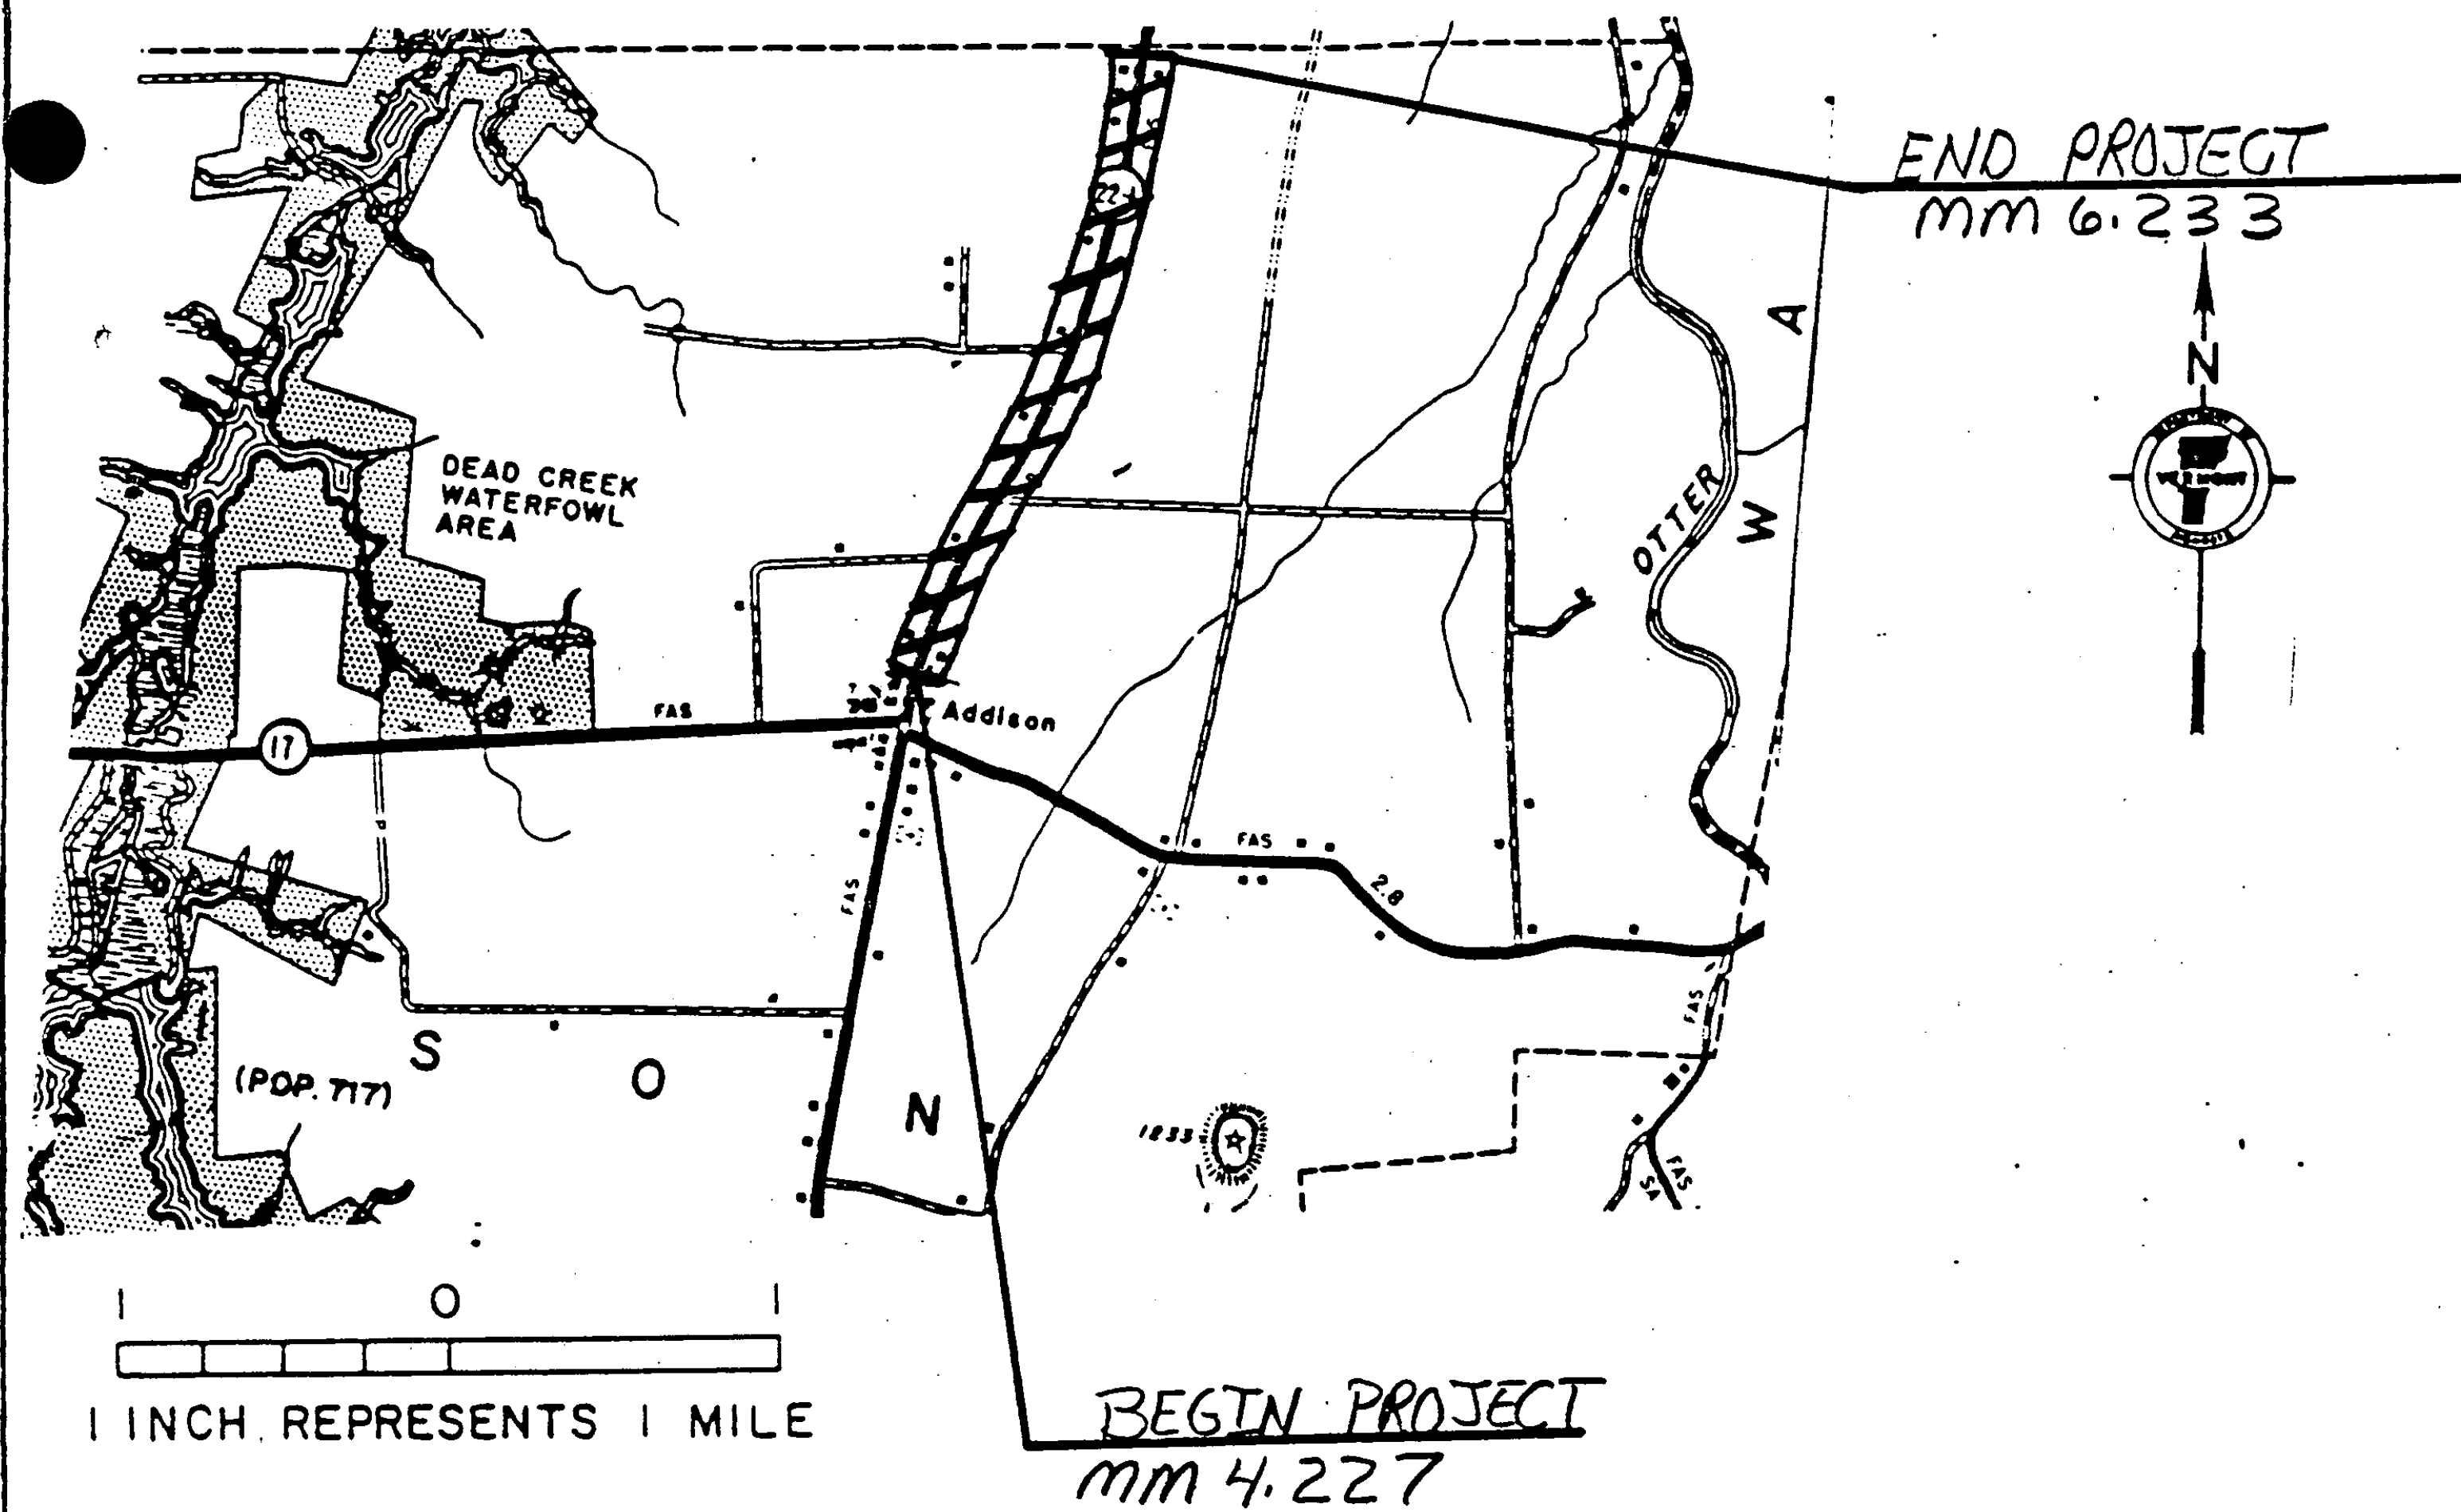

VT. 22A IN THE TOWN OF ADDISON BEGINNING
 AT MM 4.227 AND EXTENDING 2.006 MILES
 NORTHERLY TO MM 6.233

LENGTH OF PROJECT
 2.006 MILES
 10592 FEET

PROJECT ADDISON

NO. HMA 2623
 SHEET 18 OF 28 SHEETS