


ITEM 406.25 BITUMINOUS CONCRETE PAVEMENT
LEVELING COURSE TYPE III OR IV (1.57 TONS/MILE)
AS DIRECTED BY THE ENGINEER
1" WEARING COURSE TYPE IV ($\pm 1/4$ ")

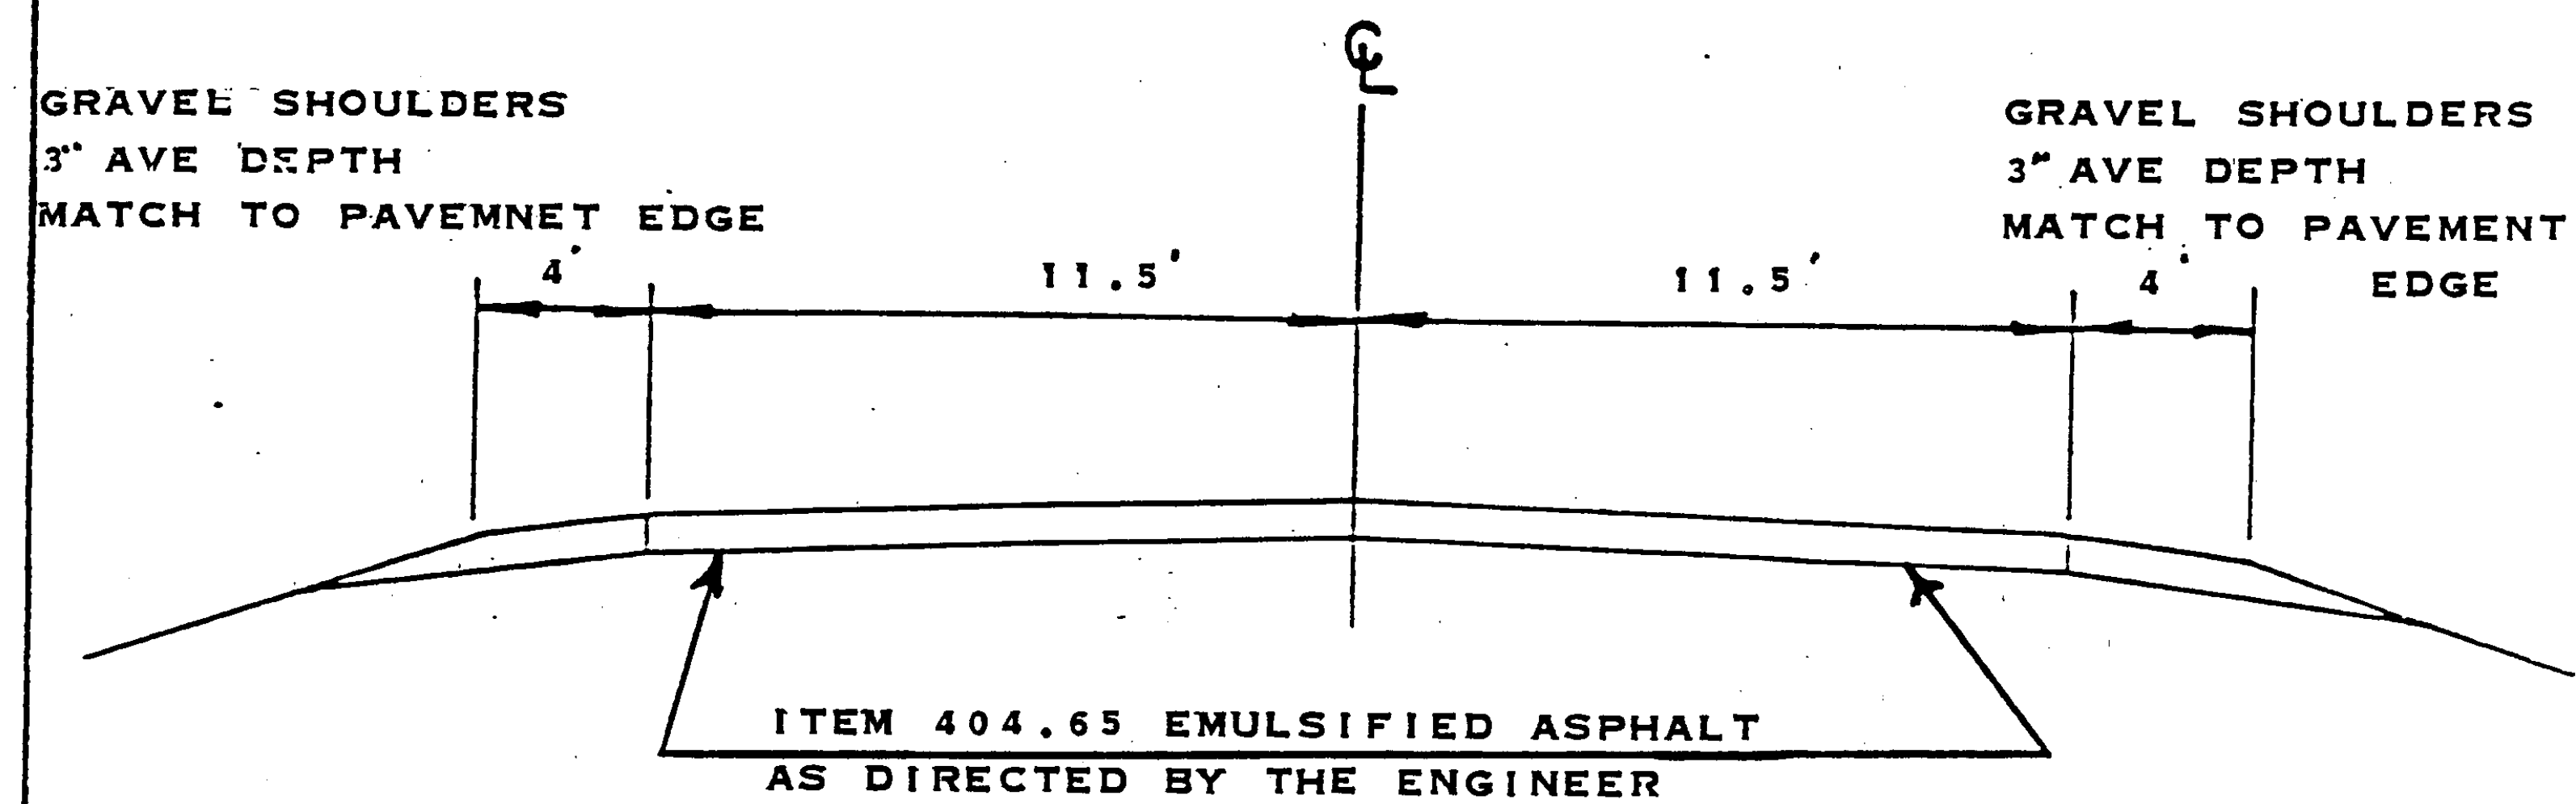

1982 ADT 2570
V 50

PROJECT ADDISON

NO. HMA 2623

SHEET 19 OF 28 SHEETS