

# TYPICAL SECTIONS & DESIGN DATA


MM 0.529 - MM 0.943

ITEM 201.10 COLD PLANING - BITUMINOUS PAVEMENT - 1"


ITEM 406.25 BITUMINOUS CONCRETE PAVEMENT

1" BINDER TYPE III OR TYPE IV - AS DIRECTED BY THE ENGINEER

1/2" WEARING COURSE ( $\pm 1/4$ ") TYPE III

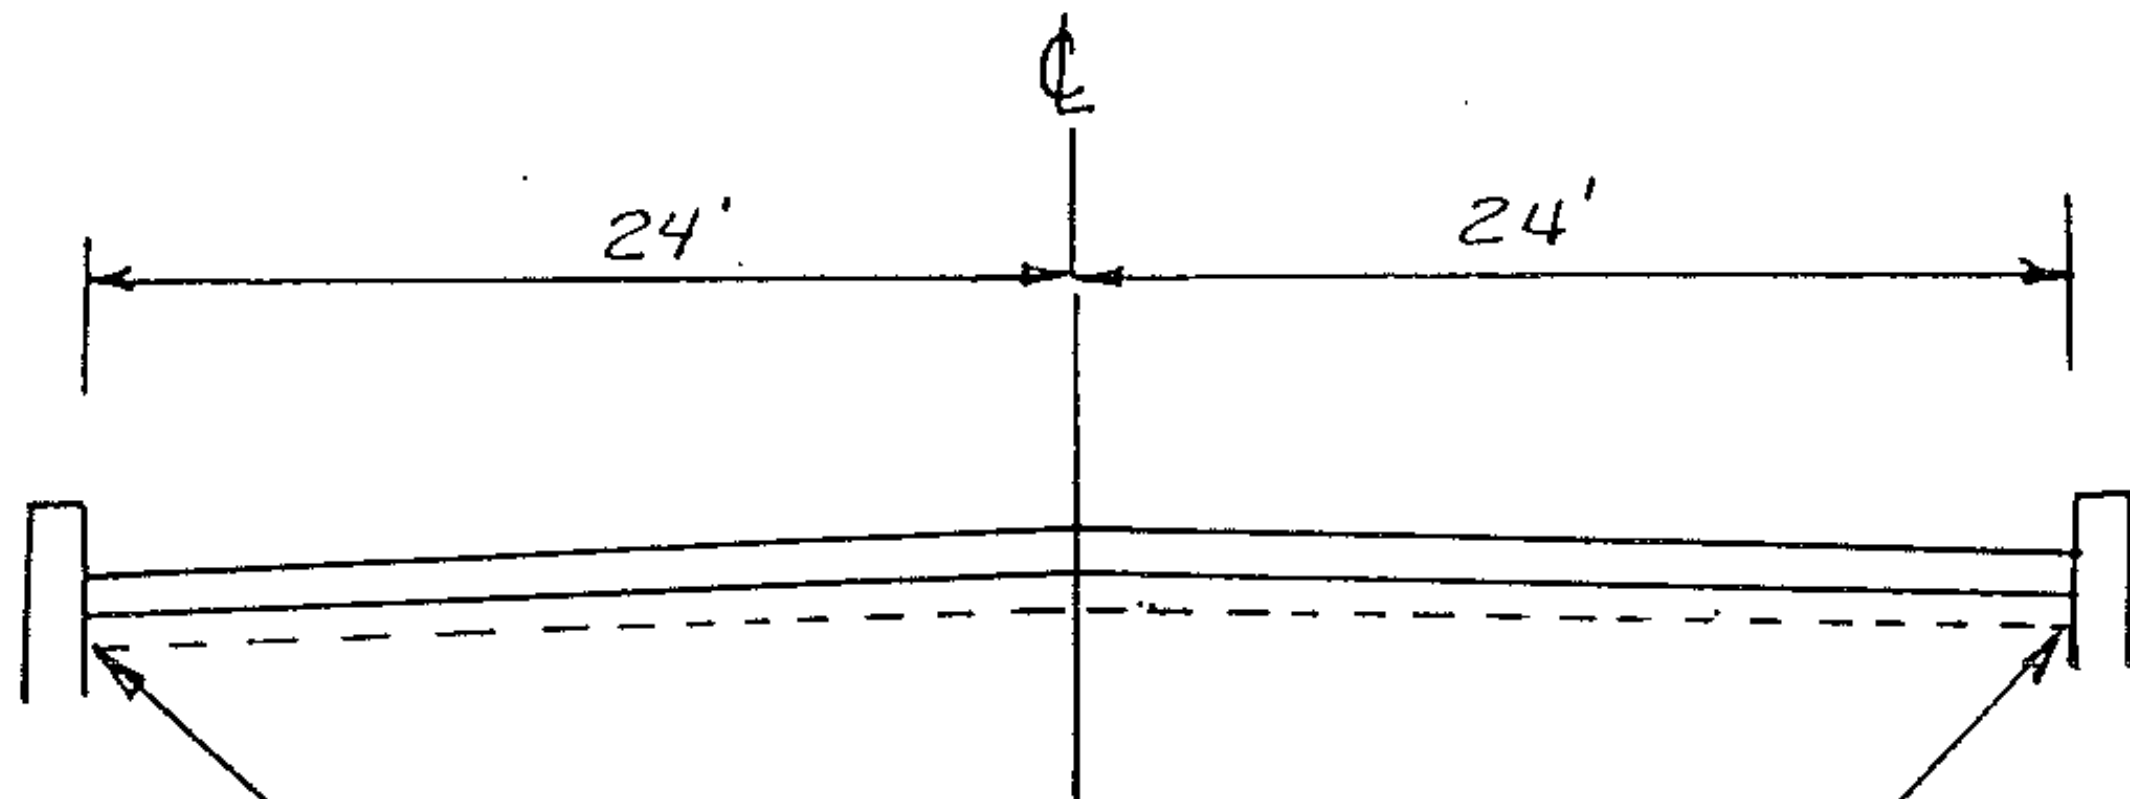

LIMITS OF COLD PLANING  
AS DIRECTED BY THE ENGINEER  
ITEM 404.65 EMULSIFIED ASPHALT  
MM 0.943 - MM 1.738

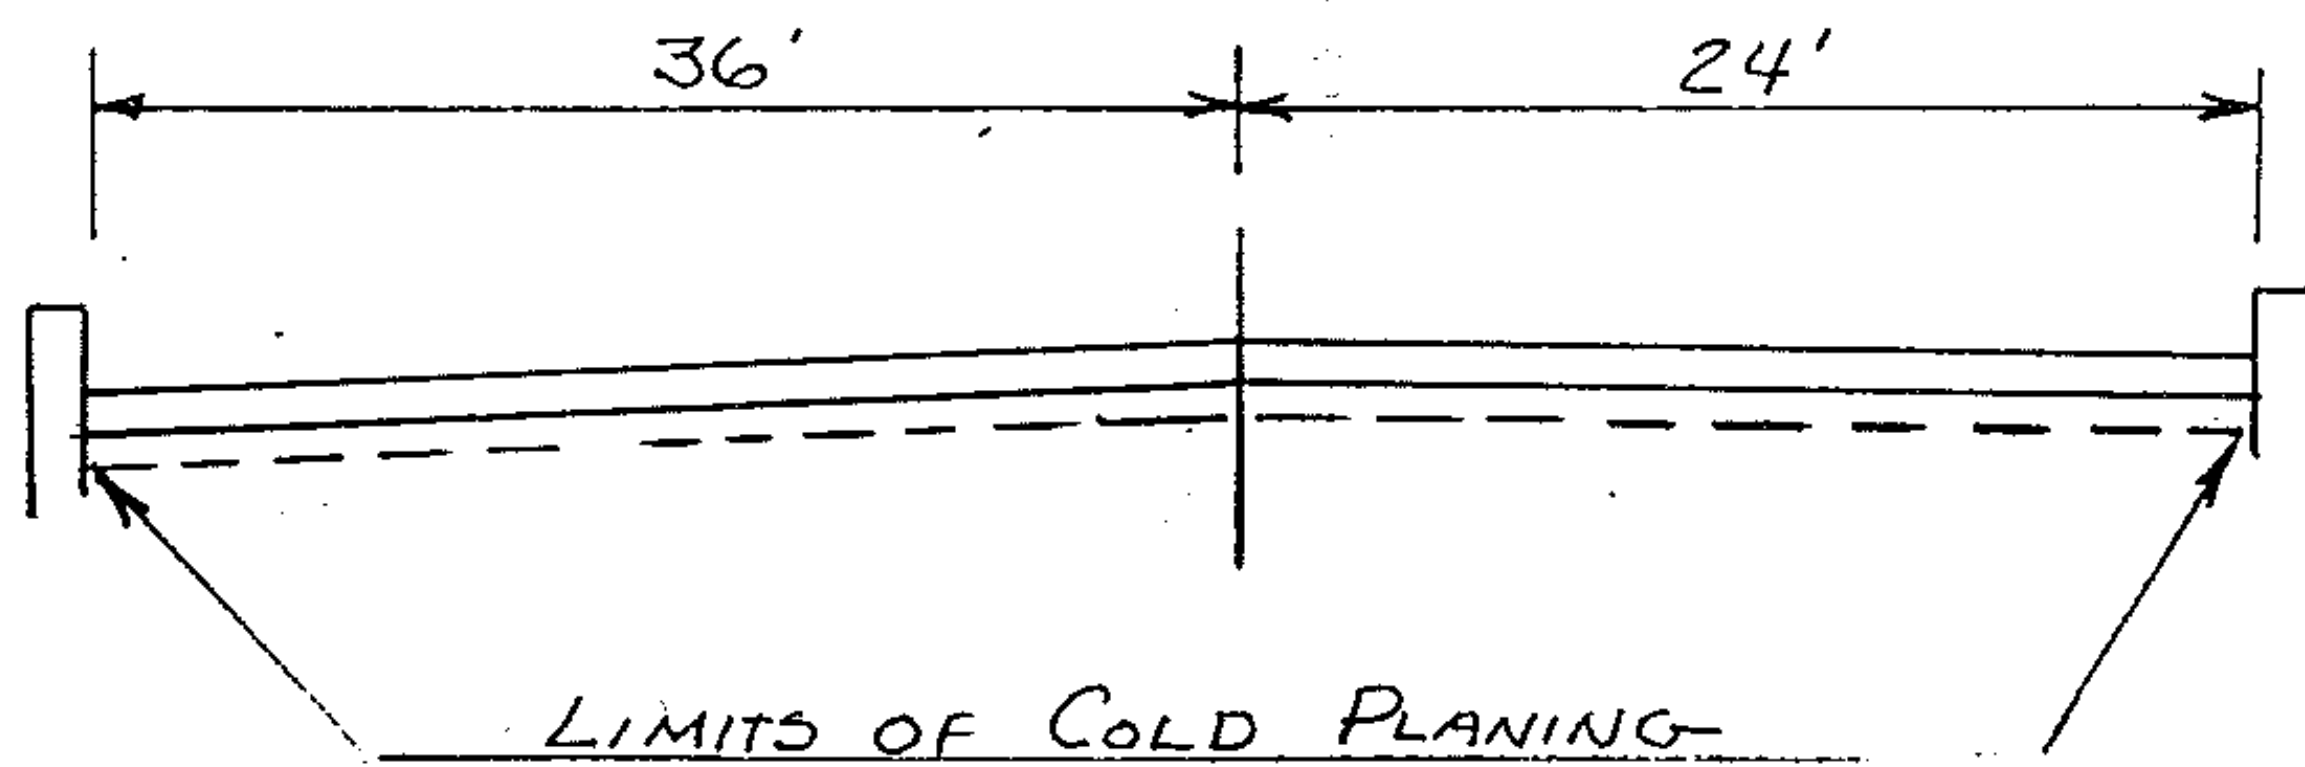

LIMITS OF COLD PLANING  
AS DIRECTED BY THE ENGINEER  
ITEM 404.65 EMULSIFIED ASPHALT

ITEM 201.10 COLD PLANING - BITUMINOUS PAVEMENT 1"

ITEM 406.25 BITUMINOUS CONCRETE PAVEMENT

1" BINDER TYPE III OR TYPE IV - AS DIRECTED BY THE ENGINEER

1/2" WEARING COURSE ( $\pm 1/4$ ") TYPE III

TRAFFIC DATA -

EST-1985 ADT = 25340

V = 35

PROJECT So. BURLINGTON

NO. F019-4(18)S

SHEET 9 OF 29 SHEETS