

DURABLE 4" YELLOW LINES
EQUIDISTANT YELLOW DASHED LINES(S)
AS SHOWN


10' BREAK OF MAINTENANCE
AT TOWNWAYS (TYP)

DURABLE 4" WHITE DASHED LINES(S)

DURABLE 4" YELLOW LINE
DEL LINE - BALDWIN INTERSECTION TO NORTH 350'
CENTER TURN LANE LINE - L.R. (SEE DETAIL A) (SEE DETAIL C)
AND FROM END OF DEL LINE NORTH TO END OF ST, AS SHOWN
DASHED CENTER TURN LANE LINE - L.R. (SEE DETAIL A) (SEE DETAIL C)
DEL LINE - ON BALDWIN DR. (SEE DRIVE) (SEE DETAIL B)
DURABLE 4" WHITE LINE
LANE LINE - SOUTH SIDE FROM STOP BAR AT BALDWIN RD.
NORTH 120'.
EDGE LINE - SOUTH & NORTH SIDE FROM CURB, ROUND CURB RADII
AT BALDWIN DR. DRIVE TO AUTO DLR. (SEE DETAIL B)
DASHED LANE LINE - SOUTH & NORTH SIDE THROUGH LANES (AS SHOWN)

DURABLE ARROW MARKINGS
SOUTHBOUND THROUGH LANES (L) AT BALDWIN RD INTERSECTION, AS SHOWN (SEE DETAIL E)
NORTHBOUND THROUGH LANES (L) AT BALDWIN RD INTERSECTION, AS SHOWN (SEE DETAIL G)
DURABLE LETTER IN WORD MARKINGS
SOUTHBOUND LANE AT BALDWIN INTERSECTION, AS SHOWN
VIABLE 24" STOP BAR
SOUTHBOUND THROUGH LANES AT BALDWIN (40' FROM NEAREST SIGNAL, SEE DETAIL B)
BALDWIN DR. DRIVE TO AUTO DLR. (SEE DETAIL B)
PAINTED CURB
ALL DRIVES (SEE DETAIL)

SCALE 1" = 50'

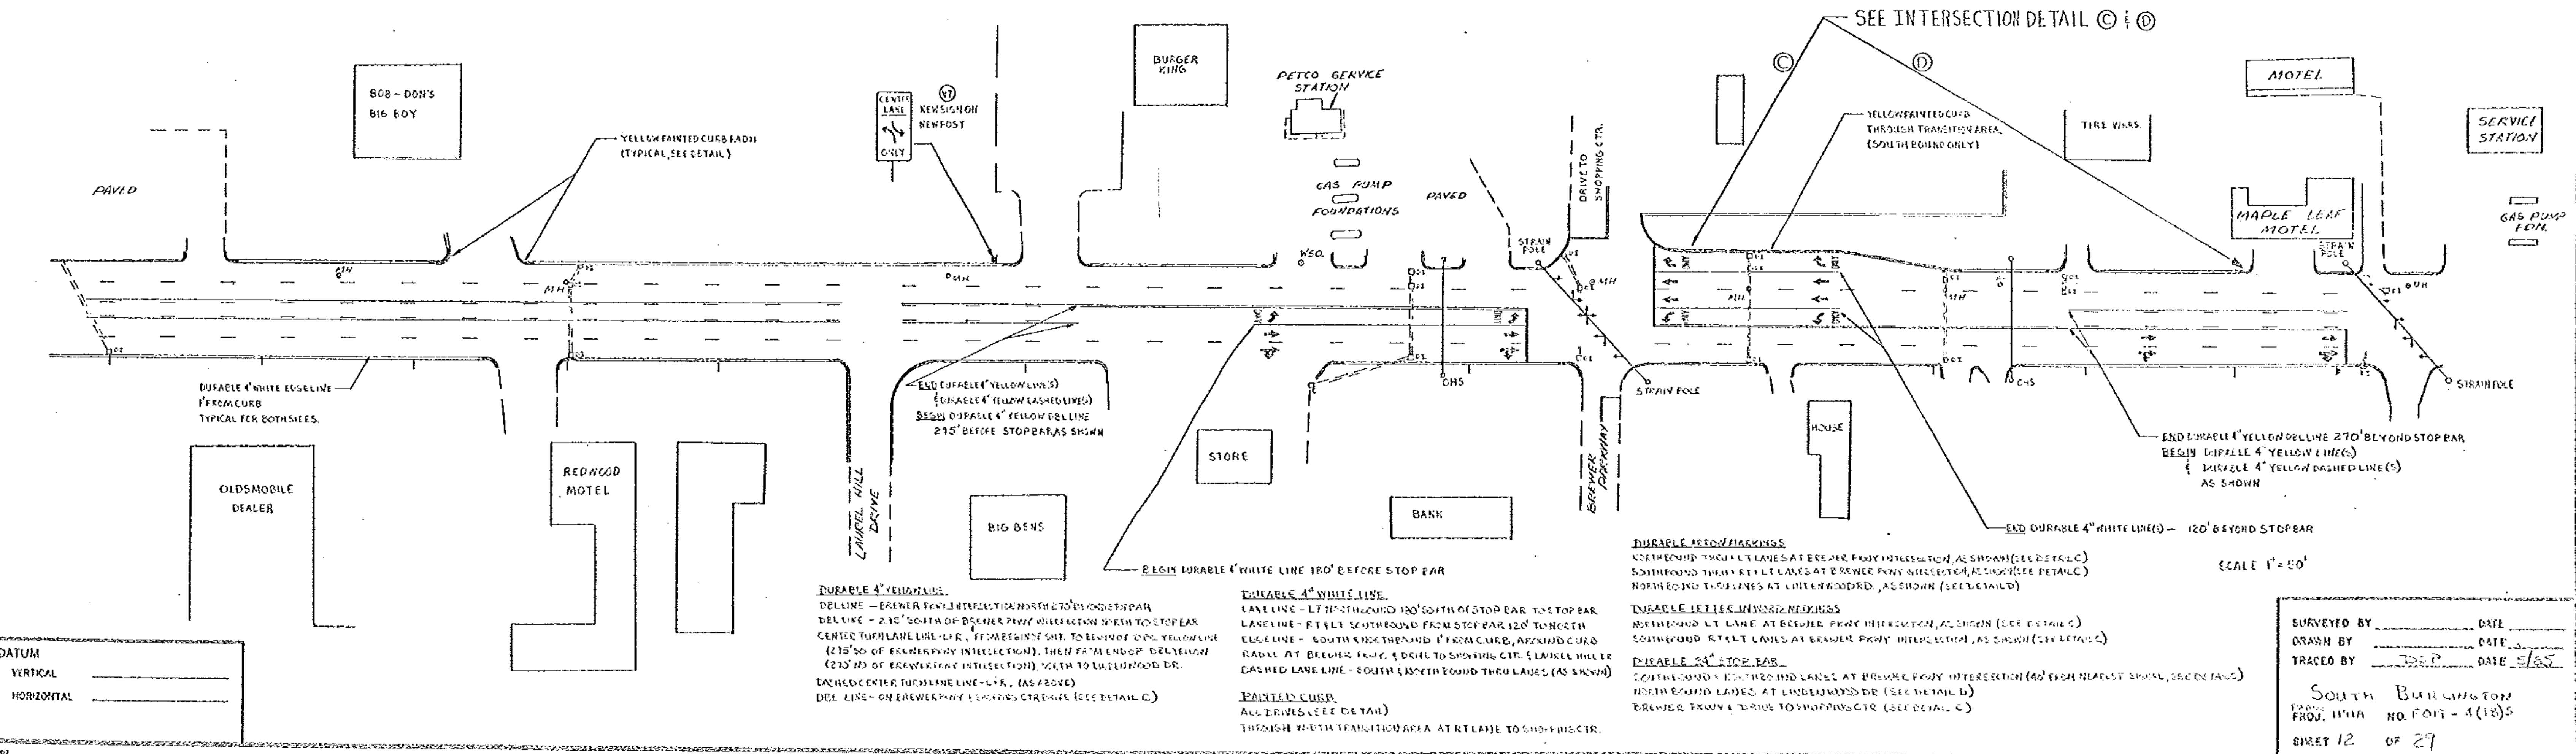

DURABLE 4" YELLOW LINES
DEL LINE - BREWER PKWY INTERSECTION NORTH 270' TO STOP BAR
DEL LINE - 210' SOUTH OF BREWER PKWY INTERSECTION FROM STOP BAR
CENTER TURN LANE LINE - L.R., FROM BREWER PKWY TO END OF DEL YELLOW LINE
(210' SO OF BREWER PKWY INTERSECTION), THEN FROM END OF DEL YELLOW LINE
(210' SO OF BREWER PKWY INTERSECTION) NORTH TO BALDWIN DR.
TYPICAL CENTER TURN LANE LINE - L.R., (AS ABOVE)
DEL LINE - ON BREWER PKWY THROUGH STRAIGHT (SEE DETAIL C)

DURABLE 4" WHITE LINE
LANE LINE - LT 120' SOUTH OF STOP BAR TO STOP BAR
LANE LINE - RT 120' SOUTH FROM STOP BAR 120' TO NORTH
EDGE LINE - SOUTH SIDE FROM CURB, ROUND CURB
RADII AT BREWER PKWY, 5' FROM TO STOP BAR, 5' FROM MILLER
DASHED LANE LINE - SOUTH (NORTHBOUND THROUGH LANES) (AS SHOWN)

PAINTED CURB
ALL DRIVES (SEE DETAIL)
THROUGH NORTH TRANSITION AREA AT RETAIL TO SHOPPING CTR.

DURABLE ARROW MARKINGS
NORTHBOUND THROUGH LANES AT BREWER PKWY INTERSECTION, AS SHOWN (SEE DETAIL C)
SOUTHBOUND THROUGH LANES AT BREWER PKWY INTERSECTION, AS SHOWN (SEE DETAIL C)
NORTHBOUND THROUGH LANES AT BREWER PKWY INTERSECTION, AS SHOWN (SEE DETAIL C)

DURABLE LETTER IN WORD MARKINGS
NORTHBOUND LANE AT BREWER PKWY INTERSECTION, AS SHOWN (SEE DETAIL C)
SOUTHBOUND RT LANE AT BREWER PKWY INTERSECTION, AS SHOWN (SEE DETAIL C)

VIABLE 24" STOP BAR
SOUTHBOUND THROUGH LANES AT BREWER PKWY INTERSECTION (40' FROM NEAREST SIGNAL, SEE DETAIL B)
NORTHBOUND LANE AT BREWER PKWY INTERSECTION (SEE DETAIL B)
BREWER PKWY DRIVE TO SHOPPING CTR. (SEE DETAIL C)

SCALE 1" = 50'

DATUM	VERTICAL	_____
	HORIZONTAL	_____

SURVEYED BY _____ DATE _____
 DRAWN BY _____ DATE _____
 TRACED BY _____ DATE 5/85

SOUTH BURLINGTON
 PROJ. 1111A NO. FOR - 4(18)S
 SHEET 12 OF 29