


* Centerline treatment shall consist of a minimum of 400 feet of solid line in advance of the intersection and shall be paired with either a solid or dashed line depending on sight distance availability in the opposing lane.

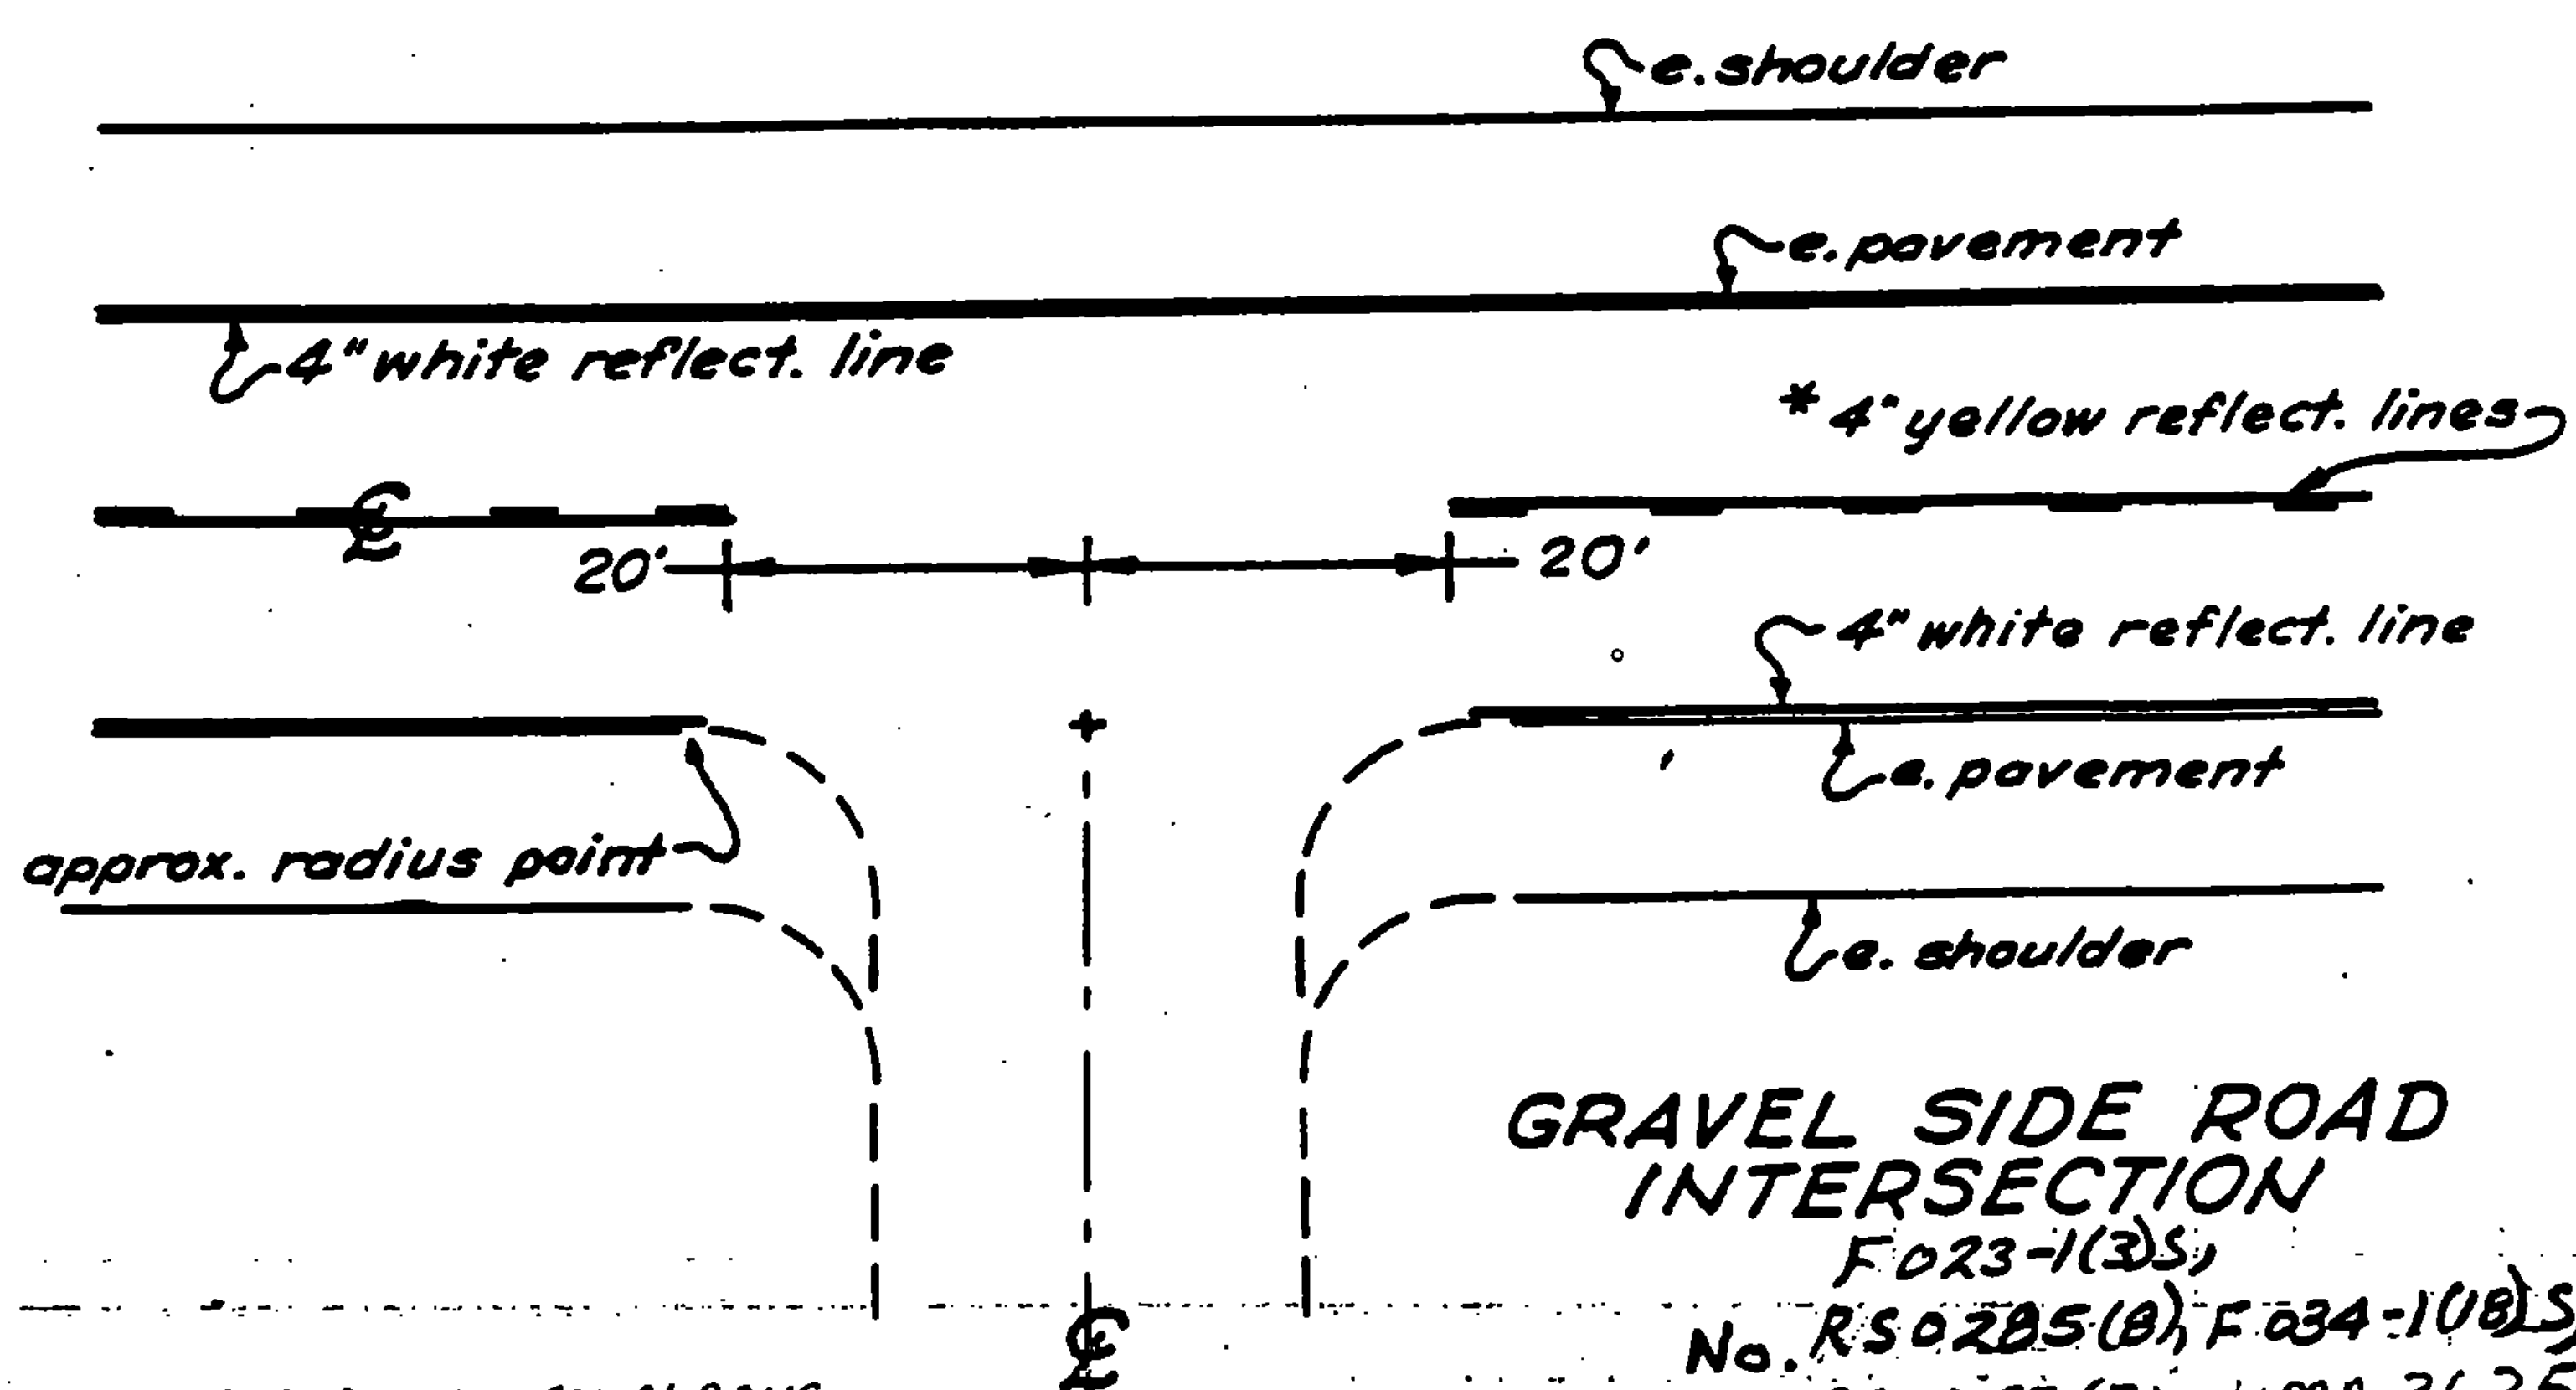

GRAVEL SIDE ROAD INTERSECTION
 F023-1(2S)
 No. RS0205(0), F034-1(0)S,
 RS0297(7), HMA 2625
 SHEET 6 OF 52 SHEETS