


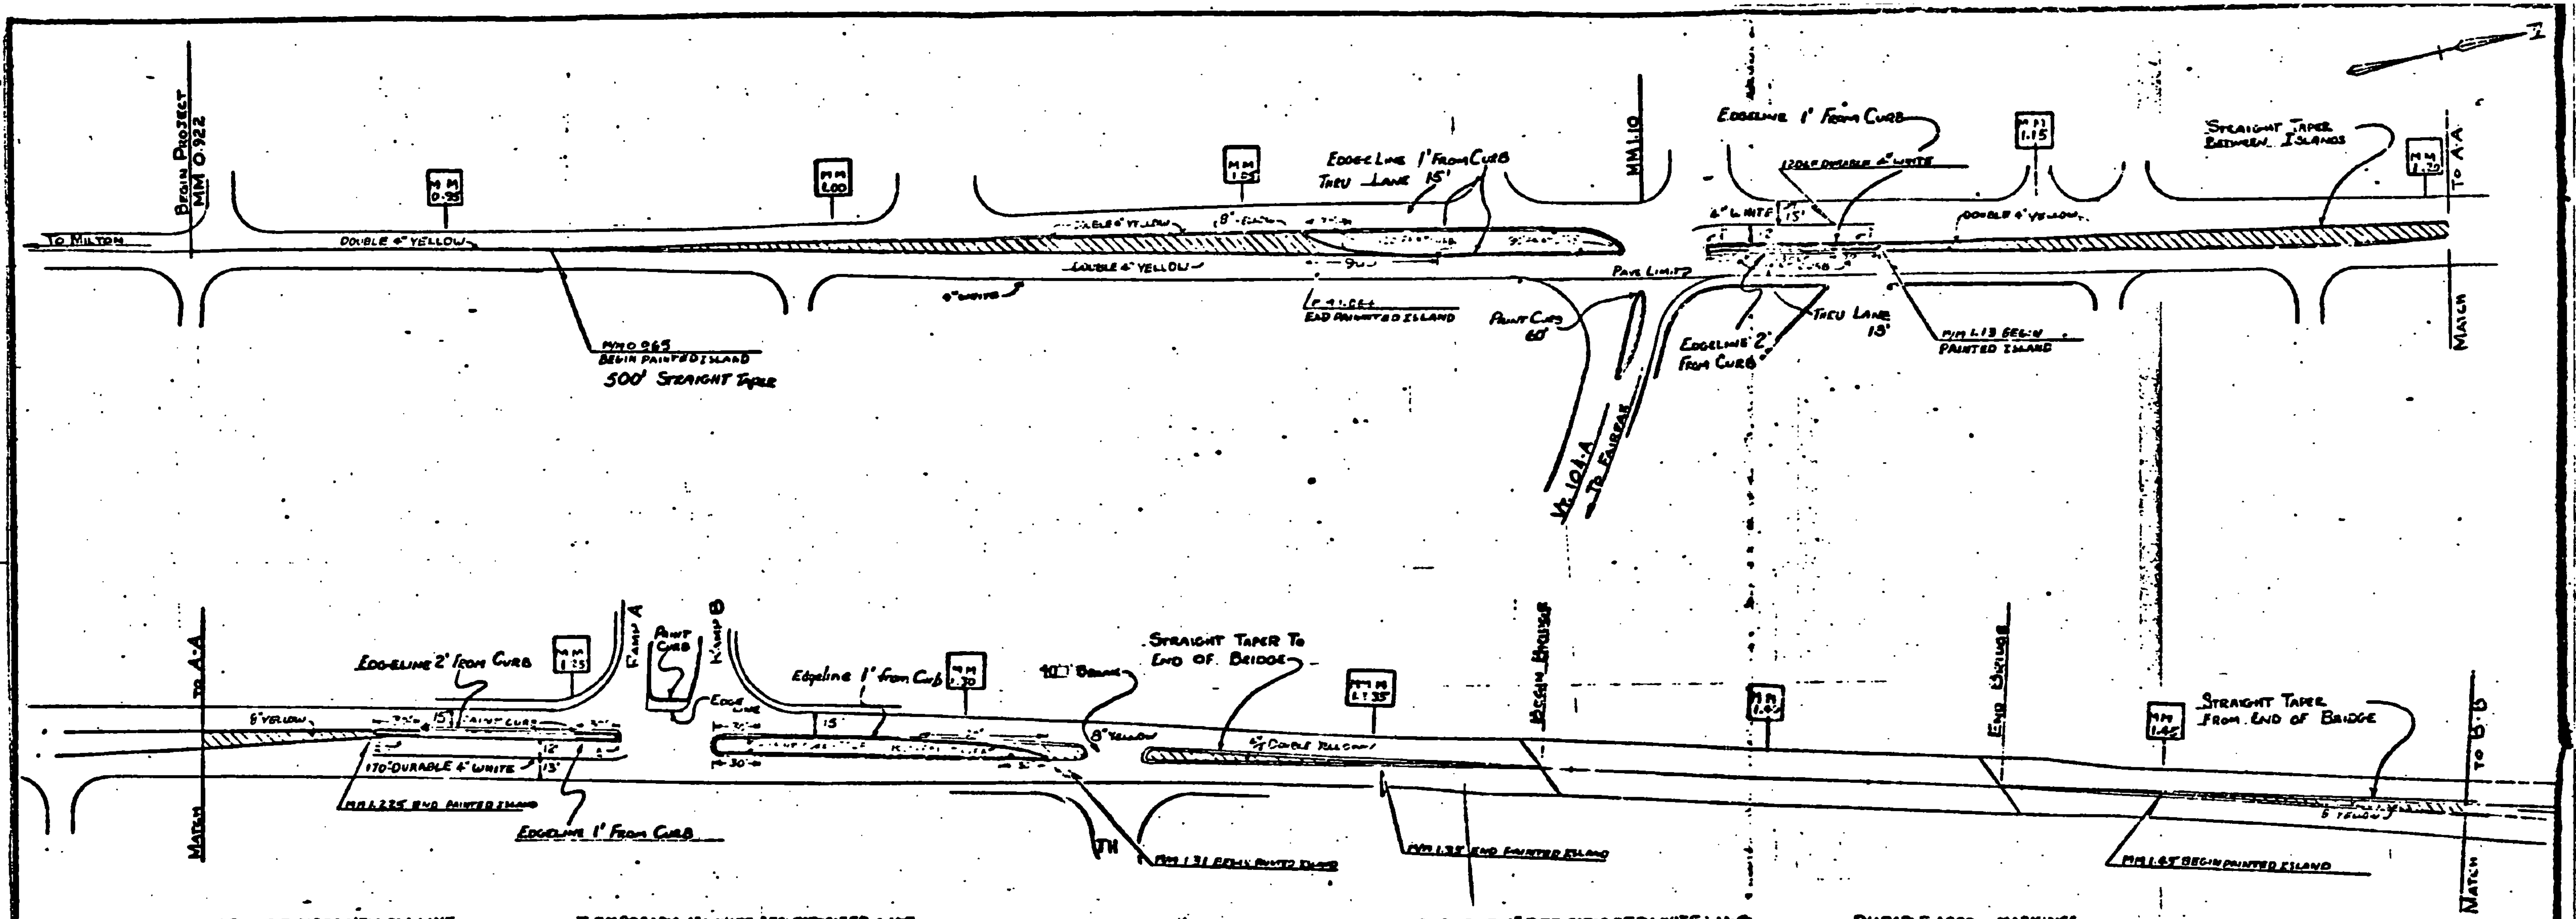


TEMPORARY 4" REFLECTORIZED YELLOW LINE

MM	0.920	- 0.965	=	340 LF ± 2
	0.965	- 1.060	=	500 LF ± 4
	1.060	- 1.100	=	210 LF ± 2
	1.110	- 1.113	=	115 LF ± 2
	1.13	- 1.225	=	500 LF ± 4
	1.225	- 1.266	=	165 LF ± 2
	1.266	- 1.310	=	220 LF ± 2
	1.310	- 1.323	=	45 LF ± 2
	1.323	- 1.390	=	260 LF ± 2
	1.390	- 1.438	=	312 LF ± 2
	1.438	- 1.530	=	488 LF ± 4
	1.530	- 1.577	=	250 LF ± 2
	1.577	- 1.640	=	335 LF ± 2
	1.640	- 1.795	=	510 LF ± 4
	1.795	- 1.950	=	345 LF ± 2

± LOST DURING SHIMMING (25')

TEMPORARY 4" WHITE REFLECTORIZED LINE
MM 0.922 - 1.850 = 4650 LF ± 2

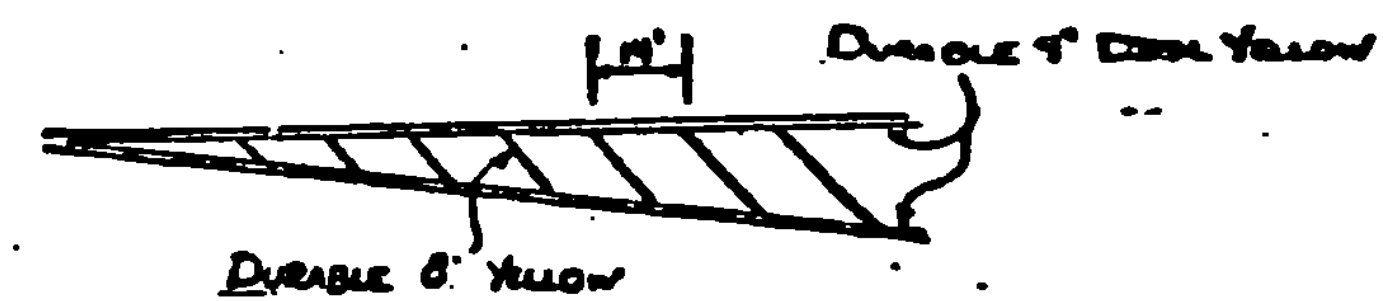


DURABLE 8" REFLECTORIZED YELLOW LINES
MM 0.965 - 1.06 PAINTED ISLAND
MM 1.13 - 1.225 PAINTED ISLAND
MM 1.31 - 1.35 PAINTED ISLAND
MM 1.430 - 1.53 PAINTED ISLAND
MM 1.69 - 1.76 PAINTED ISLAND

PAINTED CURB
Island - MM 1.06
Island - MM 1.10
Island - MM 1.12
Island - MM 1.24
Island - MM 1.26
Island - MM 1.28
Island - MM 1.35
Island - MM 1.43
Island - MM 1.65

DURABLE 4" REFLECTORIZED WHITE LINE
MM 1.12 LT-LT TURN LANE
MM 1.24 RT-LT TURN LANE
MM 1.60 LT-LT TURN LANE

DURABLE ARROW MARKINGS
MM 1.12 LT-LT TURN LANE
MM 1.24 RT-LT TURN LANE
MM 1.60 LT-LT TURN LANE

DURABLE LETTER IN WORD MARKINGS
MM 1.12 LT-LT TURN LANE - ONLY, ONLY
MM 1.24 RT-LT TURN LANE - ONLY, ONLY
MM 1.60 LT-LT TURN LANE - ONLY, ONLY

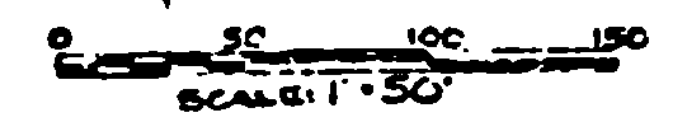

DATUM
VERTICAL _____
HORIZONTAL _____

F023-1(3)S
SHEET 14 OF 52

SURVEYED BY	DATE
DRAWN BY JFM	DATE
TRACED BY JFM	DATE
GEORGIA - U.S. Rte. 7	
PROJ. HMA	NO. 2636
DATE	OF 34