


TYPICAL SECTIONS & DESIGN DATA

ITEM 406.25 BITUMINOUS CONCRETE PAVEMENT
 LEVELING COURSE, TYPE III OR IV (SEE TABLE BELOW)
 AS DIRECTED BY THE ENGINEER
 1" WEARING COURSE, TYPE III

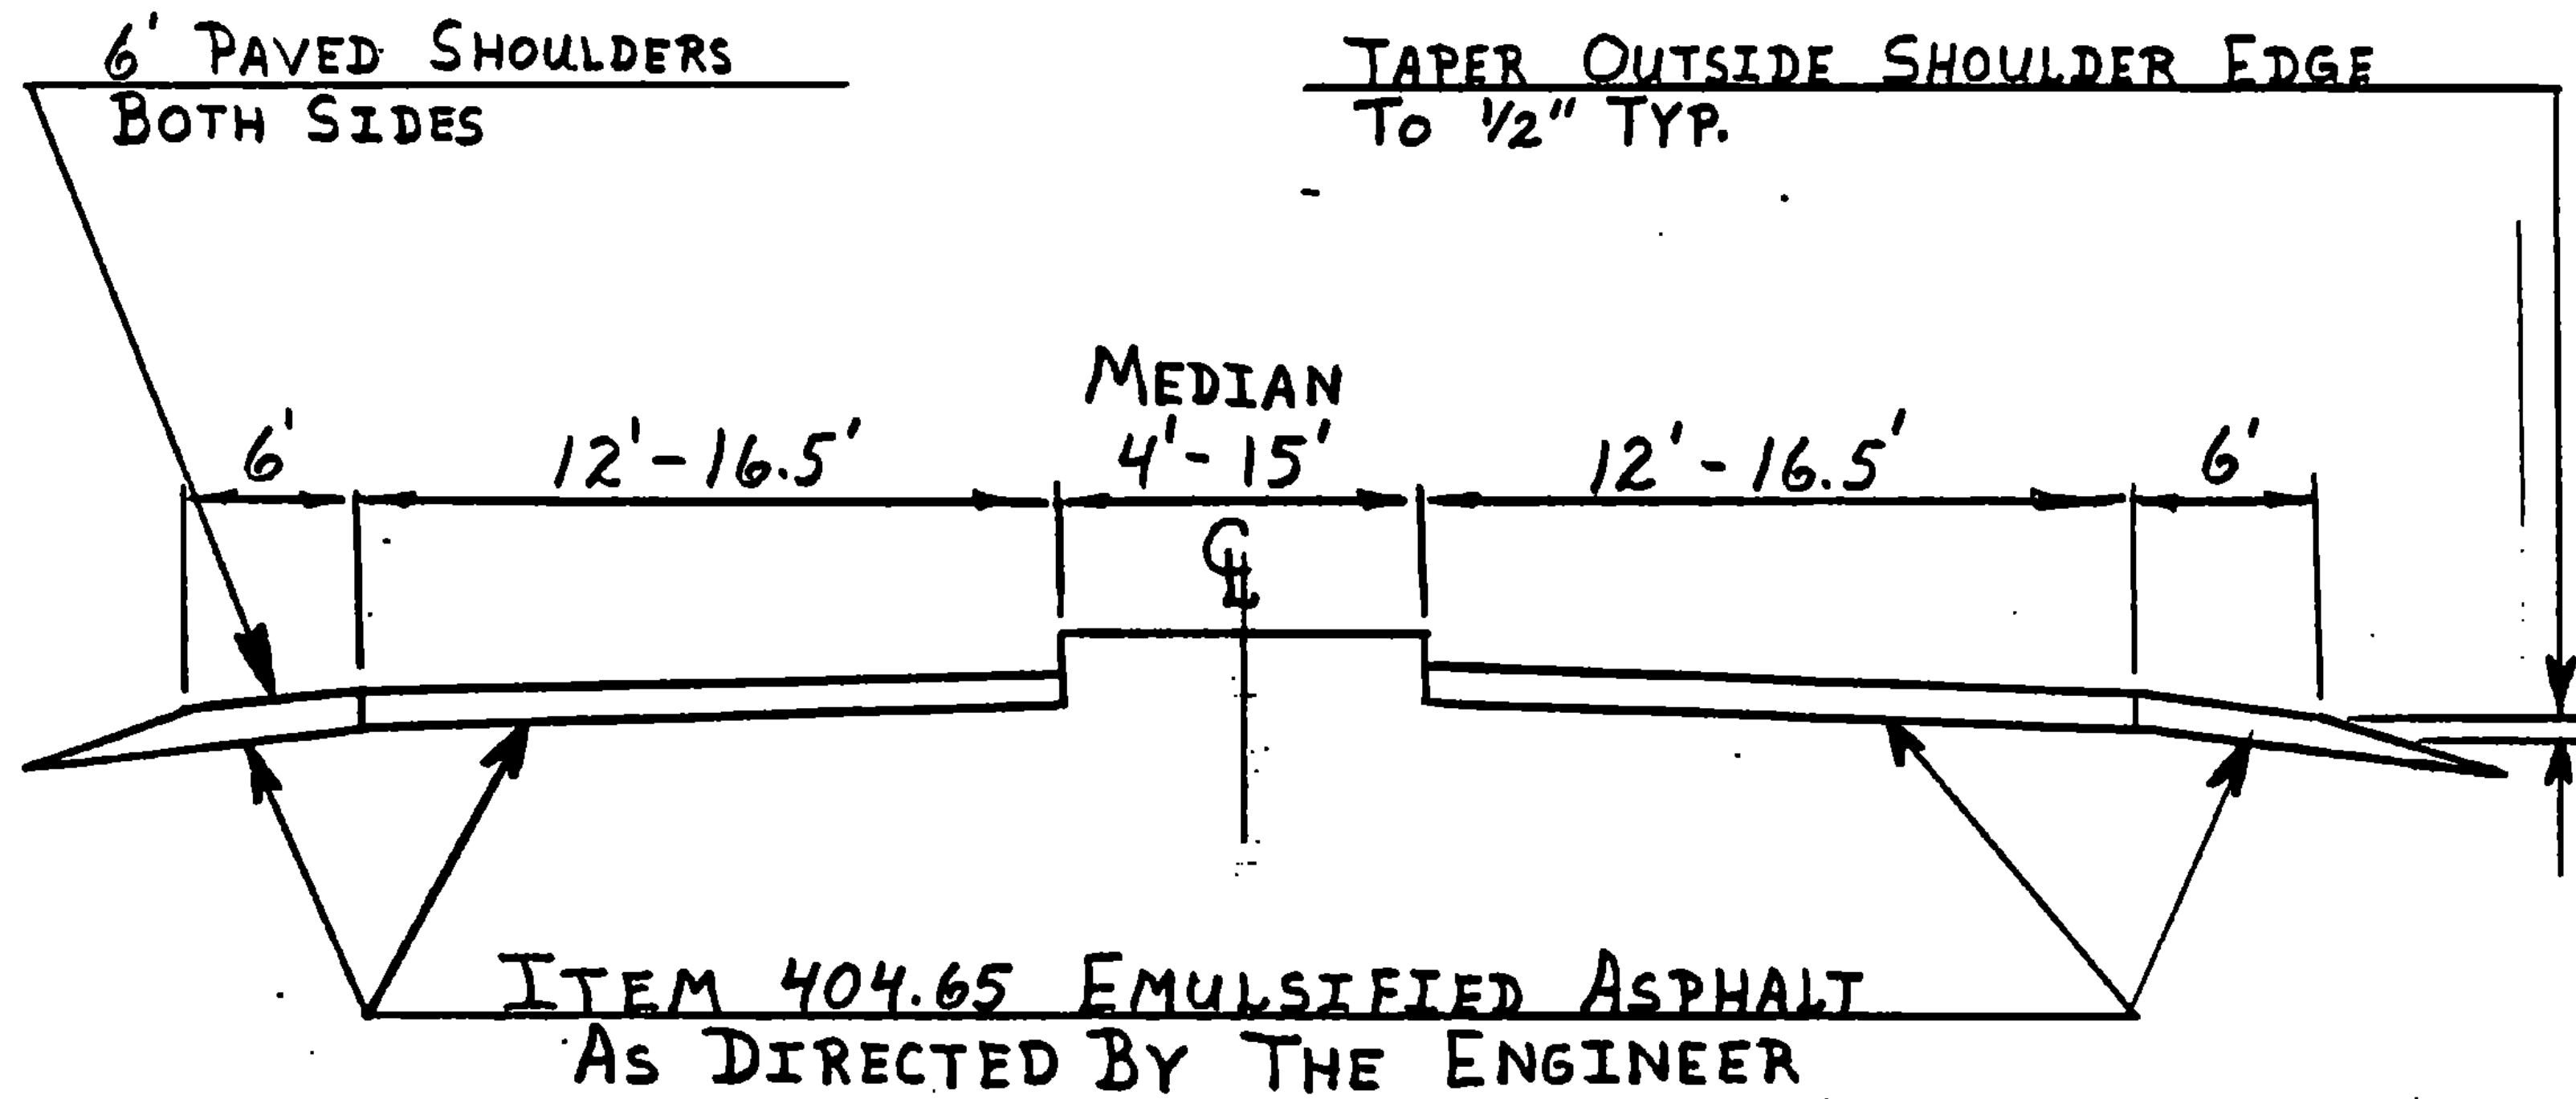

DISTANCE	WIDTH PAVED SHOULDER	WIDTH TRAVELED WAY	WIDTH UNPAVED MEDIAN	WIDTH PAVED SHOULDER	LEVEL TONNAGE/MILE
MM 1.06-1.103	6	33	15	6	375
MM 1.54-1.58	6	24	12	6	273
MM 1.59-1.69	6	24	4-12	6	273