



SIDE ROAD

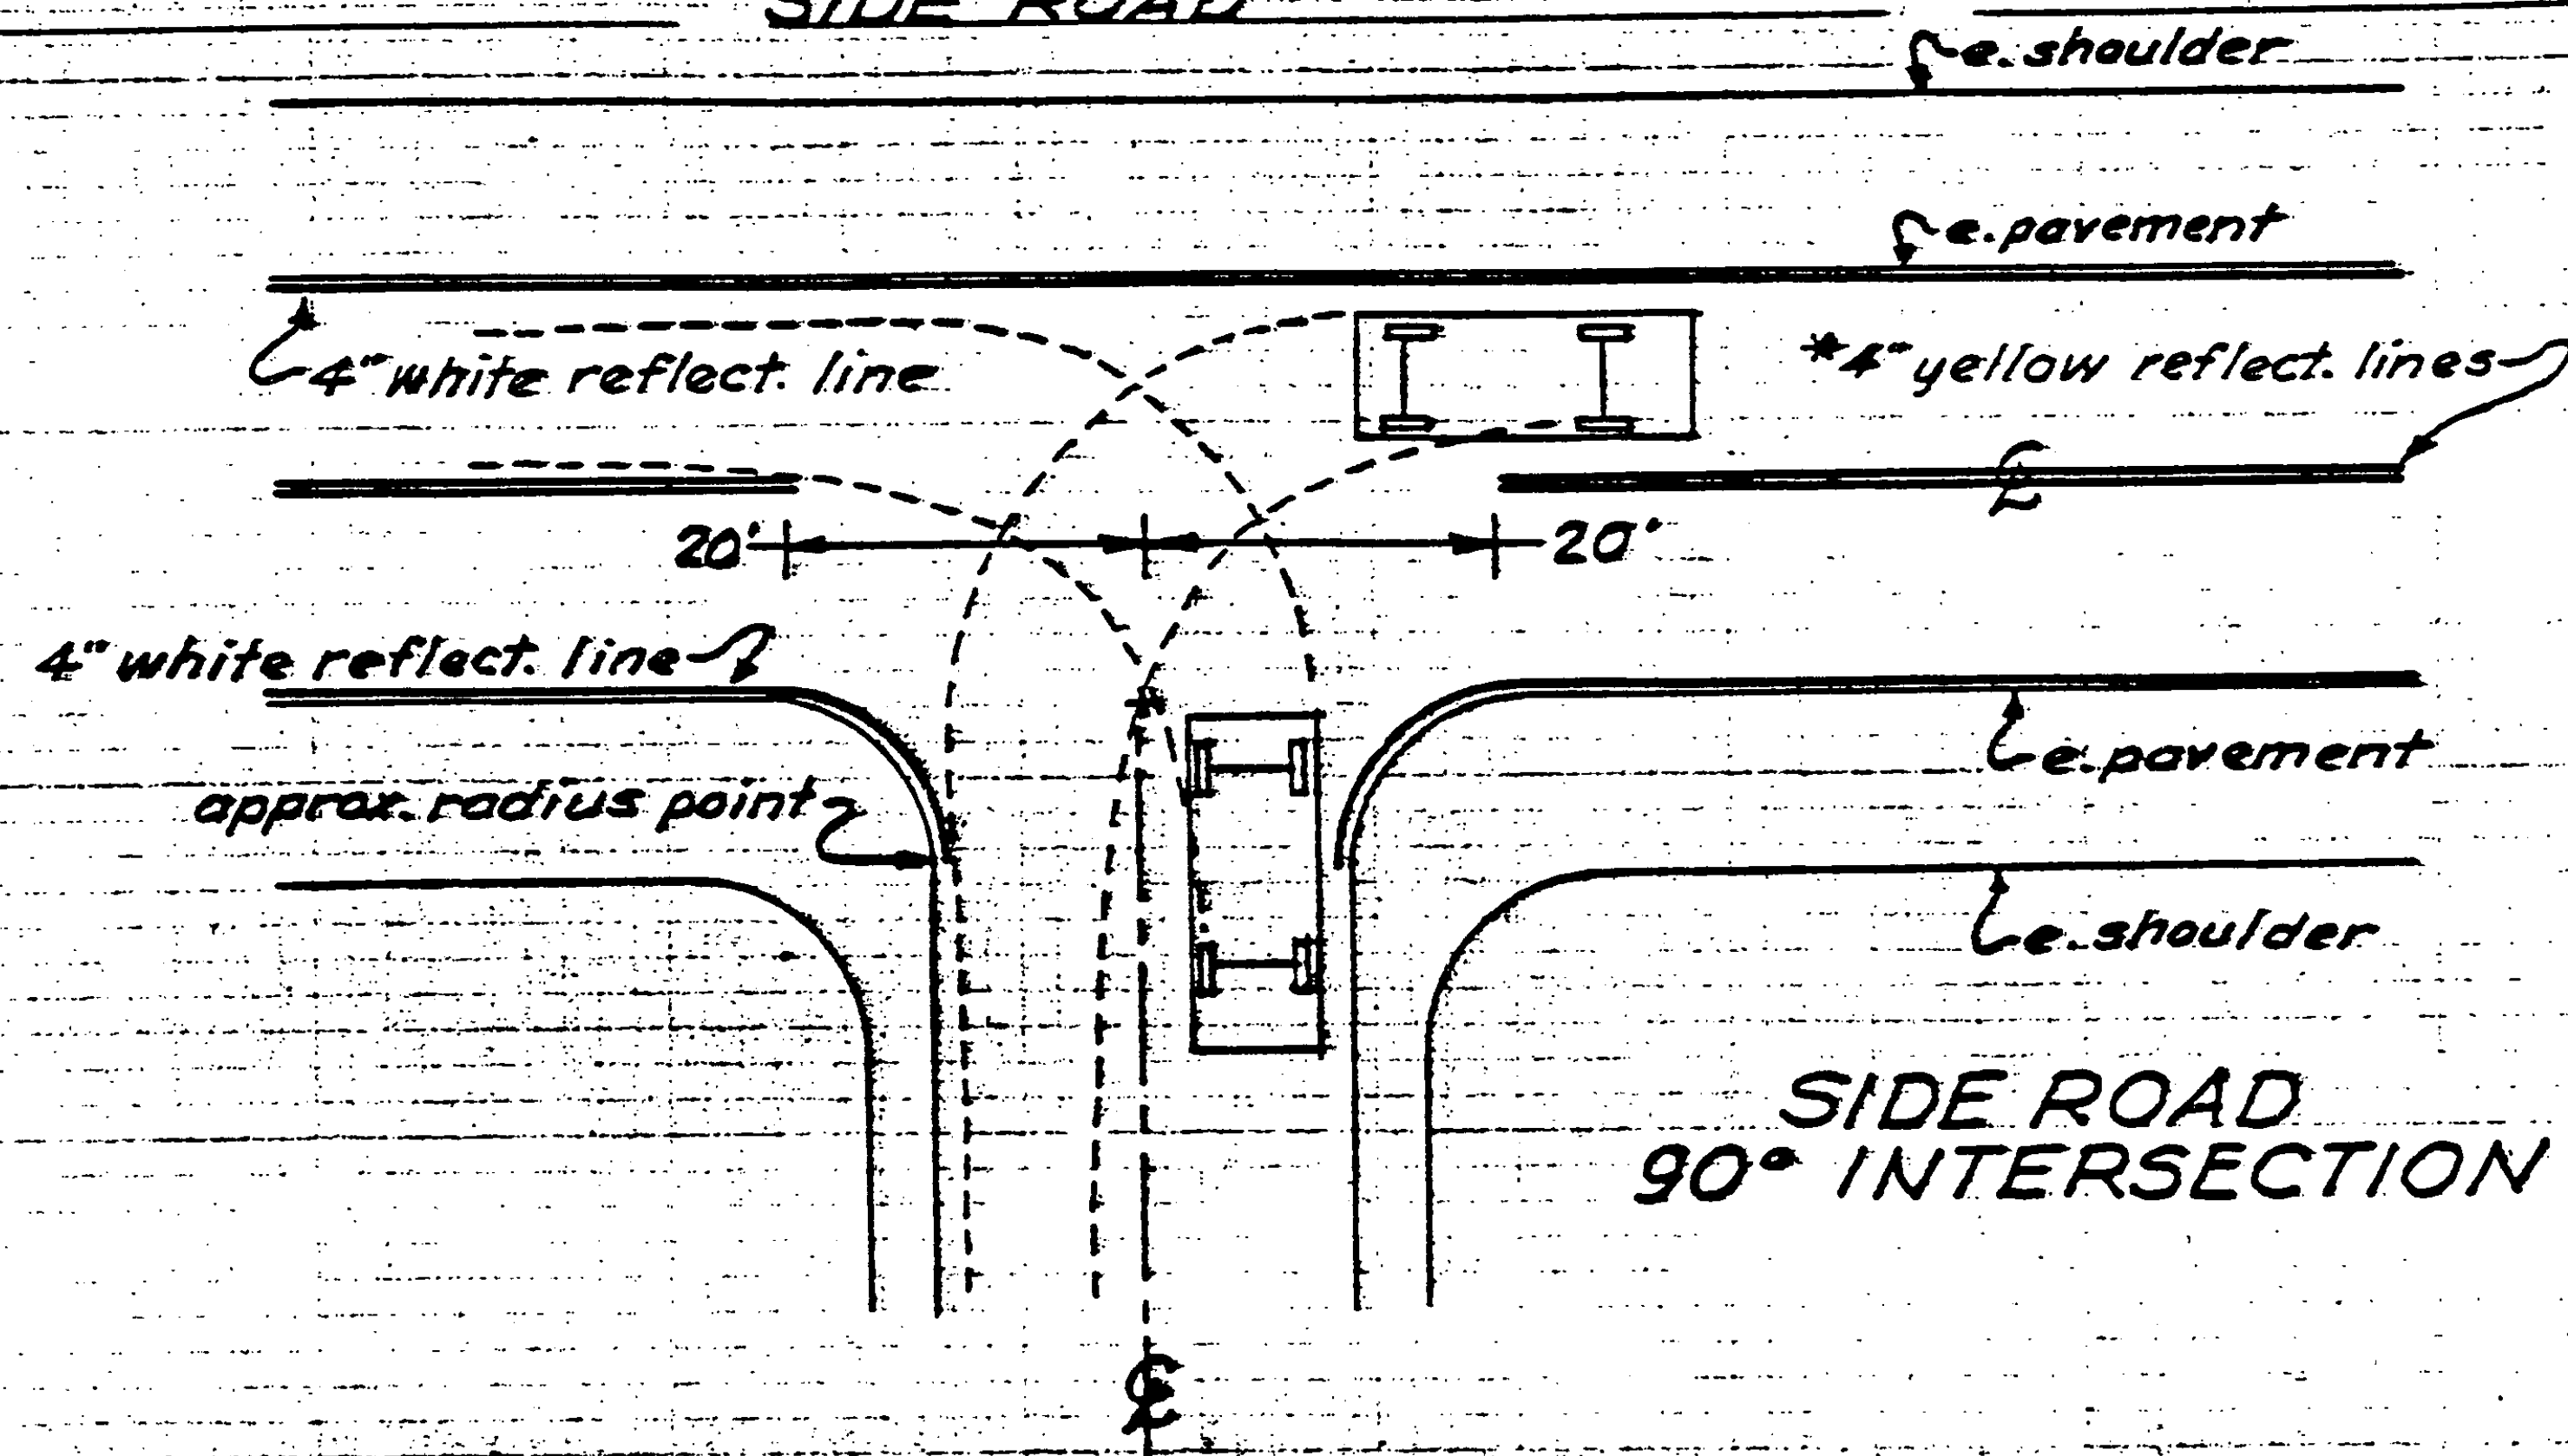

* Centerline treatment shall consist of a minimum of 400 feet of solid line in advance of the intersection and shall be paired with either a solid or dashed line depending on sight distance availability in the opposing lane.

e. shoulder

e. pavement

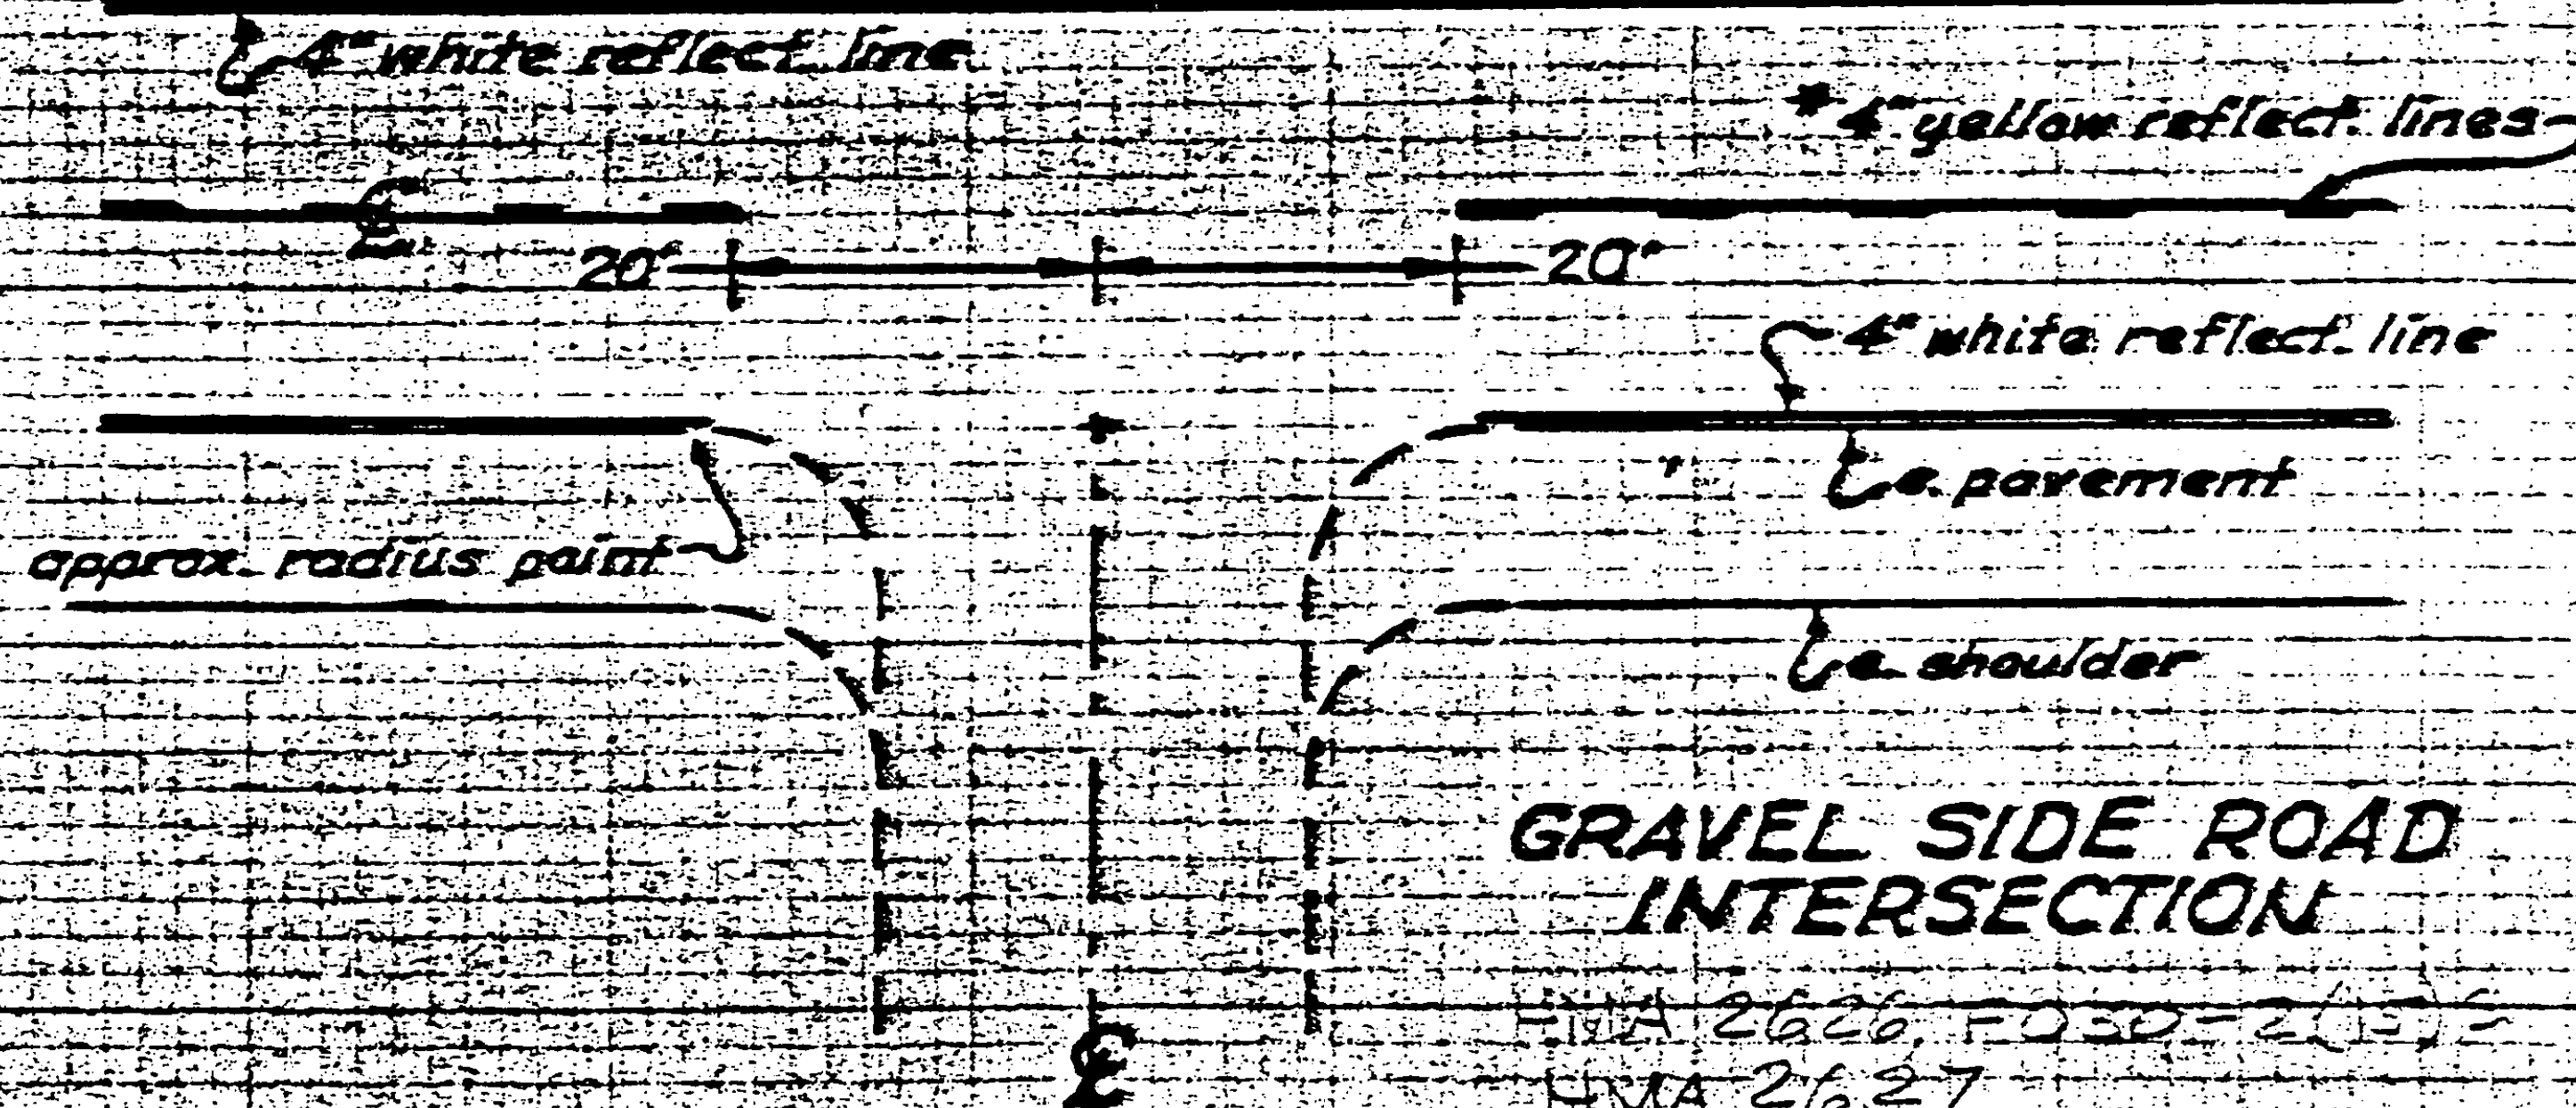

GRAVEL SIDE ROAD INTERSECTION

HMA 2626, F030-2(3)E
HMA 2627

CAMBRIDGE - JOHNSON

SHEET 6 OF 31