


APPROACH TO A RAILROAD GRADE CROSSING

A solid line in the direction of travel is begun at a location 35 feet in advance of the advance warning sign. This sign is normally 750 feet or more in advance of the crossing. Consult the MUTCD for actual sign placement. (Centerline marking other than that shown by dimension lines are for example only).

NOTE:

1. SEE SIGN REMOVAL NOTES ON NEXT SHEET
2. RAILROAD CROSSING SYMBOLS (ITEM 646.30 AND ITEM 646.67) SHALL CONSIST OF THE X AND RR AND ALL LINES OR BARS.

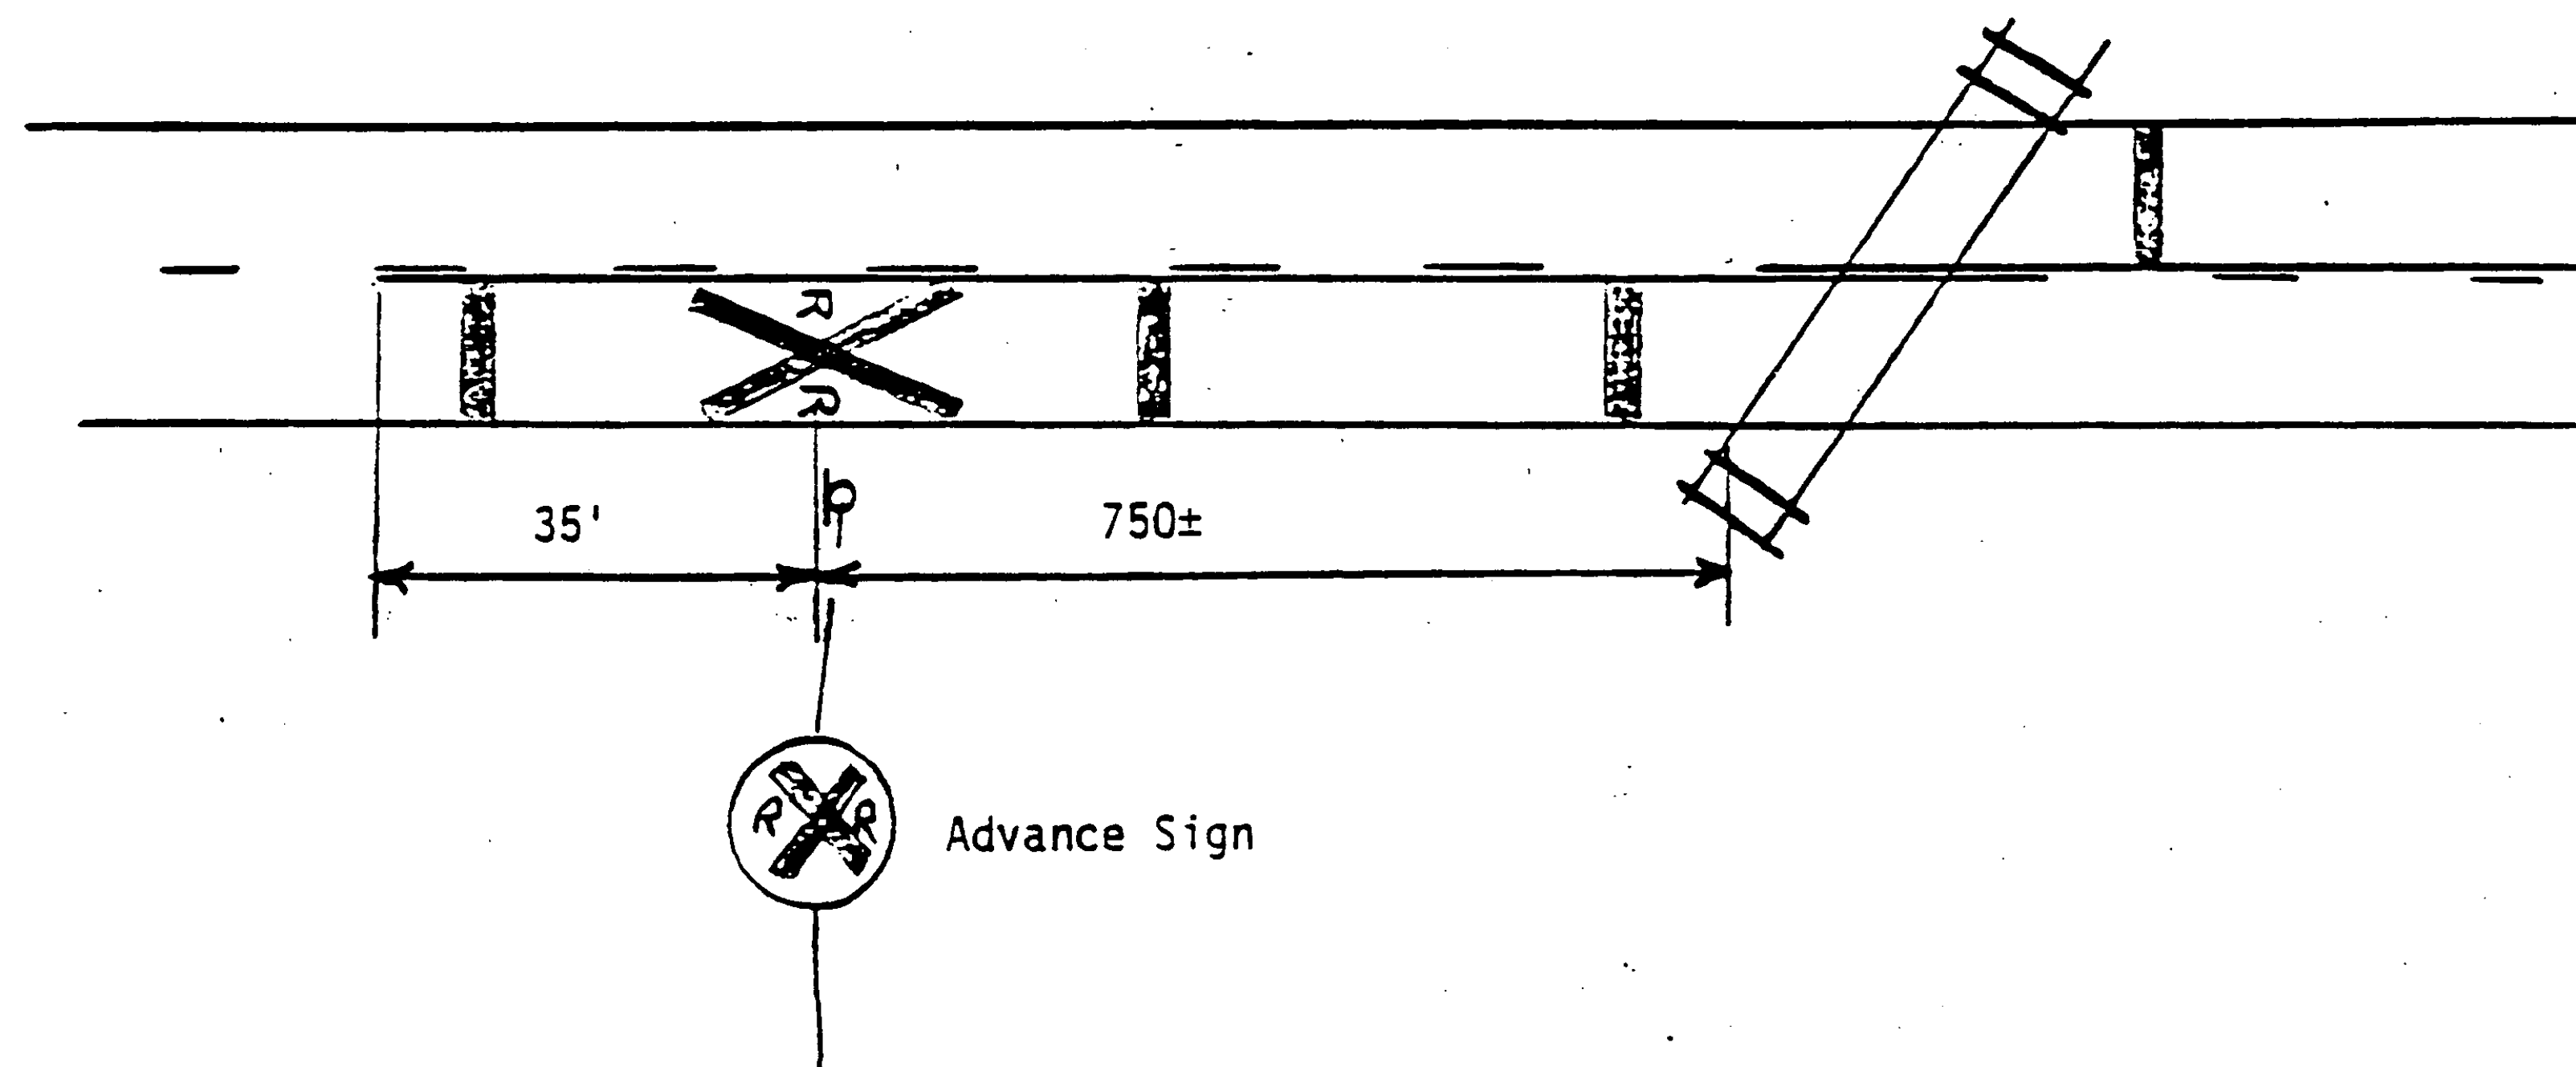

CAMBRIDGE-JOHNSON

HMA 2626 SHEET 11 of 31