


TYPICAL SECTIONS & DESIGN DATA

ITEM 406.25 BITUMINOUS CONCRETE PAVEMENT
LEVELING COURSE, TYPE III OR IV (42' WIDE @ 477 TPA) (1)
AS DIRECTED BY THE ENGINEER
1/2" - WEARING COURSE, TYPE III

10' PAVED SHOULDERS BOTH SIDES (LEVEL & WEAR COURSE) TAPER OUTSIDE EDGE OF SHOULDER TO 1/2" (TYPICAL)

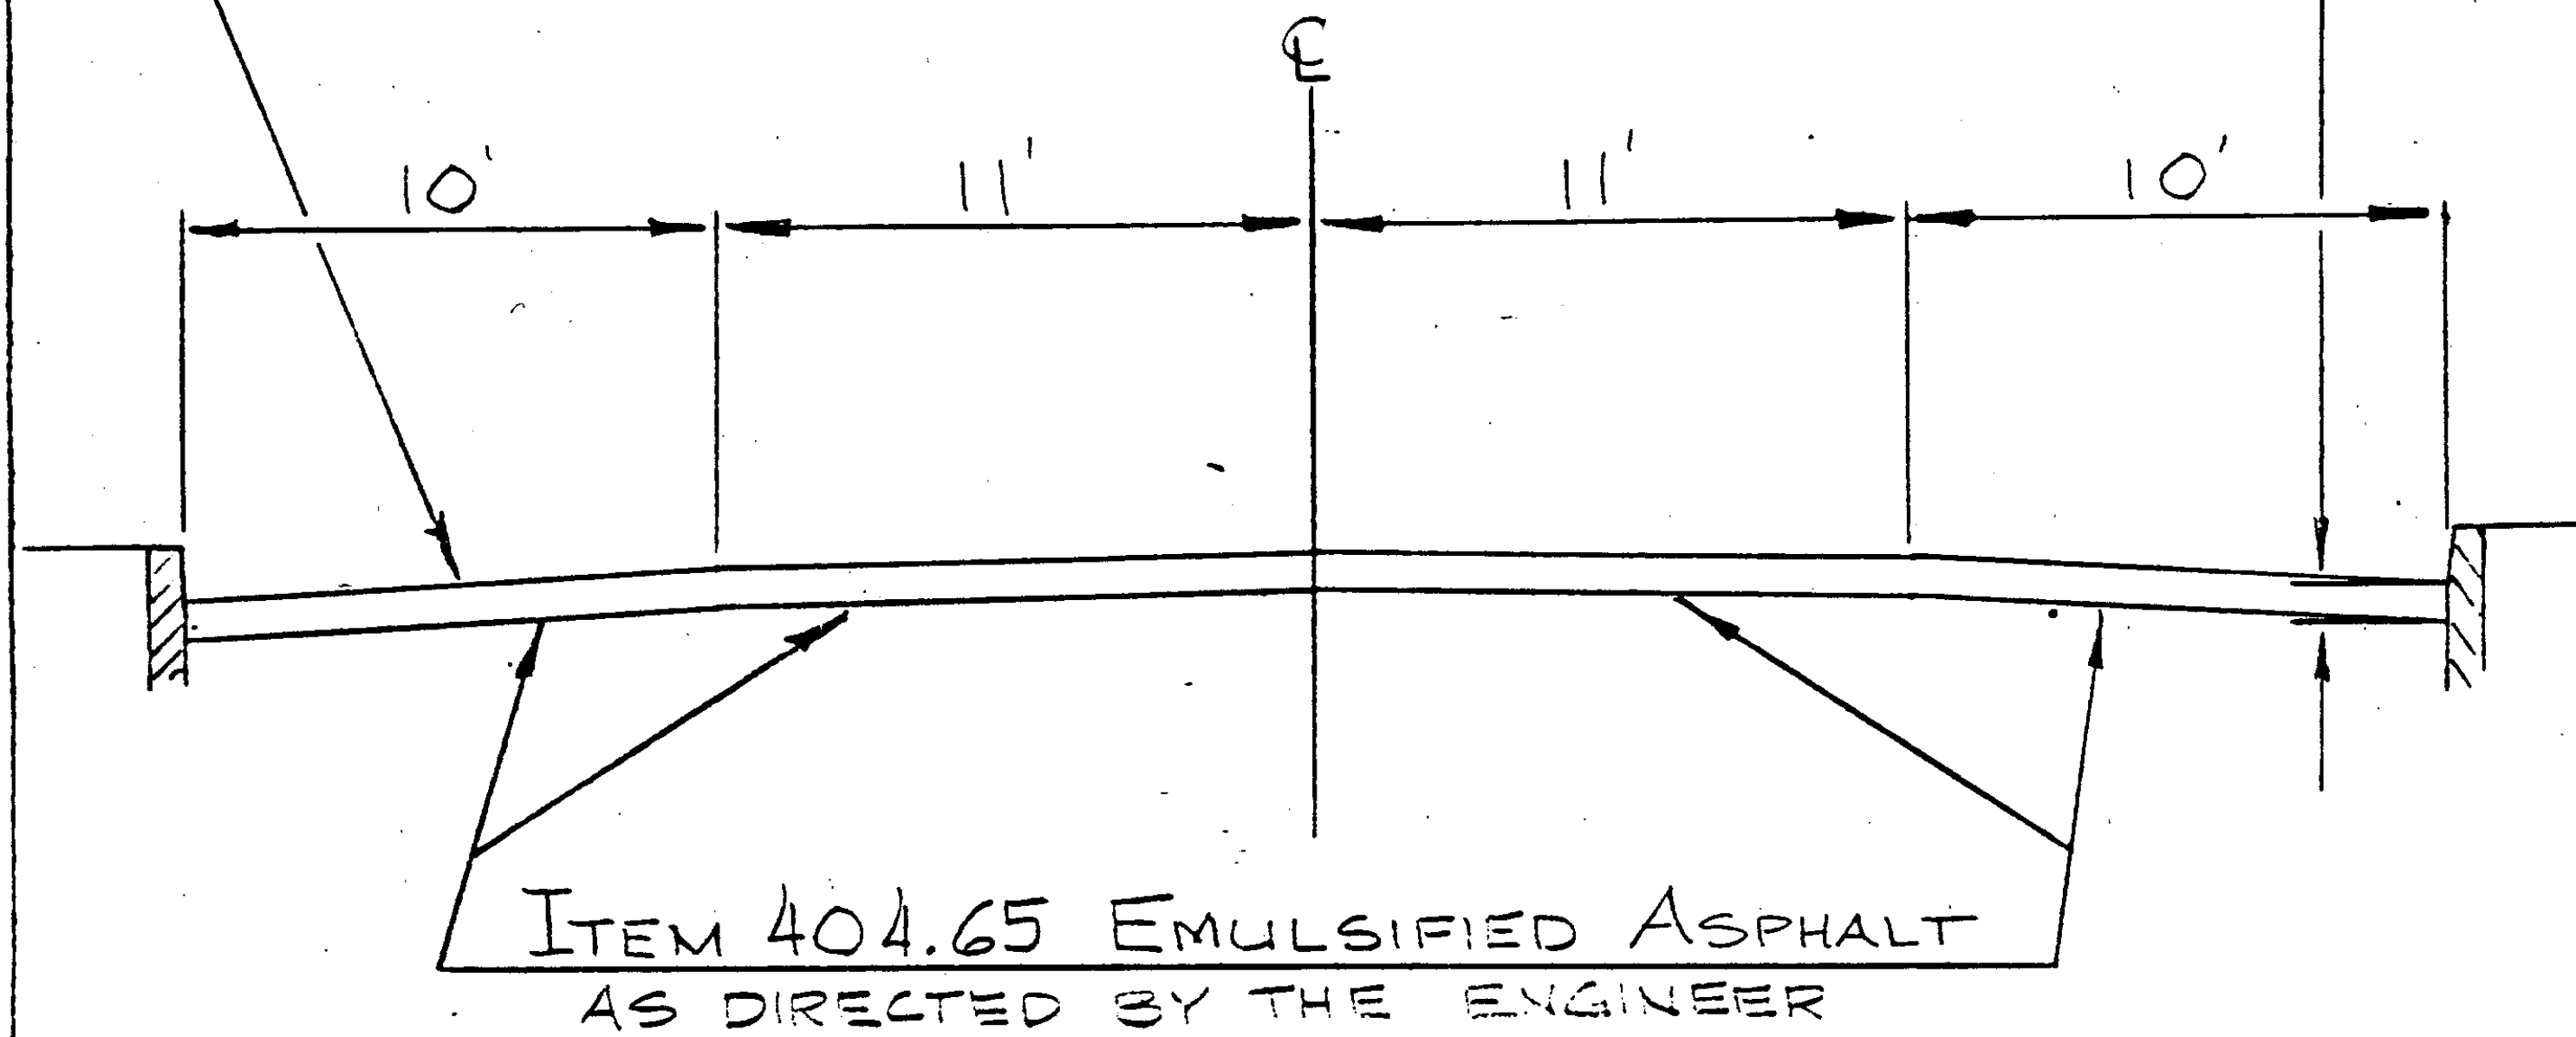

ITEM 404.65 EMULSIFIED ASPHALT
AS DIRECTED BY THE ENGINEER

JOHNSON MM 3.927 - MM 4.10

PROJECT JOHNSON

NO. F 030-2(15)S

SHEET 4 OF 3 SHEETS