


PROJECT DESCRIPTION AND LOCATION

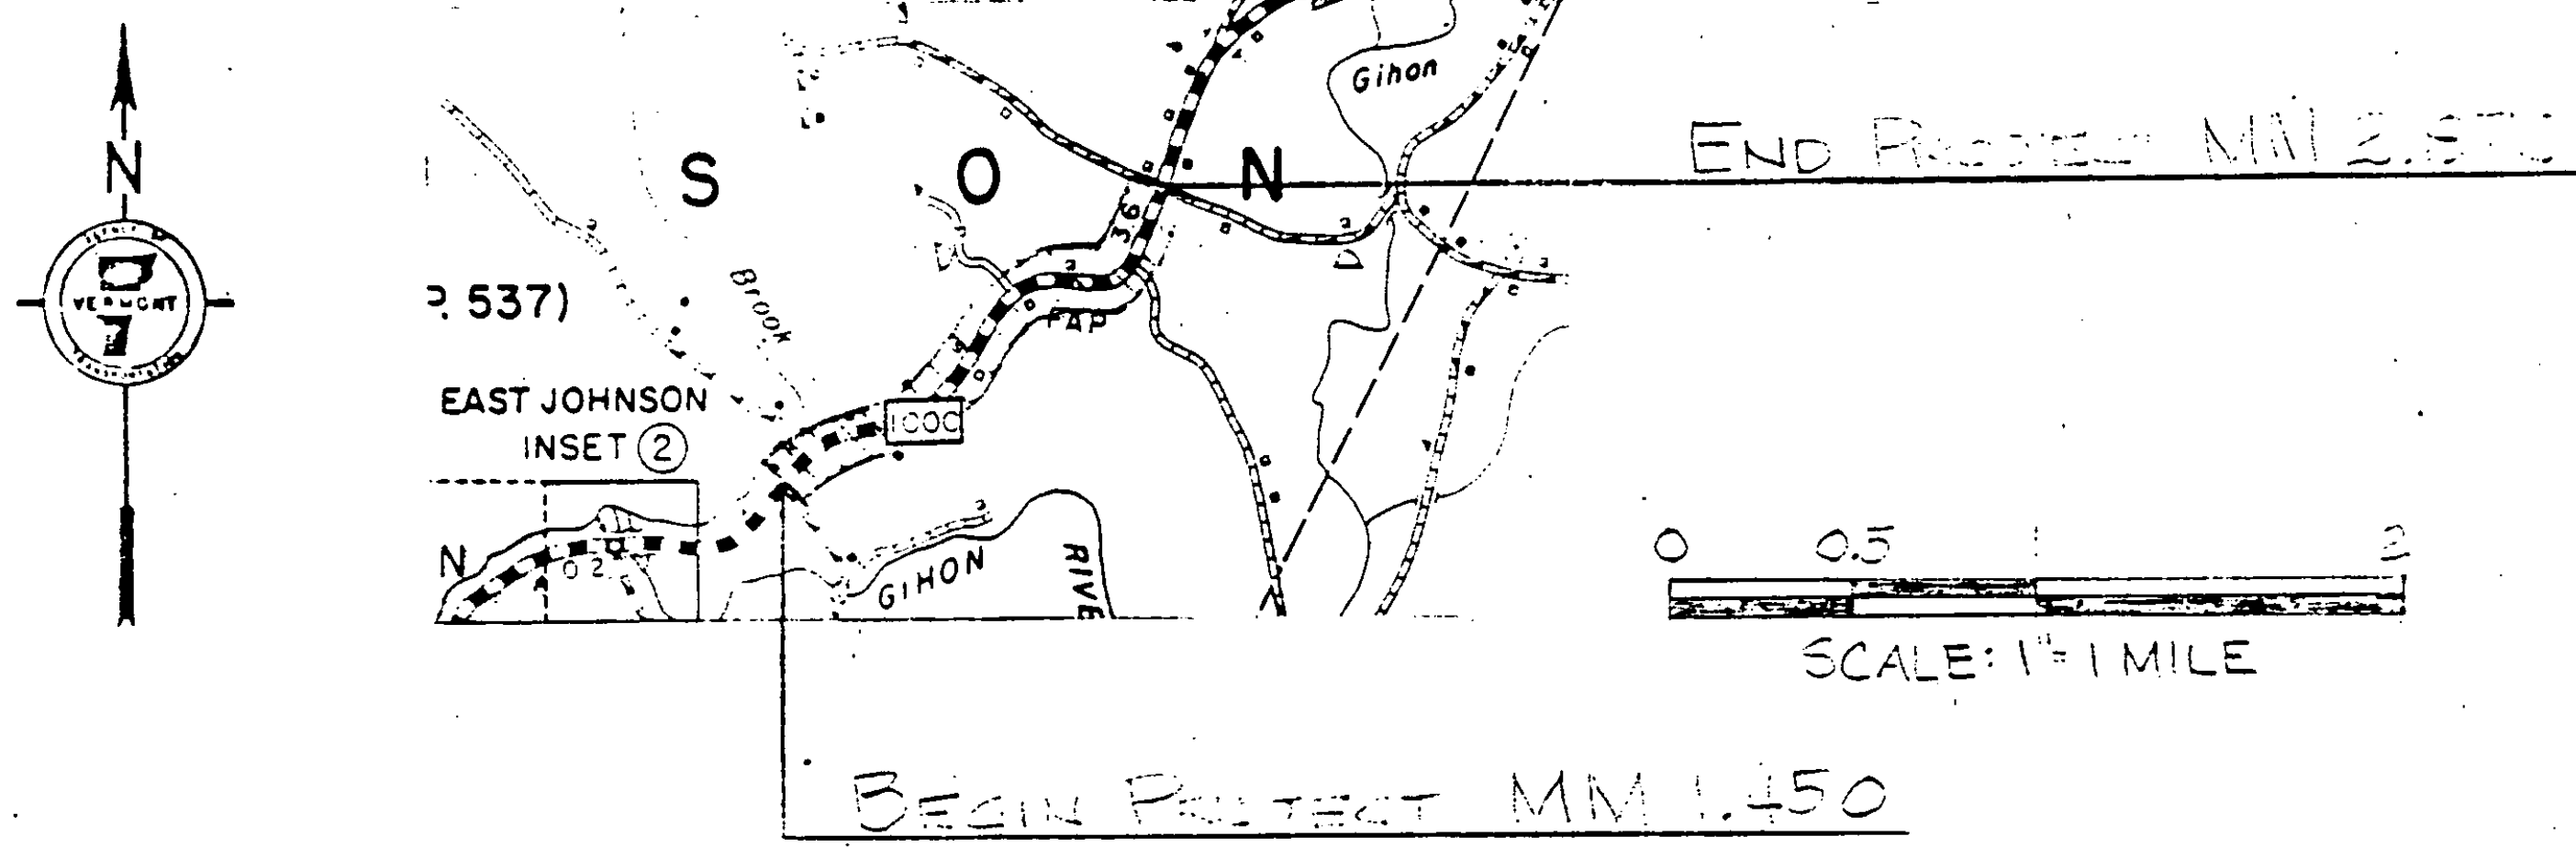

ON VT. RT. 100C, BEGINNING 1.450 MILES NORTHWEST
 OF THE INTERSECTION OF VT. RT. 15 AND VT. RT. 100C IN
 THE VILLAGE OF JOHNSON, AT MM 1.450 THEN NORTHERLY
 1.42 MILES TO MM 2.870. END OF PROJECT IS 1.645
 MILES SOUTHERLY OF THE JOHNSON-HYDE PARK ROAD.

LENGTH OF PROJECT: 1.420 MILES
 7498 FEET

MAP DATA
 1:1430
 1:1500

PROJECT _____

NO. MM 2607

SHEET 6 OF 31 SHEETS