


TYPICAL SECTIONS & DESIGN DATA

ITEM 406.25 BITUMINOUS CONCRETE PAVEMENT

LEVELING COURSE, TYPE III OR II 1/2 IN. THICK @ 300 TYP. MIN.

AS DIRECTED BY THE ENGINEER

3/4" WEARING COURSE, TYPE IV

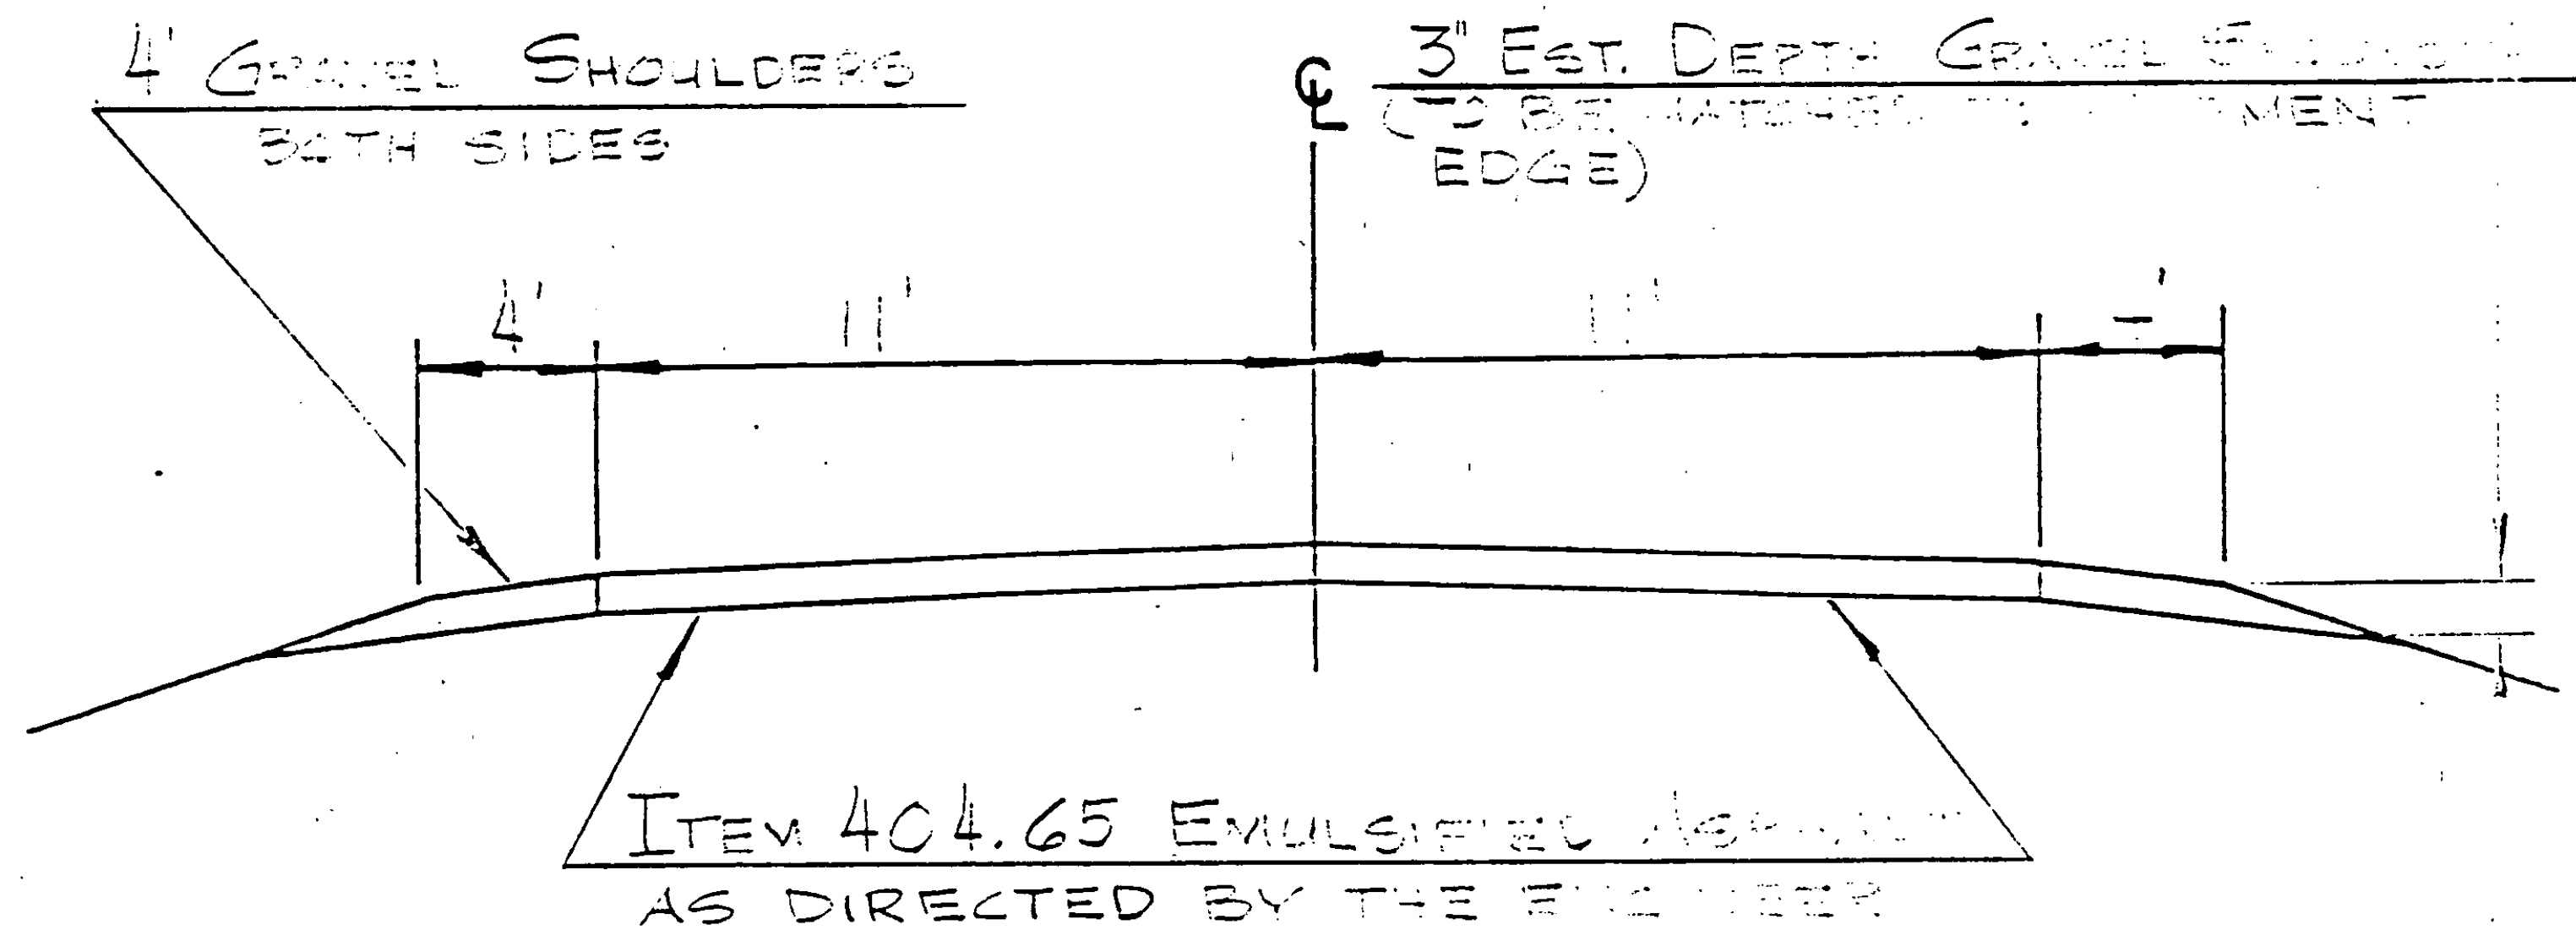

JOHNSON MM 1.450 - MM 2.500

PROJECT SENECA

NO. HMA 200

SHEET 12 OF 31 SHEETS