


PROJECT DESCRIPTION AND LOCATION

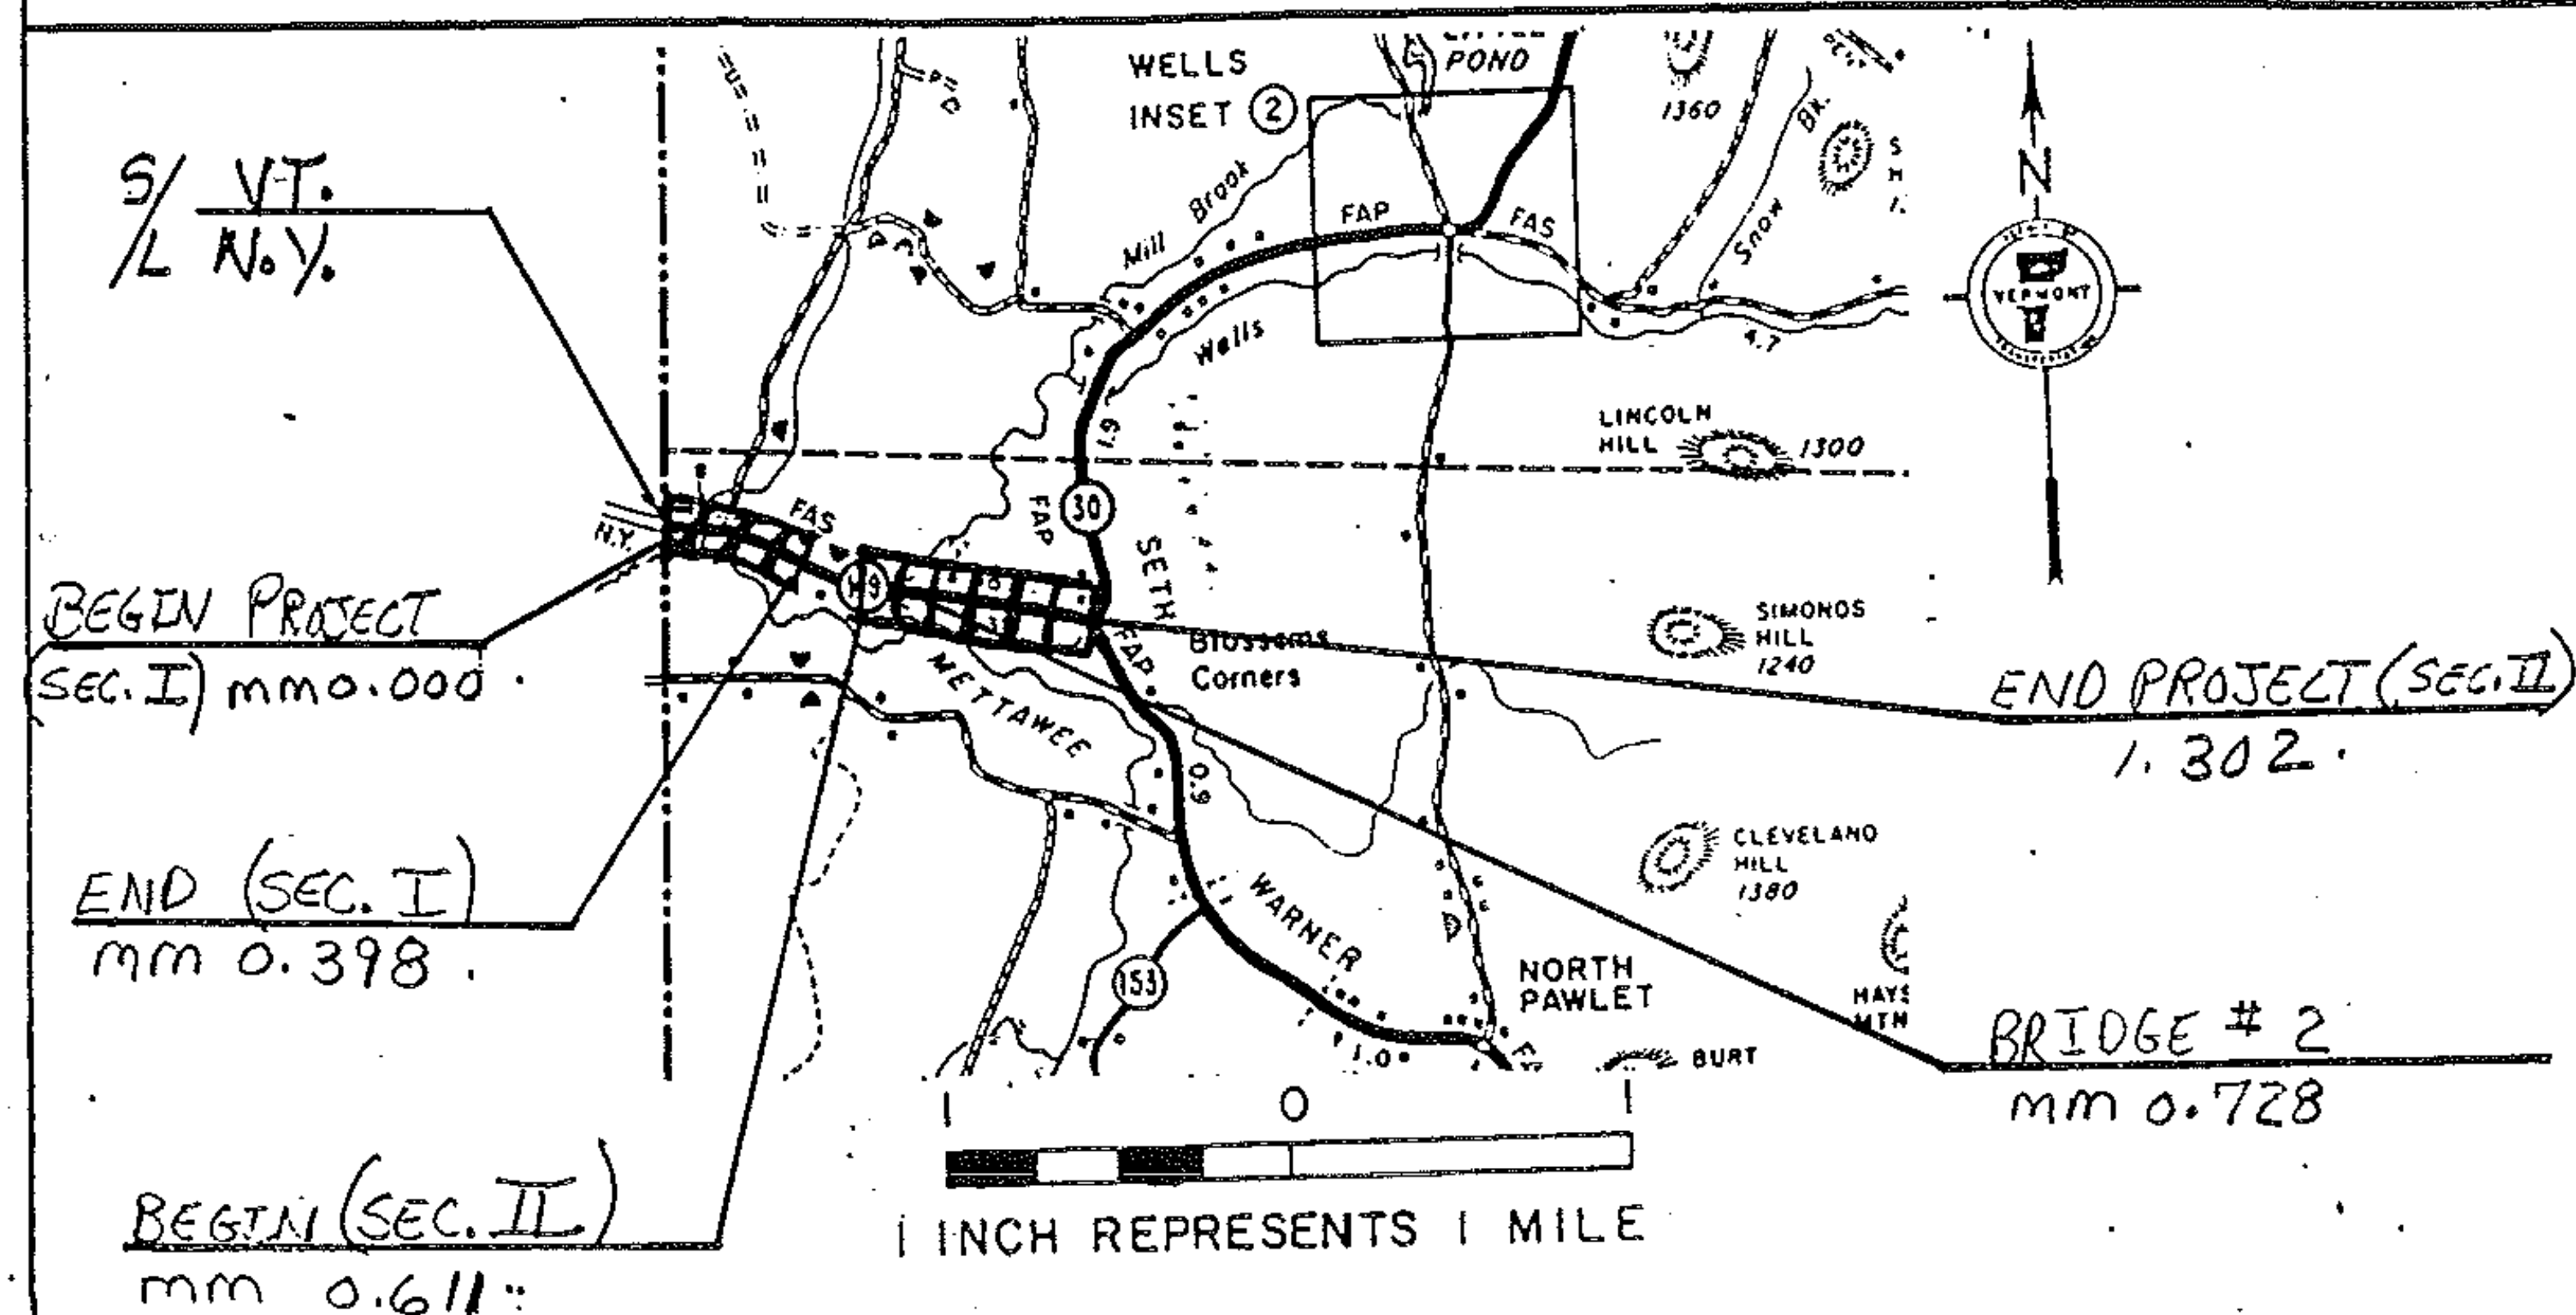

IN PAWLET, BEGINNING AT THE NY-VT. STATE LINE ON ROUTE VT. 149 (mm 0.000) AND EXTENDING EASTERLY FOR 0.398 MILES TO MM 0.398 (SEC. I). (SEC. II) BEGINNING AT A. POINT 0.611 MILES EAST OF THE NY-VT. STATE LINE AND EXTENDING EASTERLY FOR 0.691 MILES TO THE JCT. OF VT. 149 AND VT. 30 (MM 1.302).

TRAFFIC DATA

1982 ADT 2205

V=50 mph

LENGTH OF PROJECT: 1.089 miles
5749 feet

SEC. I: 0.398 miles
2101 feet

SEC. II: 0.691 miles
3648 feet

PROJECT PAWLET

NO. HMA 2629

SHEET 7 OF 35 SHEETS