


STOP BAR DETAILS

13.

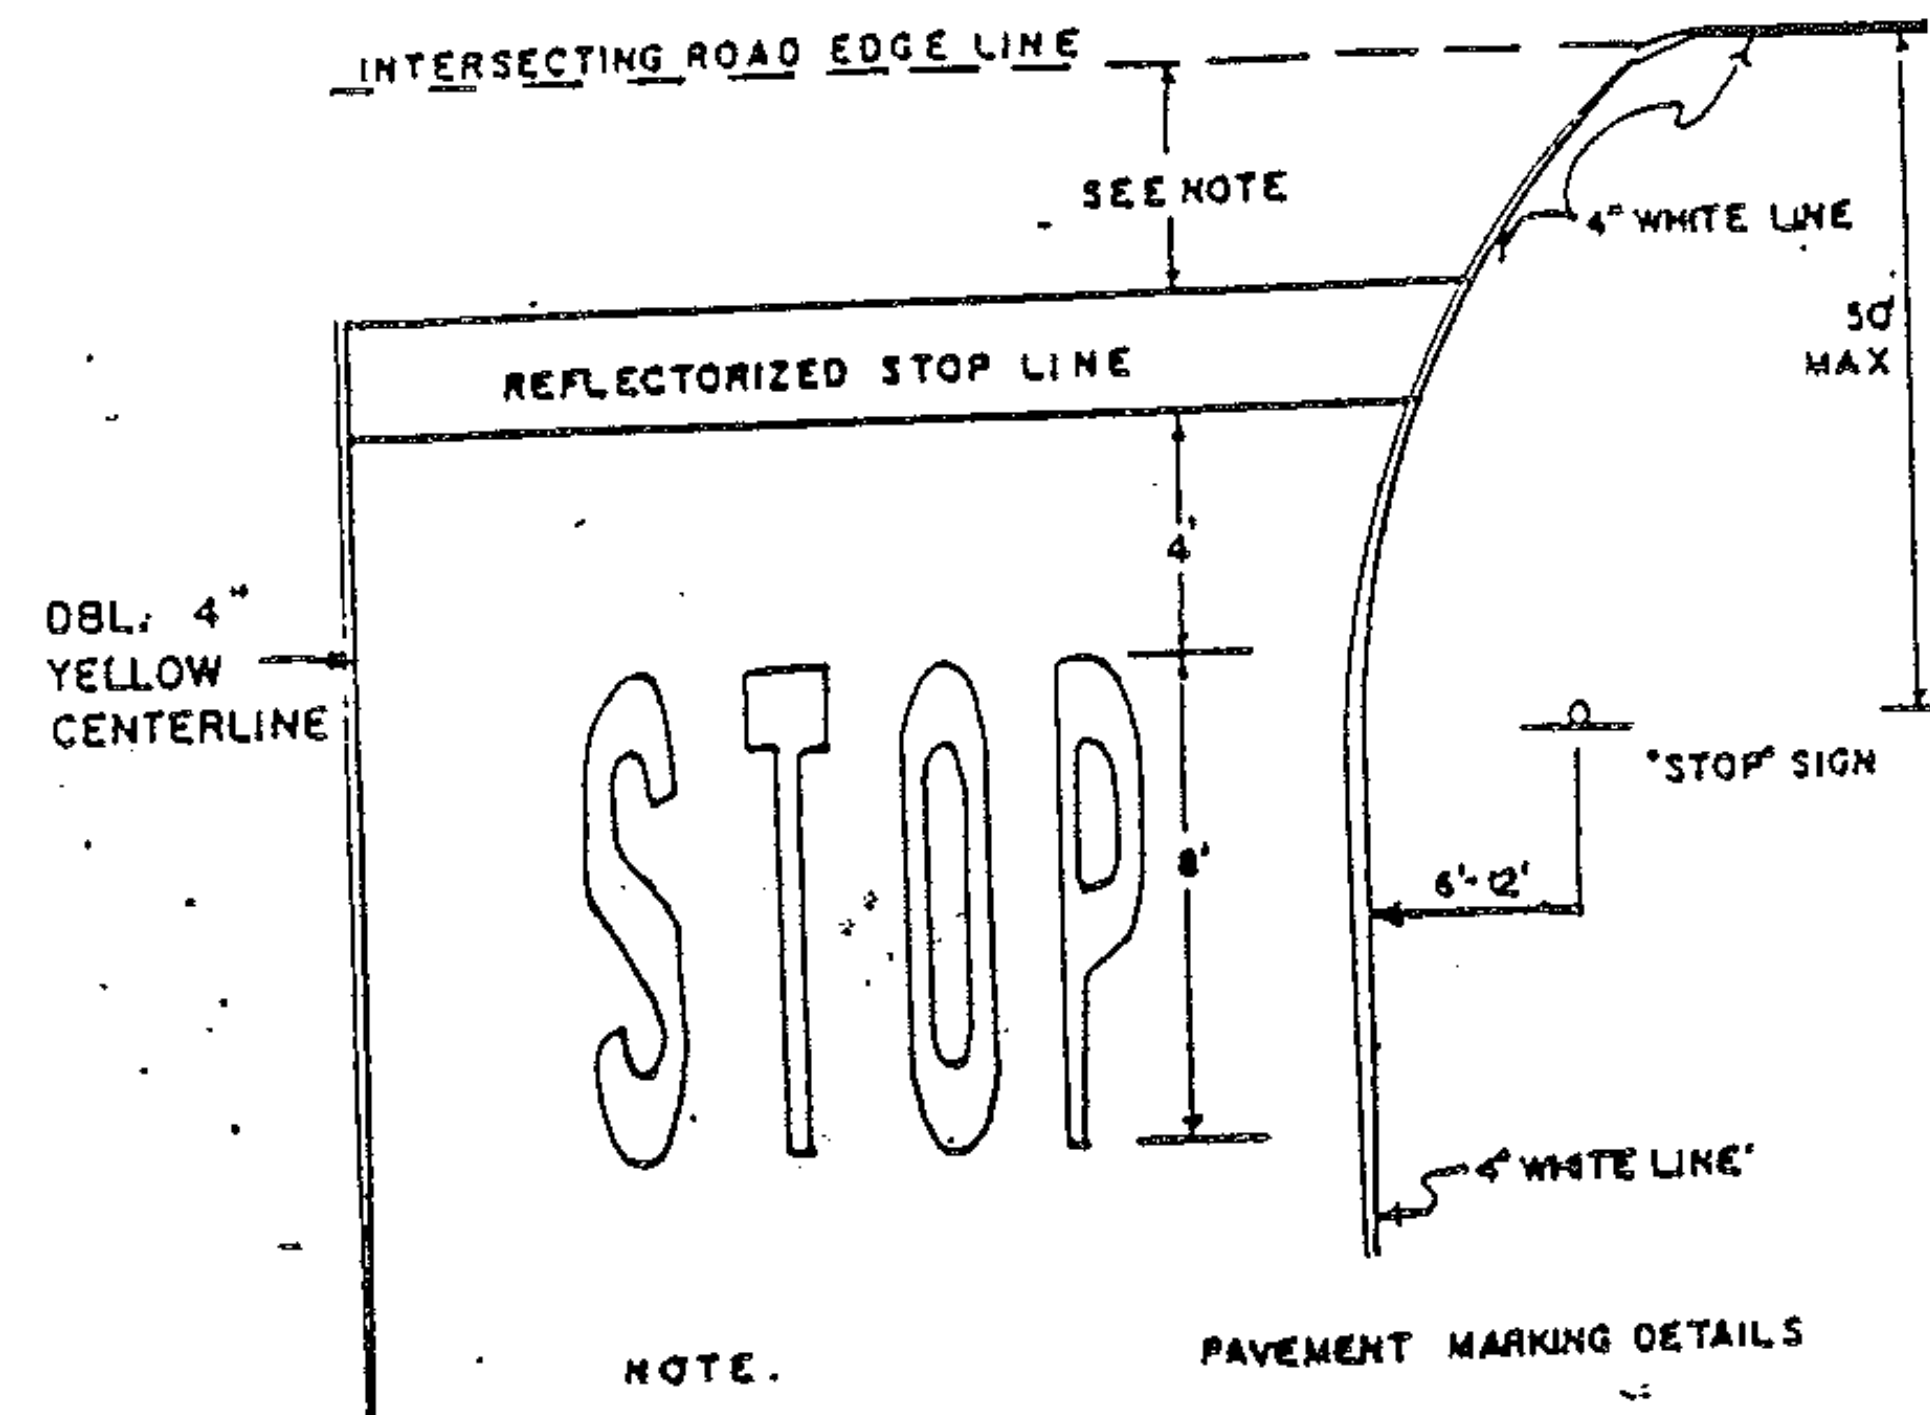

NOTE.
PAVEMENT MARKING DETAILS
1. THE STOP LINE SHOULD BE PLACED AT THE DESIRED STOPPING POINT. IN NO CASE MORE THAN 50 FEET OR LESS THAN 4' FROM THE NEAREST EDGE OF THE INTERSECTING ROADWAY, OR EDGE OF CROSSWALK.

AHEAD

NOTE:
SEE STANDARD E-50
FOR LETTERING DETAIL.

STOP

STOP AHEAD SIGN

PAWLET
No. HMA 2629
SHEET 12 OF 35 SHEETS