


PROJECT DESCRIPTION AND LOCATION

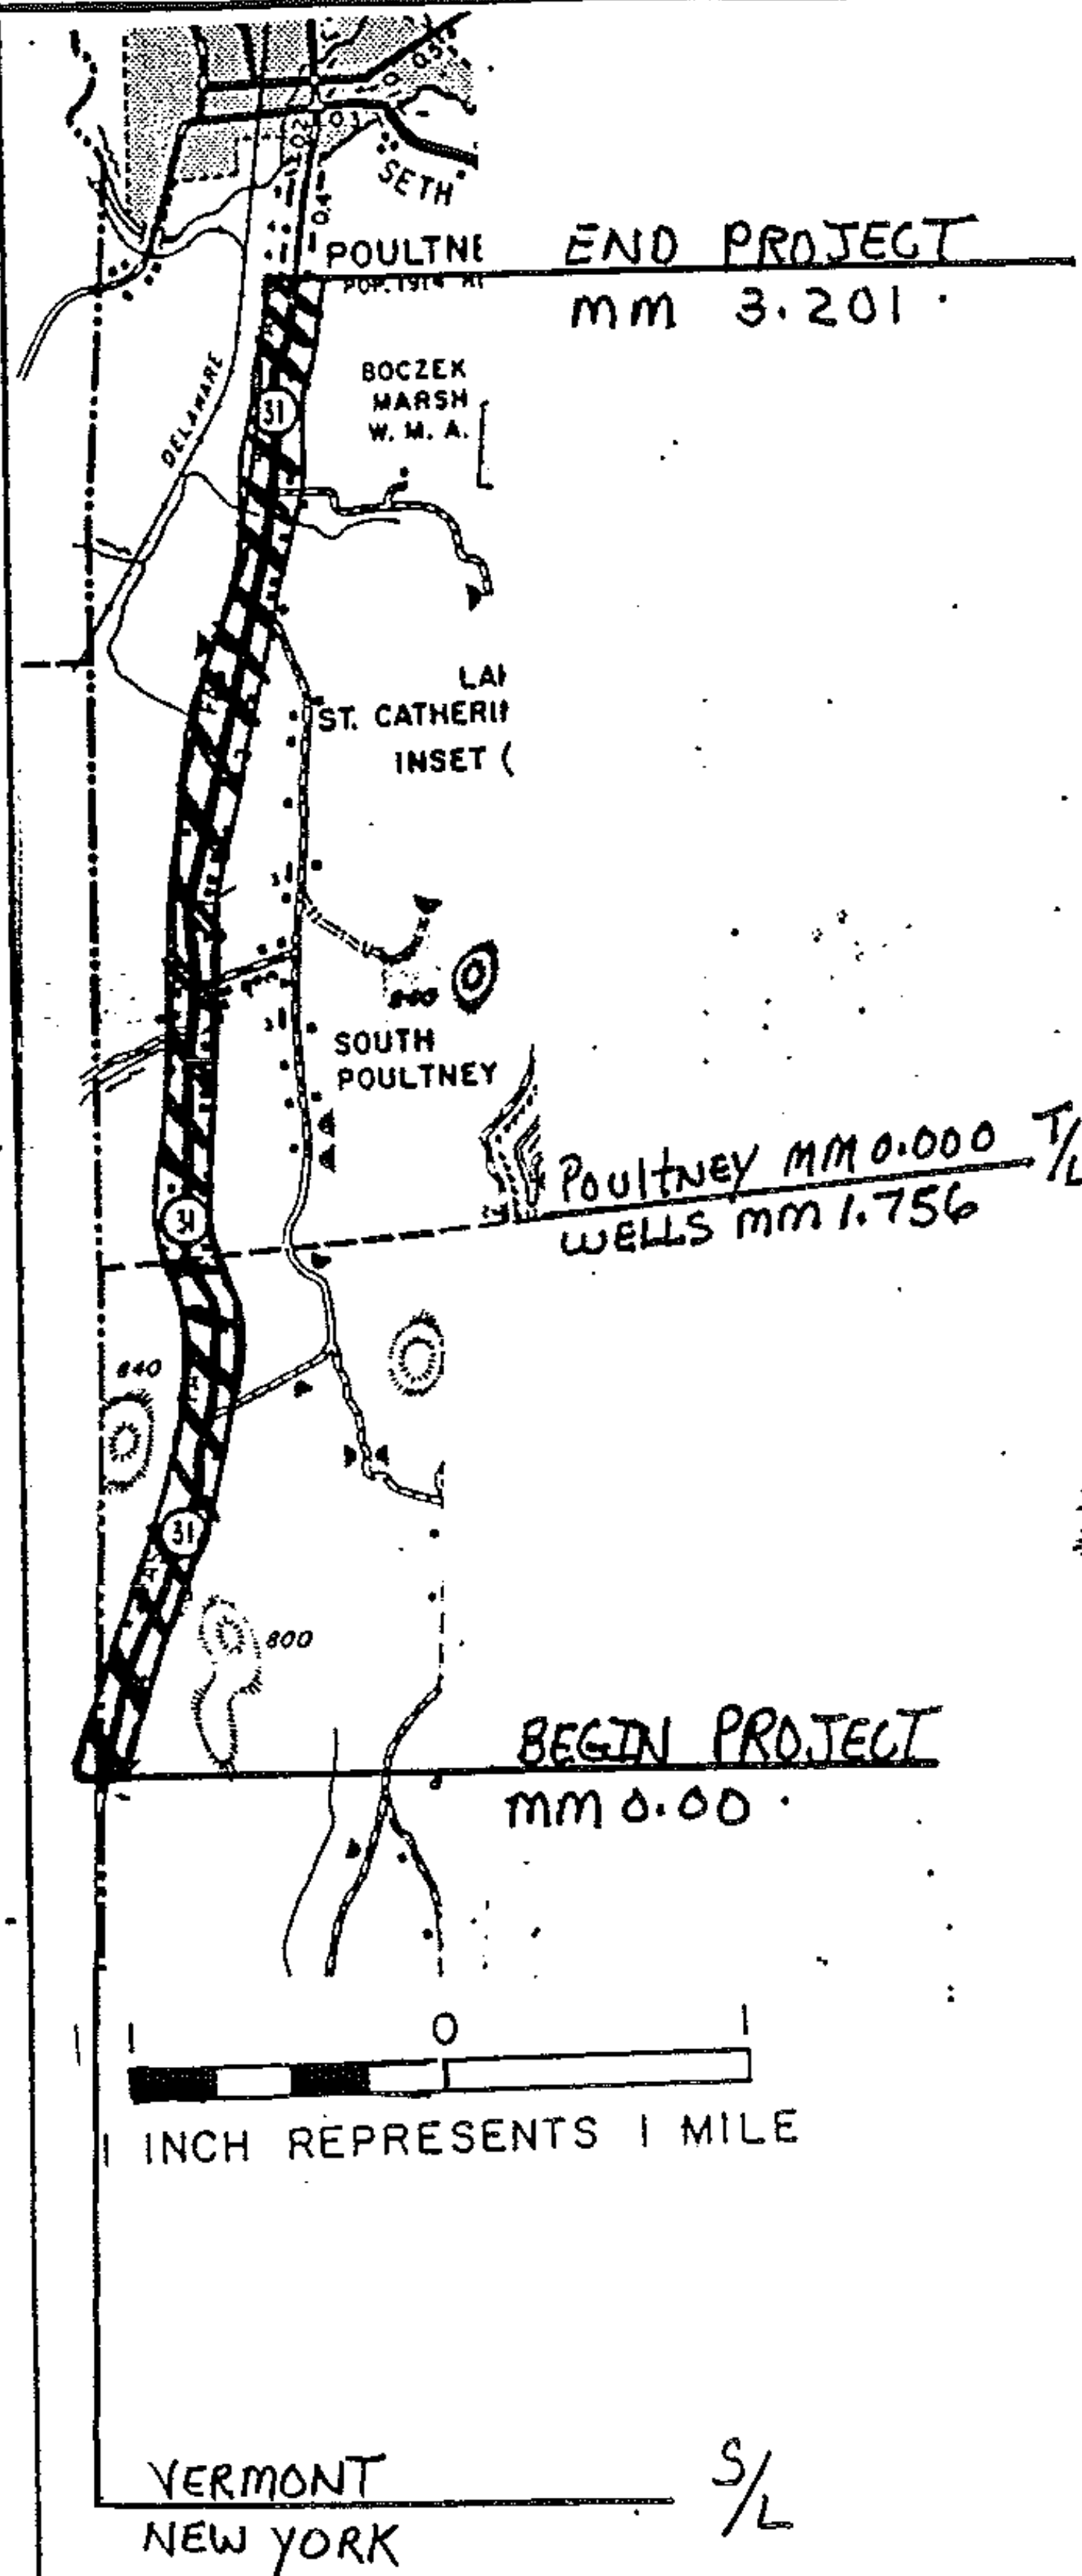

IN WELLS, BEGINNING AT A POINT
ON VT. 31 (MM 0.000) THE N.Y.-VT.
STATE LINE AND EXTENDING
NORTHERLY FOR 4.957 MILES TO
MM 3.201 IN THE TOWN OF
POULTNEY.

LENGTH OF PROJECT: 4.957 MILES
26,173 FEET

TRAFFIC DATA
1982 ADT 630
V = 50 mph