


TYPICAL SECTIONS & DESIGN DATA

ITEM 406.25 BITUMINOUS CONCRETE PAVEMENT
 LEVELING COURSE TYPE III OR IV (22' WIDE @ 150 TONS/mi)
 AS DIRECTED BY THE ENGINEER
 3/4" WEARING COURSE TYPE IV

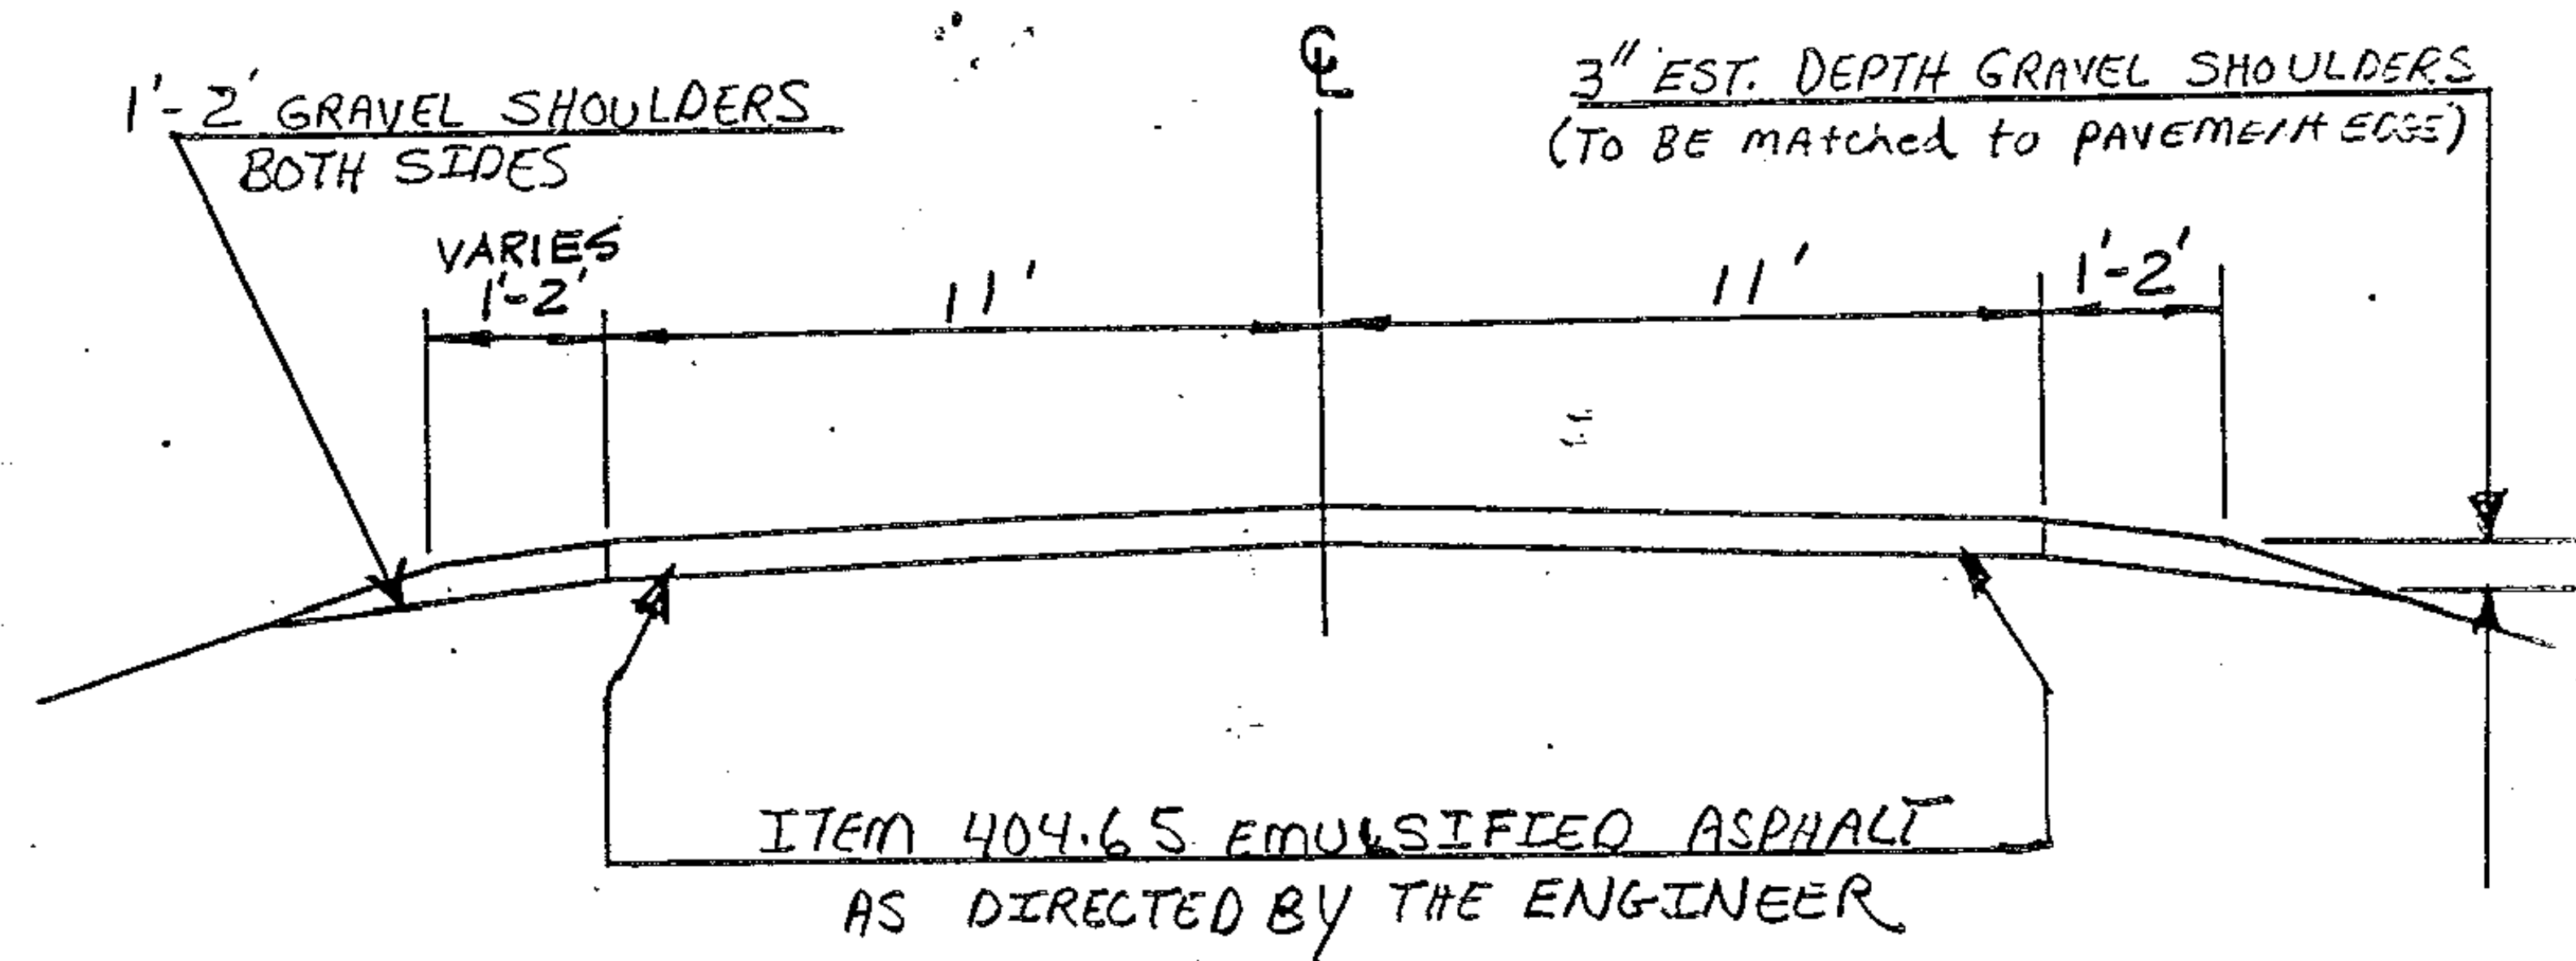

WELLS mm 0.000 ~ Poultney mm 3.201