


PROJECT DESCRIPTION AND LOCATION

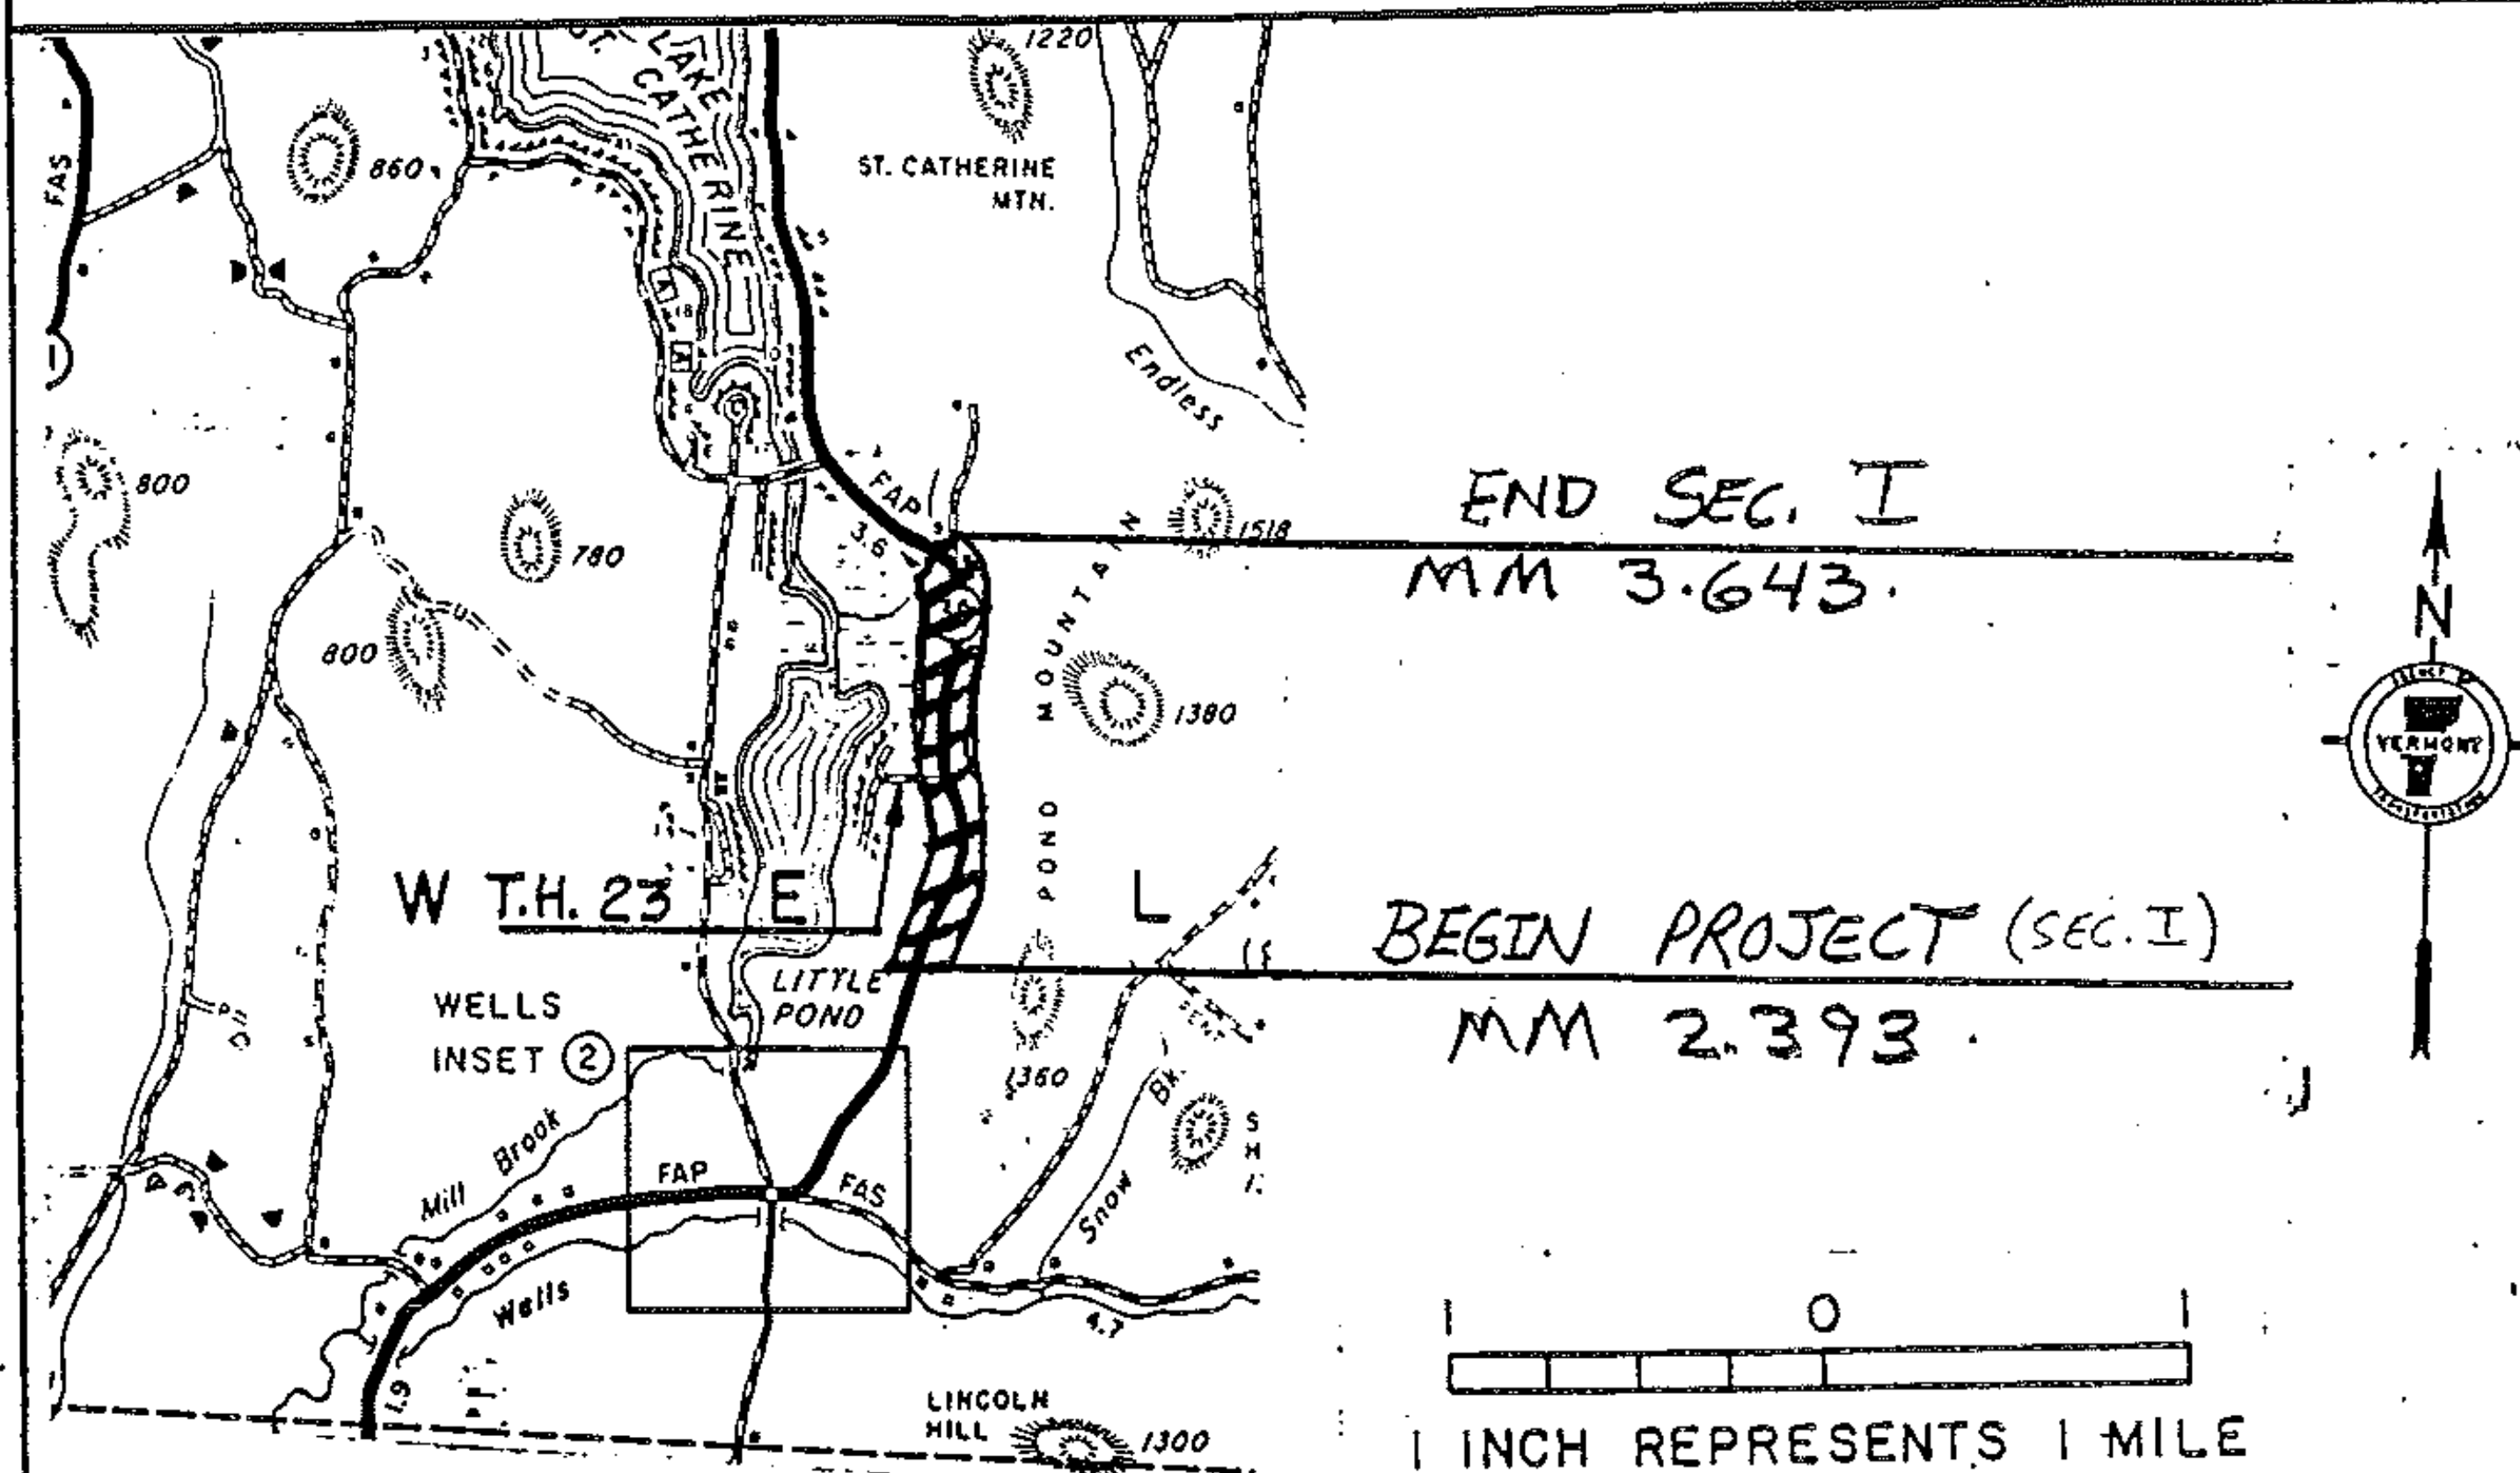

(SEC. I) IN WELLS, BEGINNING AT A POINT ON VT. 30 (MM 2.393) APPROXIMATELY 0.38 MILES SOUTH OF THE JCT. OF VT. 30 AND THE LITTLE LAKE EAST ROAD (TH 23) AND EXTENDING NORTHERLY 1.250 MILES SOUTH OF THE JCT. OF VT. 30 AND TH. 3.

TRAFFIC DATA
1982 ADT 800
V = 50 MPH

LENGTH OF SEC. I : 1.250 miles
6600 feet

PROJECT WELLS - POULTNEY - CASTLETON

NO. HMA 2628

SHEET 17 OF 35 SHEETS