


PROJECT DESCRIPTION AND LOCATION

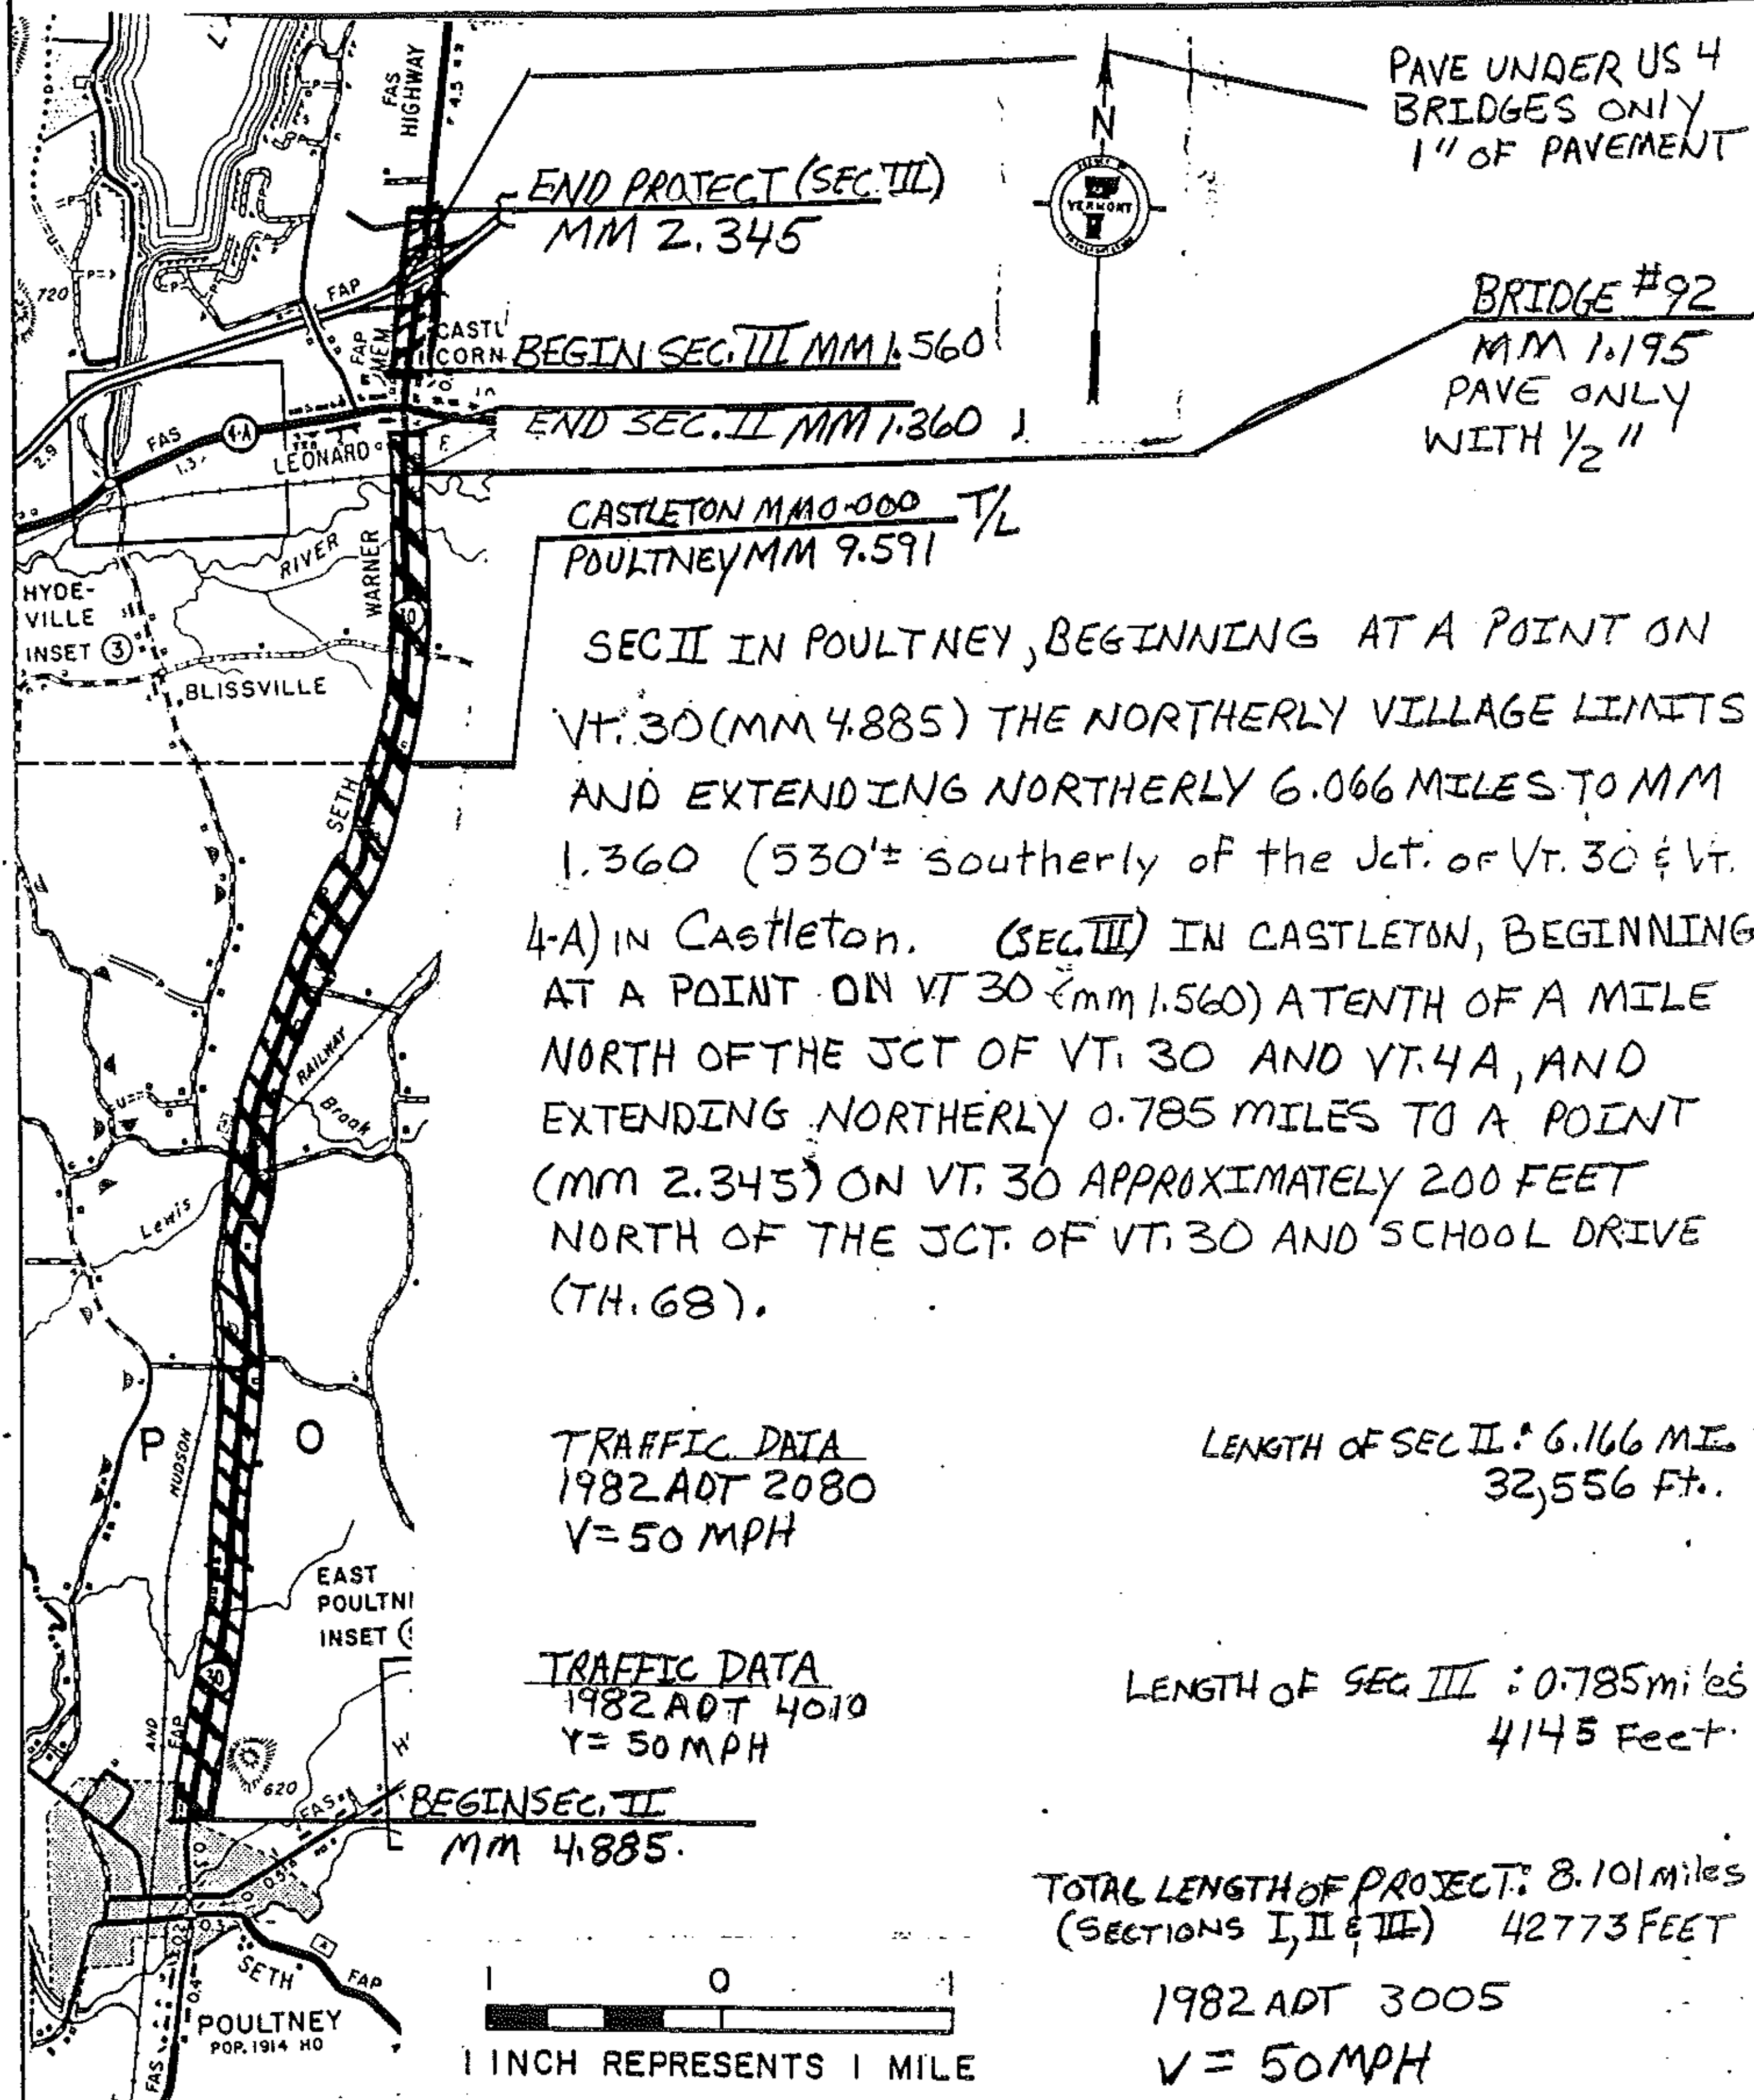

NO. HMA 2628

SHEET 12 OF 35 SHEETS

PROJECT WELLS - POULTNEY - CASTLETON