


TYPICAL SECTIONS & DESIGN DATA

ITEM 406.25 BITUMINOUS CONCRETE PAVEMENT
LEVELING COURSE TYPE III OR IV (SEE TABLE BELOW)
AS DIRECTED BY THE ENGINEER
3/4" WEARING COURSE TYPE IV

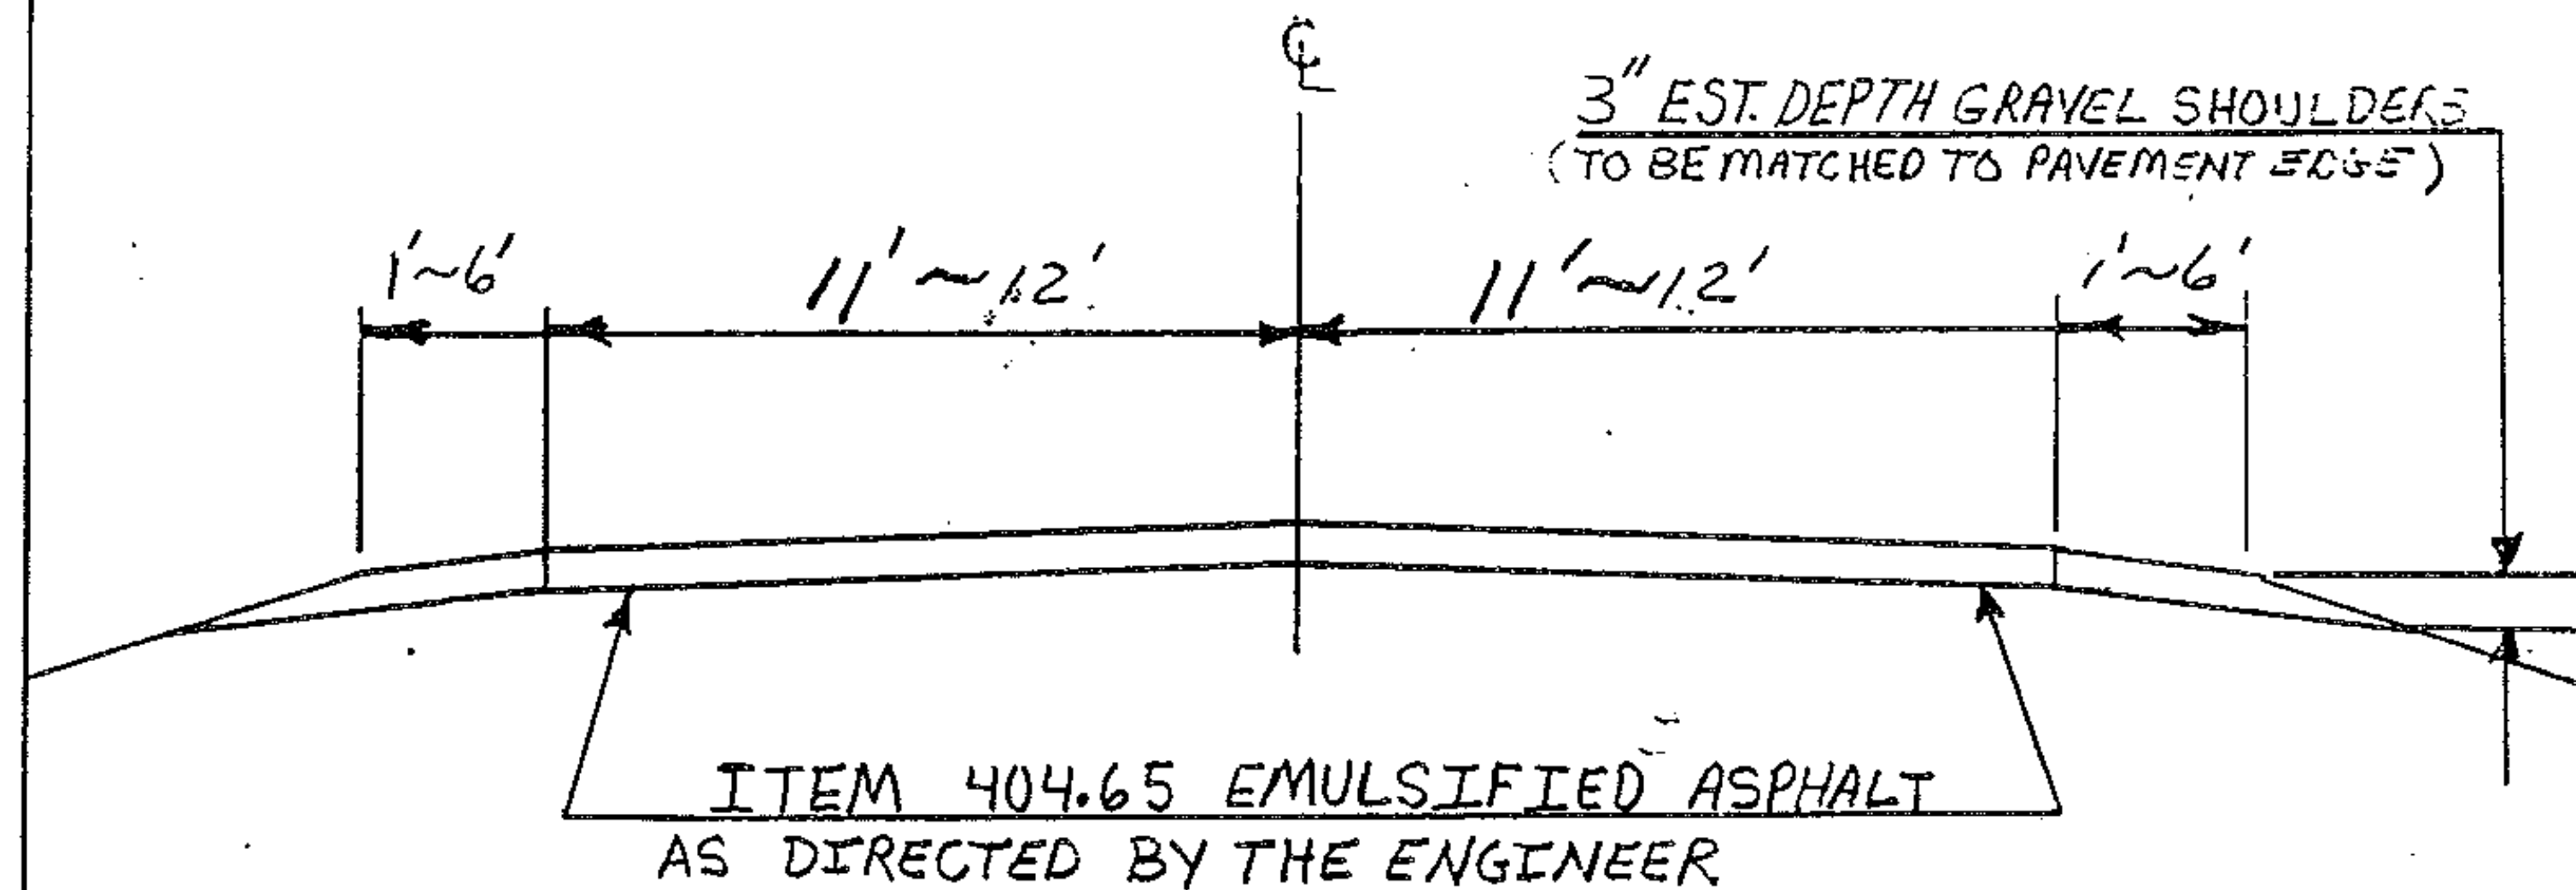

DISTANCE	WIDTH OF SHOULDER	WIDTH OF TRAVELED-WAY	WIDTH OF SHOULDER	LEVEL @ TONNAGE / MILE
WELLS mm 2.393 to mm 3.643	1' PAVED	22'	1' PAVED	250 TONS/mile
POULTNEY mm 4.885 to mm 6.855	1' GRAVEL	24'	1' GRAVEL	200 TONS/mile
POULTNEY mm 6.855 to mm 7.100	6' GRAVEL	24'	6' GRAVEL	218 TONS/mile
POULTNEY mm 7.100 to mm 7.446	1' GRAVEL	24'	1' GRAVEL	218 TONS/mile
POULTNEY mm 7.446 to mm 9.591	1' GRAVEL	22'	1' GRAVEL	200 TONS/mile
CASTLETON mm 0.000 to mm 1.360	1' GRAVEL	24'	1' GRAVEL	272 TONS/mile
* CASTLETON mm 1.560 to mm 1.862	1' GRAVEL	24'	1' GRAVEL	164 TONS/mile

*NOTE: CASTLETON mm 1.560 to mm 1.862 HAS 1 1/4" WEARING COURSE TYPE III