


# STOP BAR DETAILS

13.

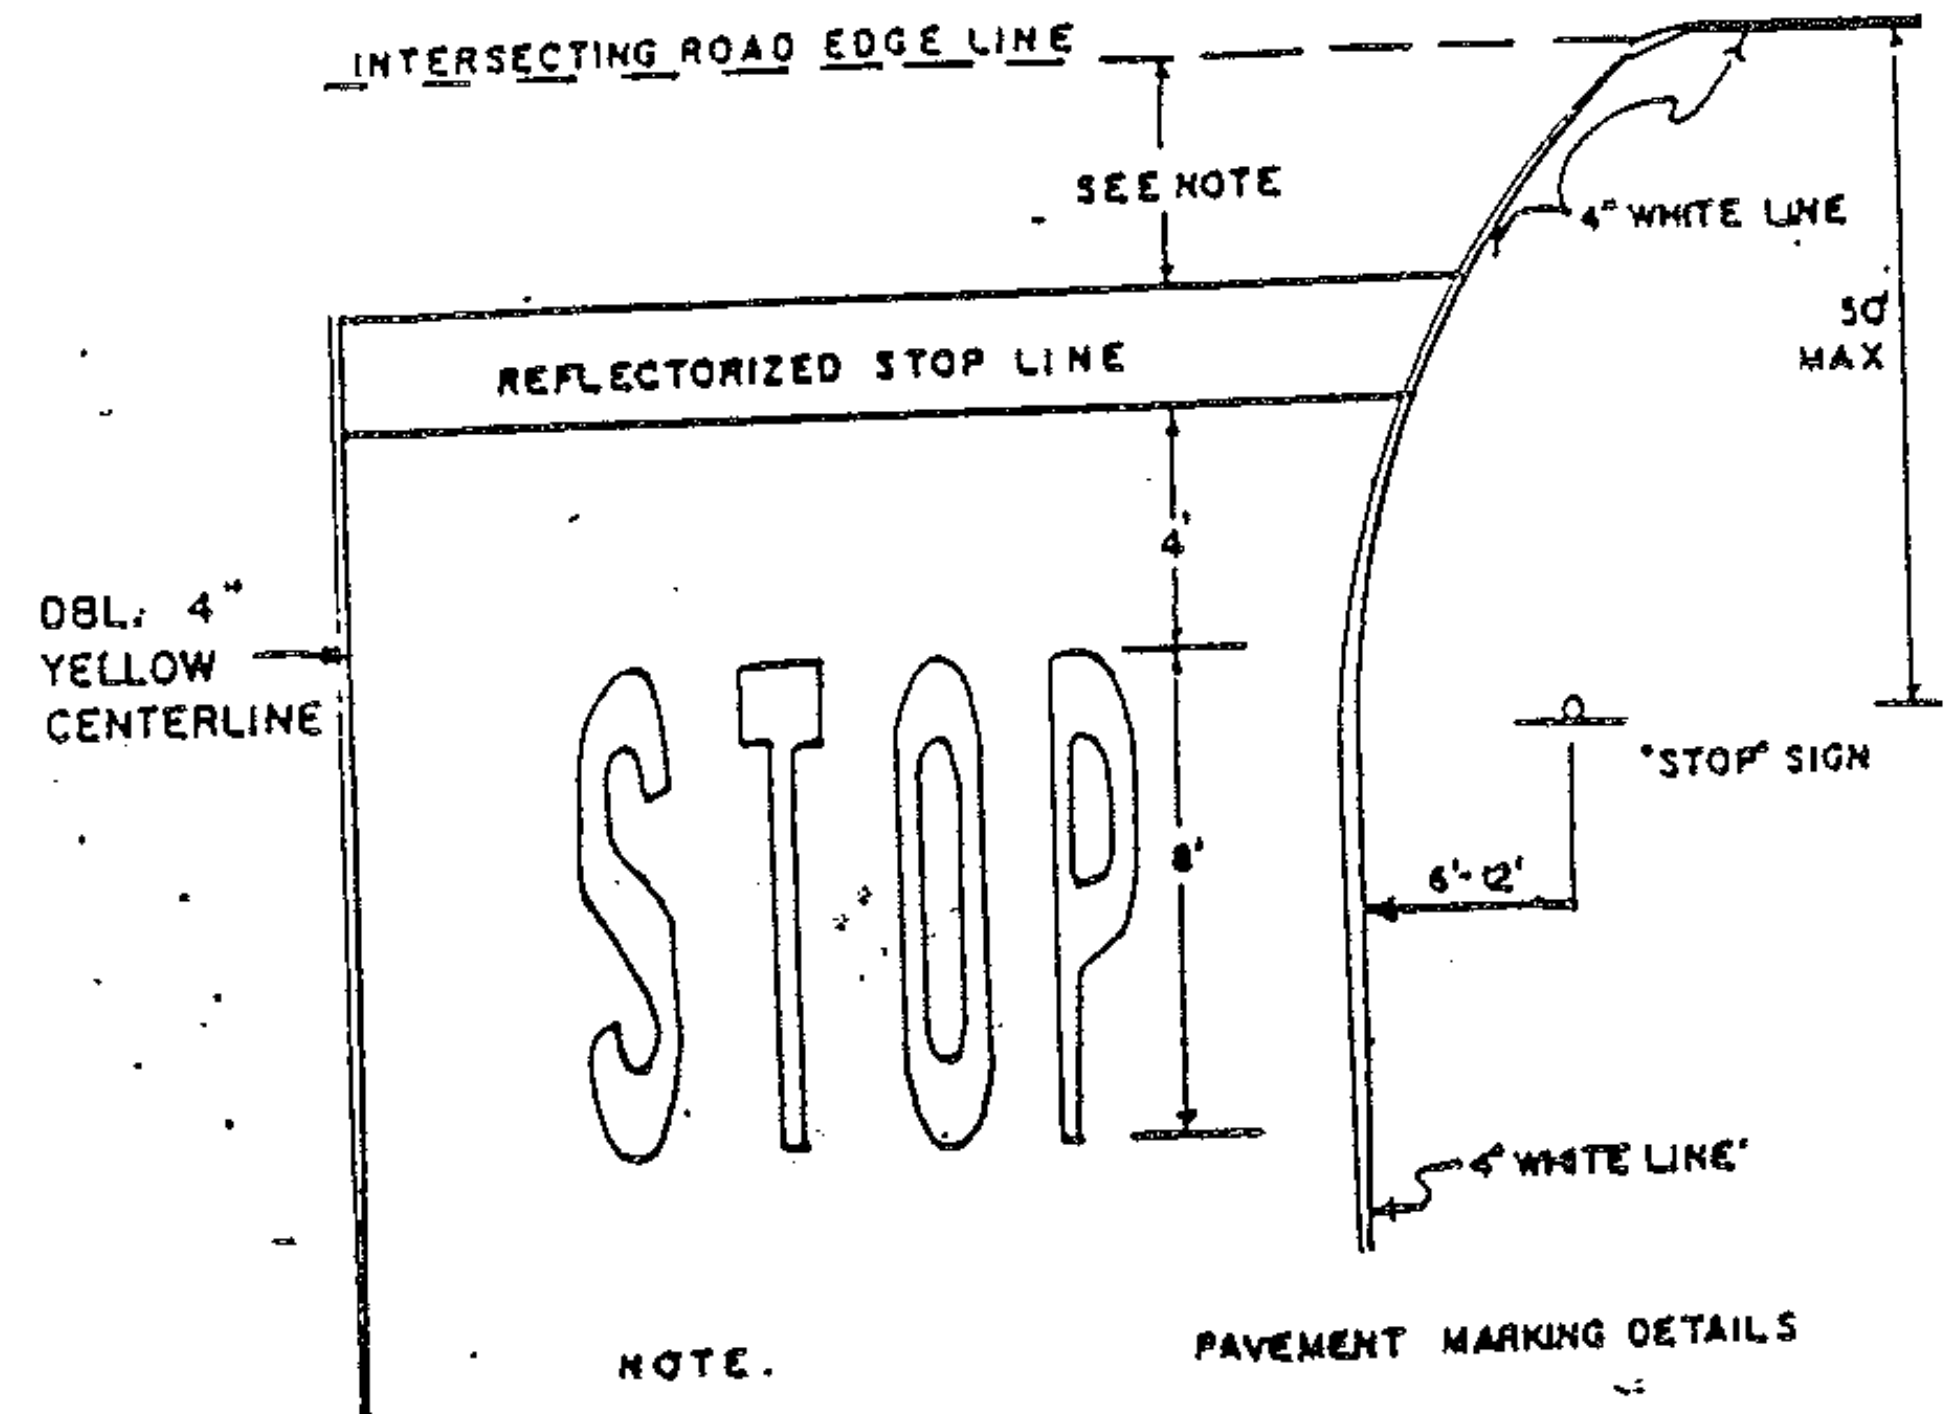

NOTE.  
PAVEMENT MARKING DETAILS

1. THE STOP LINE SHOULD BE PLACED AT THE DESIRED STOPPING POINT. IN NO CASE MORE THAN 50 FEET OR LESS THAN 4' FROM THE NEAREST EDGE OF THE INTERSECTING ROADWAY, OR EDGE OF CROSSWAIR.

AHEAD

NOTE:  
SEE STANDARD E-50  
FOR LETTERING DETAIL.

8'  
16'  
16'  
8'

STOP AHEAD SIGN

STOP

PAWLET  
No. HMA 2629  
SHEET 12 OF 35 SHEETS