


PROJECT DESCRIPTION AND LOCATION

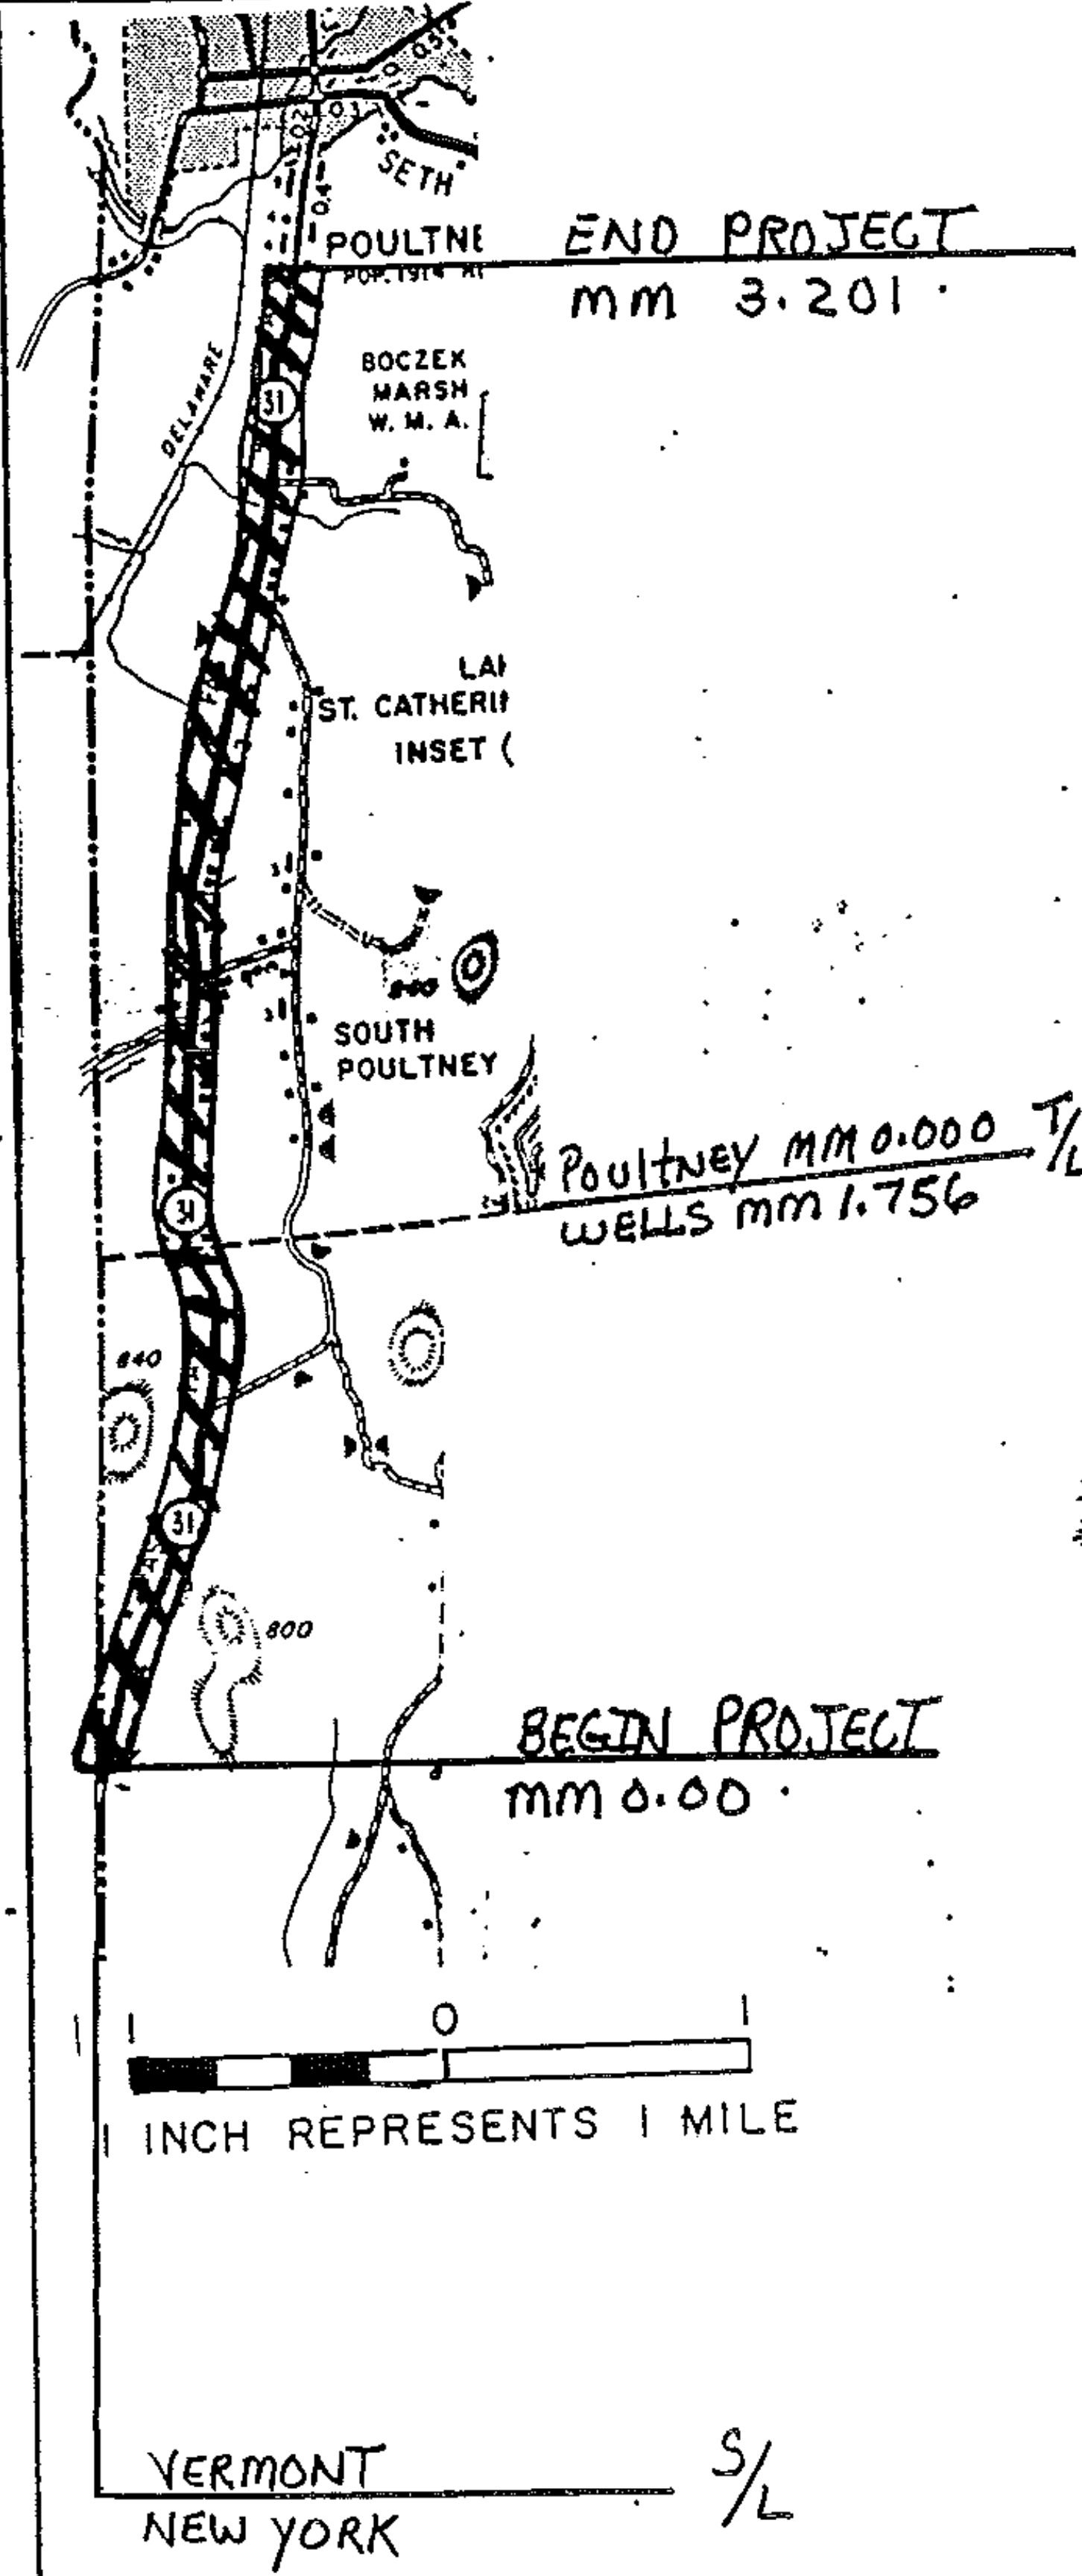

IN WELLS, BEGINNING AT A POINT ON VT. 31 (MM 0.000) THE N.Y.-VT. STATE LINE AND EXTENDING NORTHERLY FOR 4.957 MILES TO MM 3.201 IN THE TOWN OF POULTNEY.

LENGTH OF PROJECT: 4.957 MILES
26,173 FEET

TRAFFIC DATA
1982 ADT 630
V = 50 mph

1 INCH REPRESENTS 1 MILE

VERMONT S/L
NEW YORK