


# PROJECT DESCRIPTION AND LOCATION

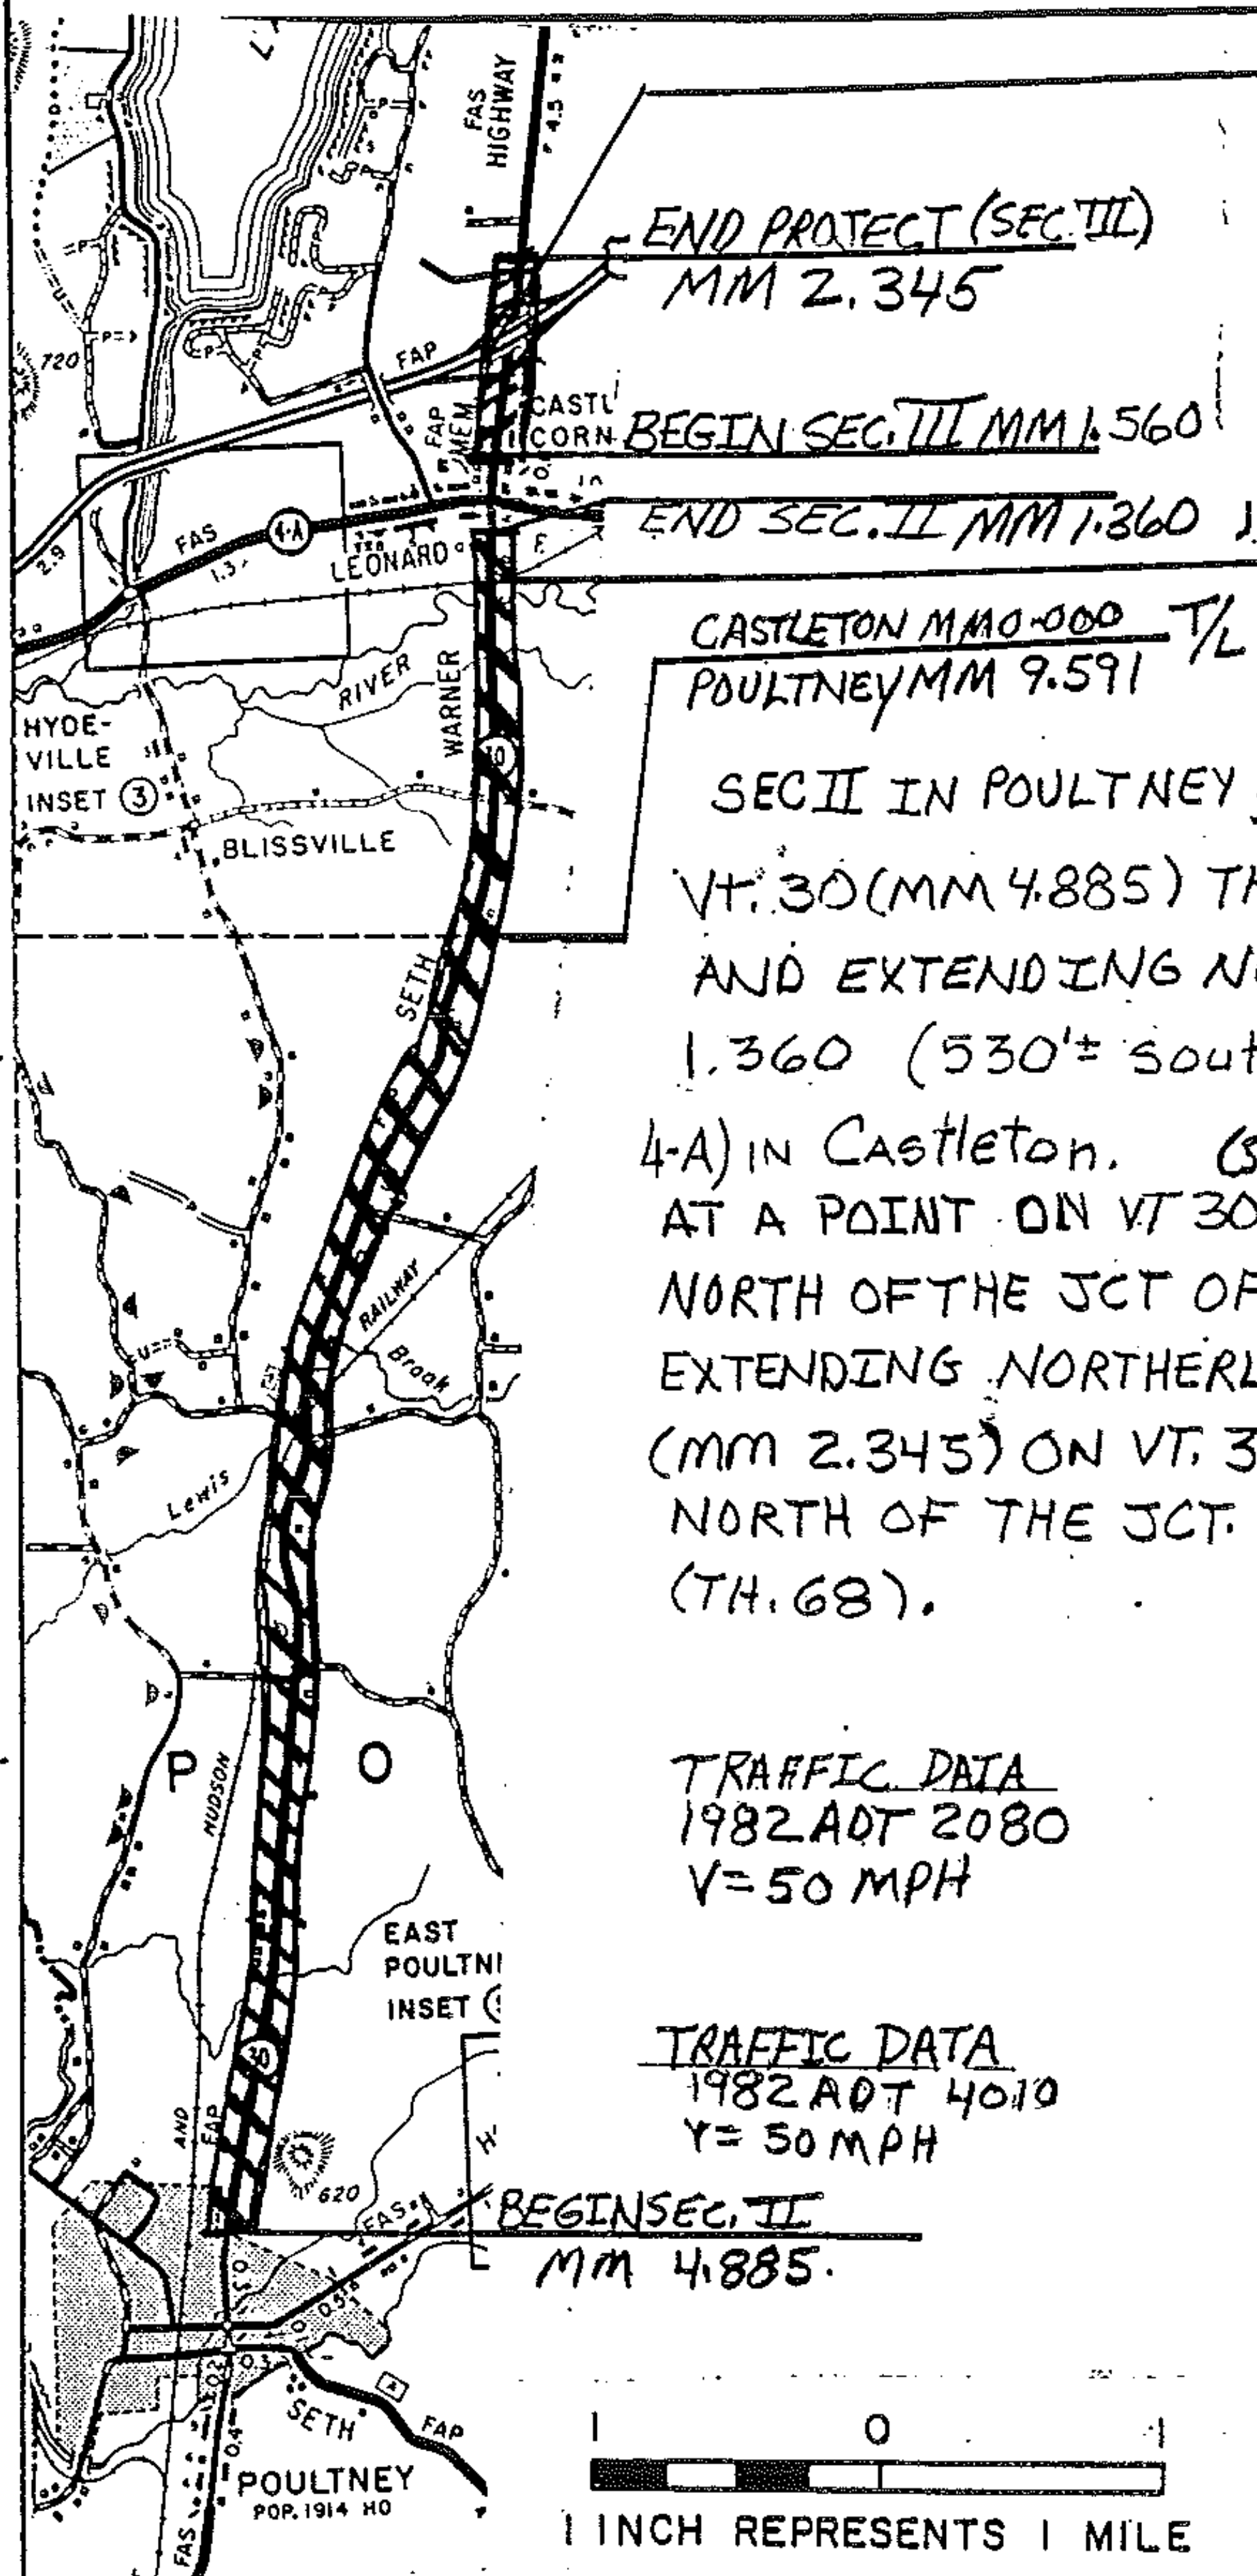

PAVE UNDER US 4  
BRIDGES ONLY  
1" OF PAVEMENT

END PROTECT (SEC. III)  
MM 2.345

BEGIN SEC. III MM 1.560

END SEC. II MM 1.360

BRIDGE #92

MM 1.195  
PAVE ONLY  
WITH 1/2"

CASTLETON MM 0.000 T/L  
POULTNEY MM 9.591

SEC II IN POULTNEY, BEGINNING AT A POINT ON VT. 30 (MM 4.885) THE NORTHERLY VILLAGE LIMITS AND EXTENDING NORTHERLY 6.066 MILES TO MM 1.360 (530'± southerly of the Jct. of Vt. 30 & Vt. 4-A) IN CASTLETON. (SEC III) IN CASTLETON, BEGINNING AT A POINT ON VT 30 (MM 1.560) A TENTH OF A MILE NORTH OF THE JCT OF VT. 30 AND VT. 4A, AND EXTENDING NORTHERLY 0.785 MILES TO A POINT (MM 2.345) ON VT. 30 APPROXIMATELY 200 FEET NORTH OF THE JCT. OF VT. 30 AND SCHOOL DRIVE (TH. 68).

TRAFFIC DATA  
1982 ADT 2080  
V = 50 MPH

LENGTH OF SEC II: 6.166 MI.  
32,556 Ft.

TRAFFIC DATA  
1982 ADT 4010  
V = 50 MPH

LENGTH OF SEC III: 0.785 miles  
4145 Feet

BEGIN SEC. II  
MM 4.885

TOTAL LENGTH OF PROJECT: 8.101 miles  
(SECTIONS I, II & III) 42773 FEET

1982 ADT 3005  
V = 50 MPH

1 INCH REPRESENTS 1 MILE

NO. HMA 2628

PROJECT WELLS - POULTNEY - CASTLETON

SHEET 12 OF 35 SHEETS