


# TYPICAL SECTIONS & DESIGN DATA

ITEM 406.25 BITUMINOUS CONCRETE PAVEMENT  
 LEVELING COURSE TYPE III OR IV (SEE TABLE BELOW)  
 AS DIRECTED BY THE ENGINEER  
 1 1/4" WEARING COURSE TYPE III

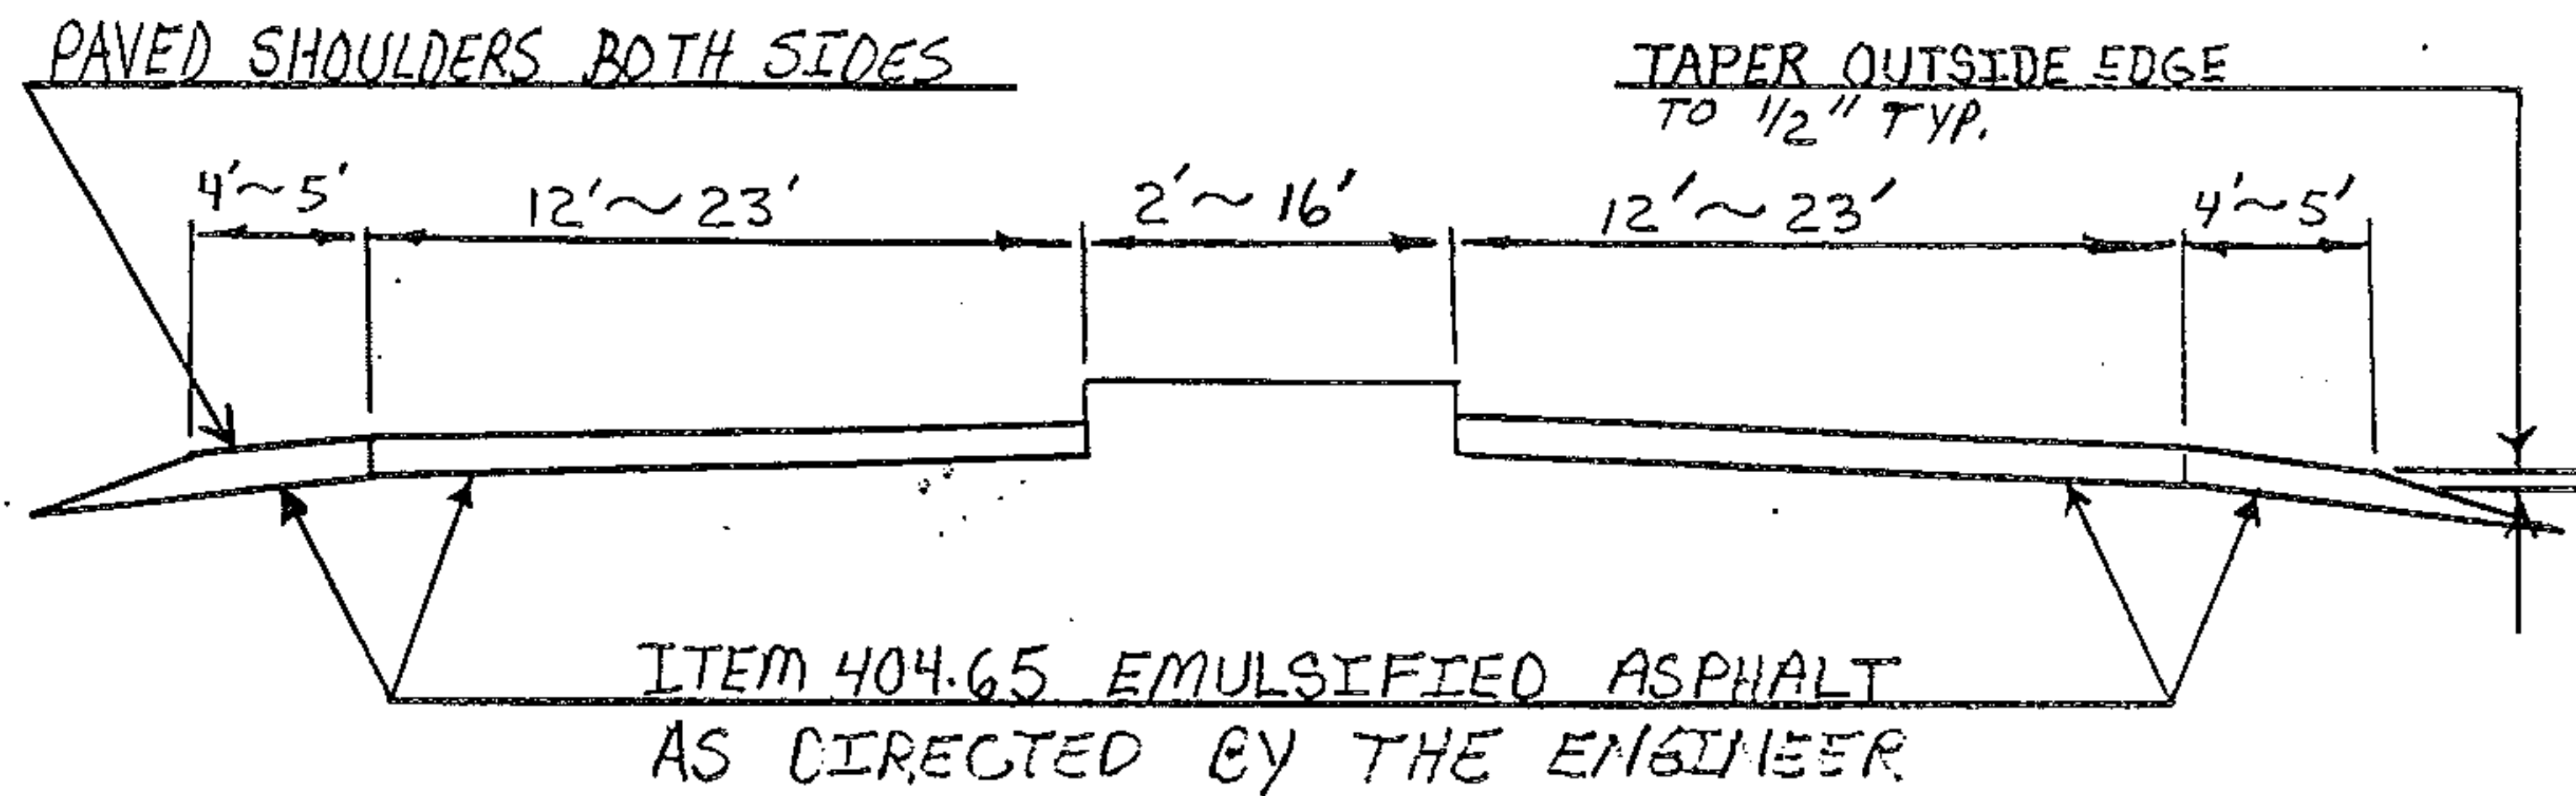

DISTANCE	WIDTH OF SHOULDER	WIDTH OF TRAVELED-WAY	WIDTH OF SHOULDER	LEVEL @ TONNAGE / MILE
mm 1.862 to CASTLETON mm 1.975	4' PAVED	38'	4' PAVED	259 TONS/mile
MM 1.975 to CASTLETON mm 2.188	5' PAVED	46'	5' PAVED	314 TONS/mile
mm 2.188 to CASTLETON mm 2.345	4' PAVED	24'	4' PAVED	164 TONS/mile

PROJECT WELLS-POULTNEY-CASTLETON

NO. HMA 2629

SHEET 20 OF 35 SHEETS