


# PROJECT DESCRIPTION AND LOCATION

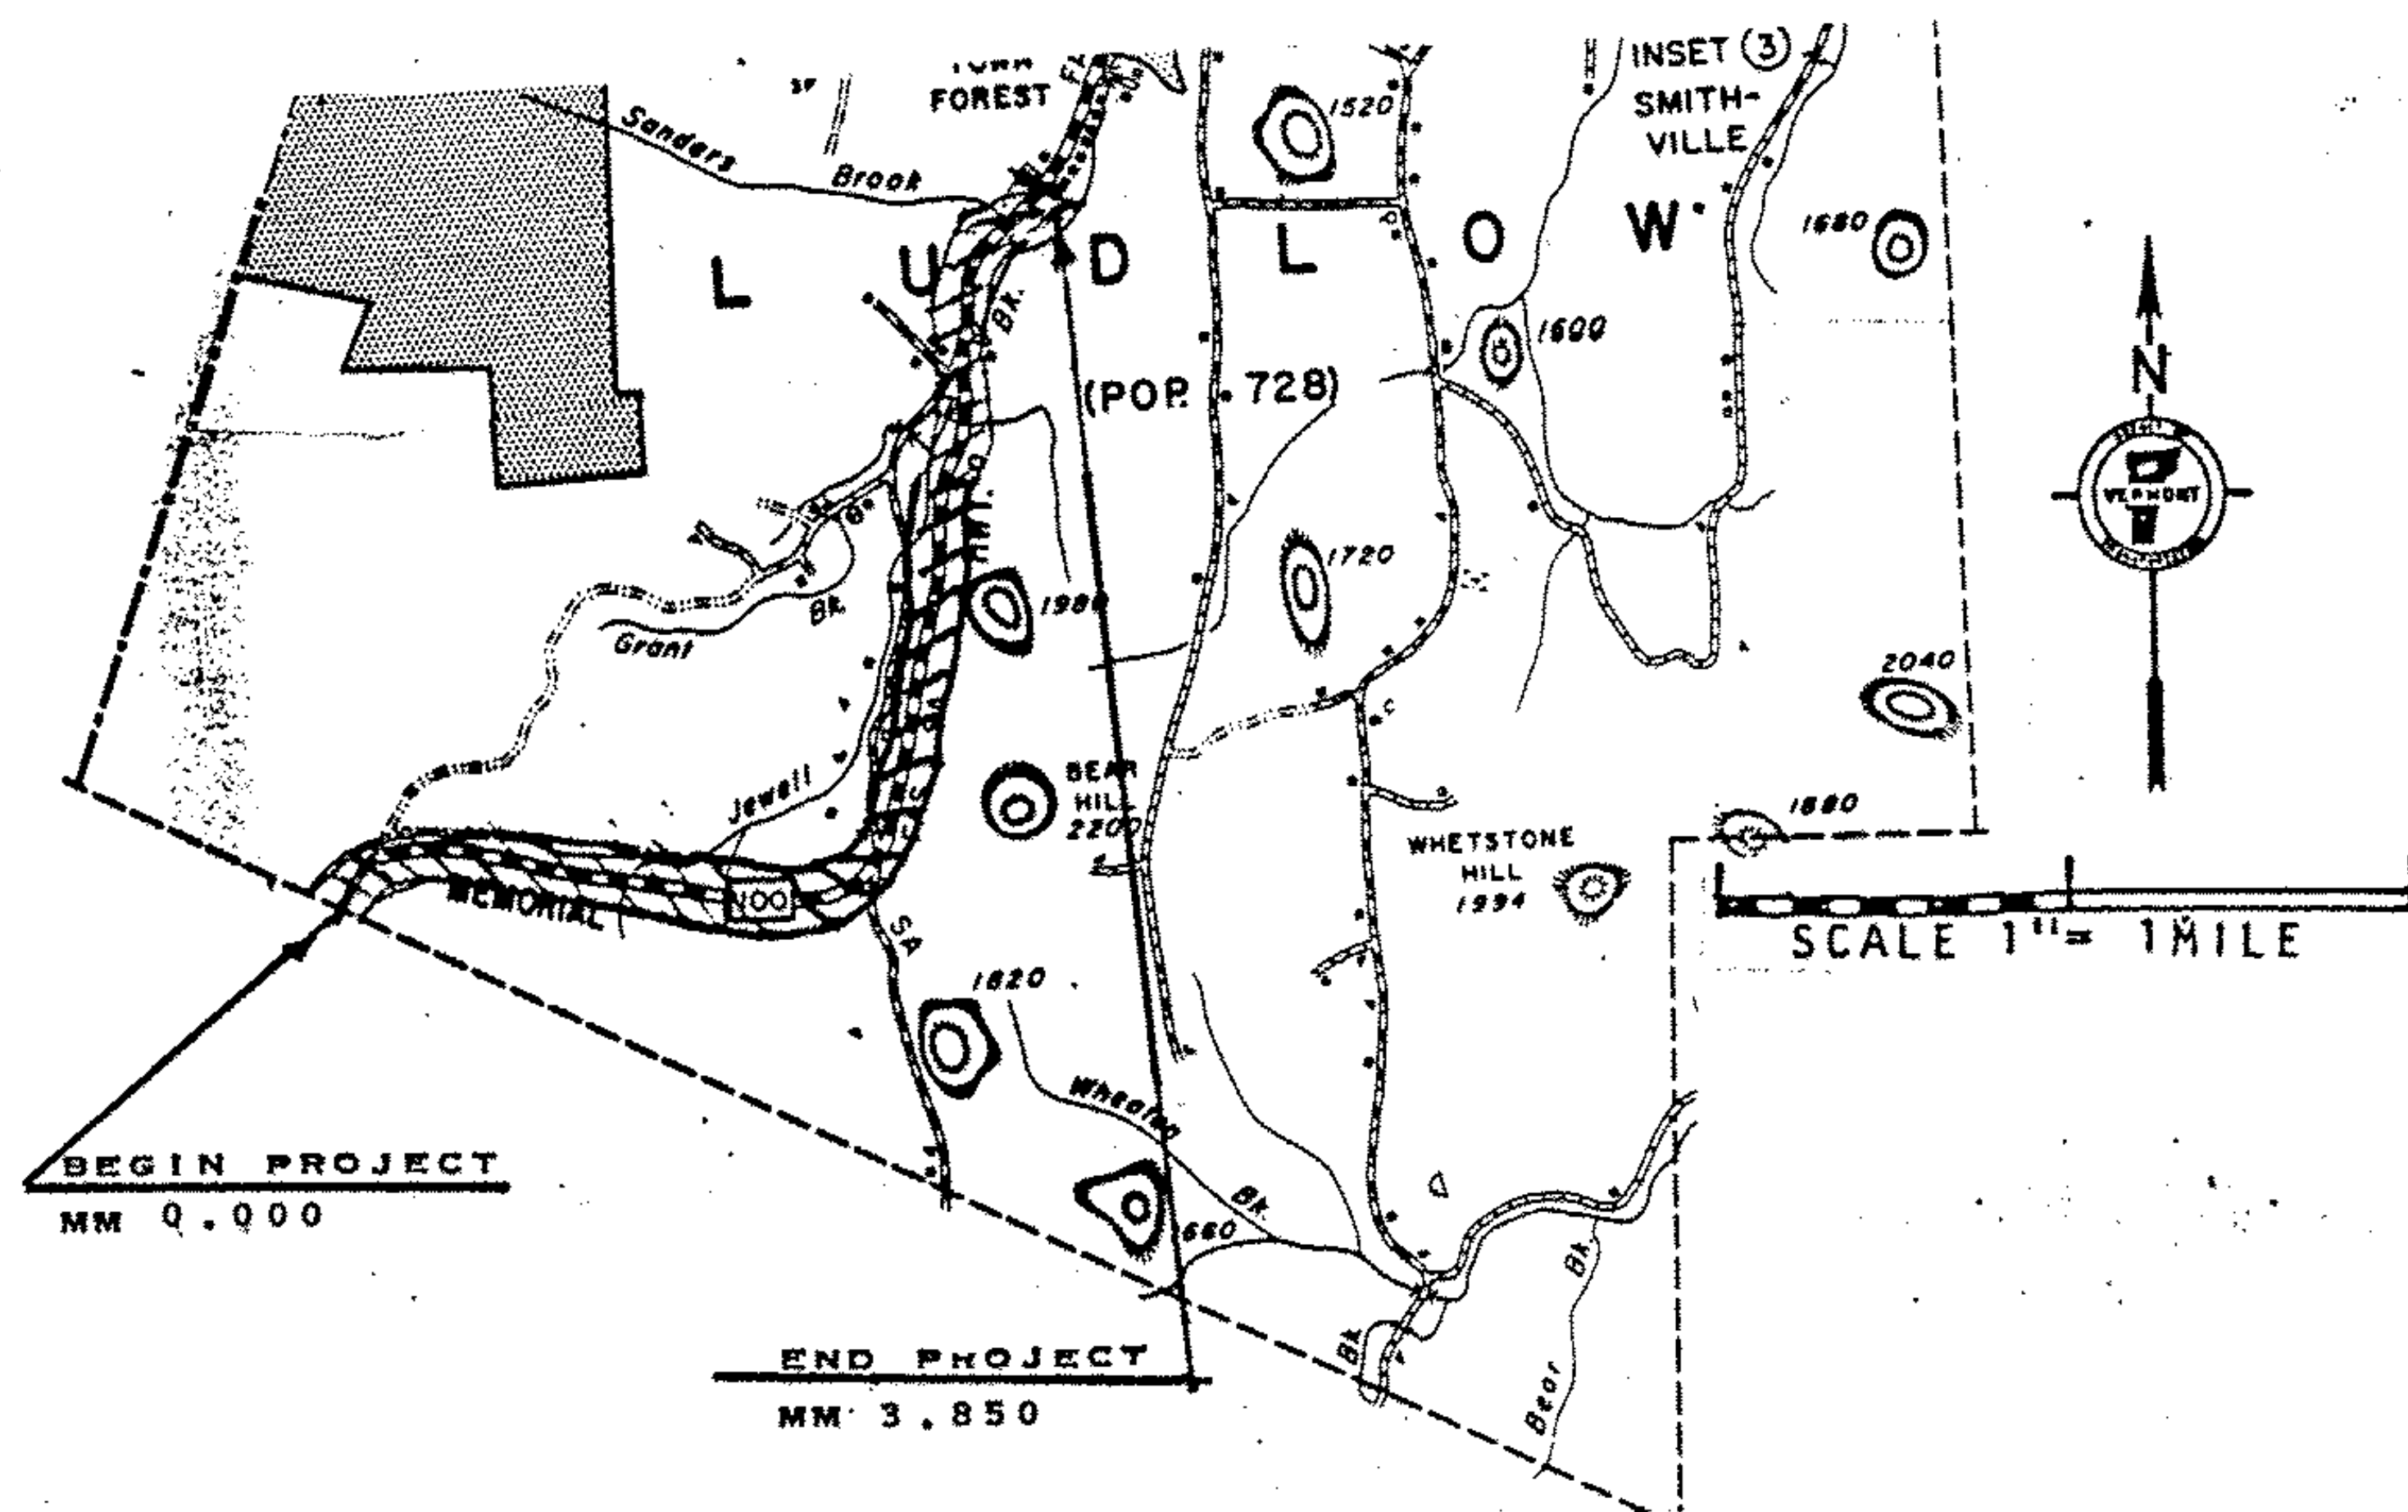

ON VT 100, BEGINNING IN THE TOWN OF LUDLOW AT MM 0.000 AND  
EXTENDING 3.850 MILES TO MM 3.850.

LENGTH OF PROJECT  
3.850 MILES  
20328 FEET

PROJECT LUDLOW

NO. HMA 2630  
SHEET 4 OF 24 SHEETS